



OPERATION PERMIT

Franklin County Health Department
107 Industrial Drive
Louisburg, NC 27549
Phone:

For Office Use Only

*CDP File Number 372593 - 1

County ID Number: 2272

Evaluated For: NEW

Property Owner: ROGER PATTERSON
Owner Address: 95 RIVER ROCK WAY

City: FRANKLINTON
State/Zip: / 27525
Phone #:
Address: 127 MOHAWK DR
, NC
Road #:
Township:
Subdivision: LAKE ROYALE
Phase : NEW Lot:

Structure: SINGLE FAMILY
of Bedrooms: 3
of People: 3

Water Supply: COMMUNITY

Saprolite System?: ☐ Yes ☒ No

Pump Required?: ☐ Yes ☒ No

Design Flow: 360

System Classification/Description: TYPE II A. CONV SYSTEM
(SINGLE-FAMILY OR 480 GPD OR LESS)

Installer: DB+Sons

Certification #:

Specific System EZFLOW EZ 1203H-GEO

Installed:

Septic Tank Date: 03/02/2023

STB:

Pump Tank Date: _____

PT:

Comments:

This system has been installed in compliance with applicable NC General Statutes, Rules for Sewage Treatment and Disposal, and all conditions of the Improvement Permit and Construction Authorization.

PERMIT CONDITIONS:

- I. Performance: System shall perform in accordance with Rule .1961.
- II. Monitoring: As required by Rule .1961.
- III. Maintenance: Ground absorption sewage treatment and disposal systems shall be checked, and the contents of the septic tank removed, periodically from all compartments, to ensure proper operation of the system. The contents shall be pumped whenever the solids level is found to be more than 1/3 of the liquid depth in any compartment.

Other:

Subsurface Operator Required: ☐ Yes ☒ No

If yes, see attached sheet for additional operation conditions, maintenance and reporting.

Operation:

Other:

Authorized State Agent: Leonard, Shad

Date of Issue: 05/03/2023

Owner/Applicant: _____



File # 372593 PIN#

Property Address: 127 Mohawk Dr.

Applicant or Owner Name: Brandon Wiggins

Environmental Health Septic/Well Permit Diagram

Building permits cannot be issued nor should construction begin without Construction Authorization issuance.

☒ Septic Improvement Permit ☒ Septic Construction Authorization (CA) ☐ CA Reissue** ☒ As Built
☐ Well Construction Authorization ☐ Additional Diagram/Specifications Attached

Diagram Date**: 5-25-22 EHS: Joel Bendel


**Any previously dated CA diagram is revoked and/or invalid. Confirm this is the valid diagram for the site before beginning any construction.

Installation/grouting inspections may be scheduled the day before, or, the day of installation until 9am by contacting the Environmental Health office at 919 496 8100. A revisit fee may apply if installation is not ready for inspection at the time requested. Septic Operations Permits will be issued after installation is approved, all permit conditions are met, and any outstanding fees are paid. Well Certificate of Completion will be issued after well head approval, all permit conditions are met, and any outstanding fees are paid.

Septic Tank 1000 Pump Tank N/A Drainfield 3'x300' Type System Acc Max Trench Depth 24"

Septic Contractor DB + Sons Septic/Pump tank dates DB 1000 3/2/22 Pump fee? ☒ YES pd

Well Contractor _____ Well Grout date: _____

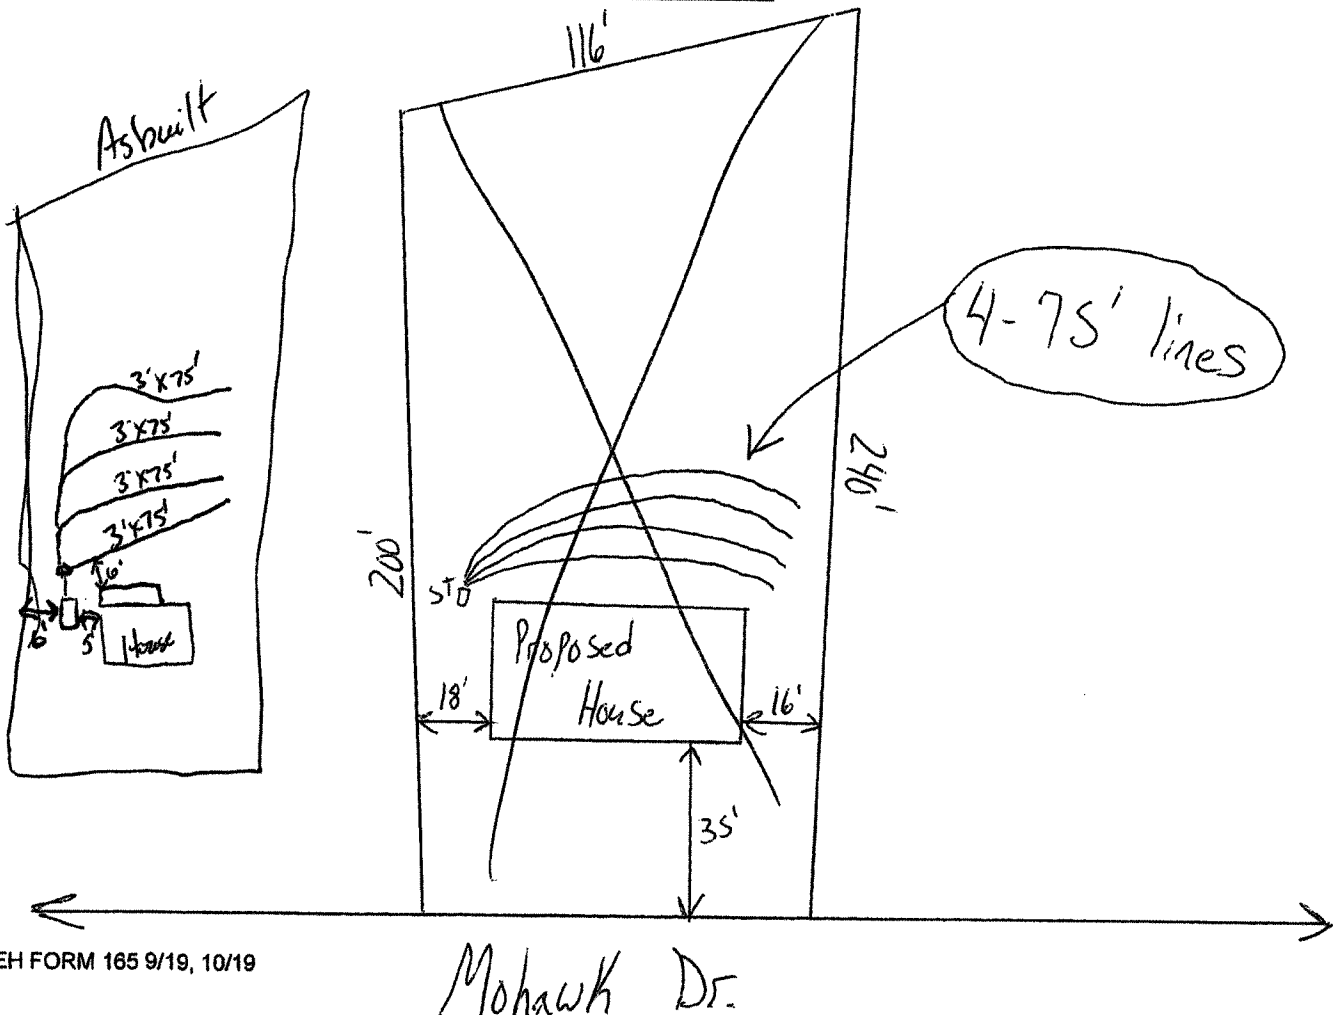



IMPROVEMENT PERMIT

Franklin County Health Department
107 Industrial Drive
Louisburg, NC 27549
Phone:

For Office Use Only

*CDP File Number 372593 - 1
County ID Number: 2272
Evaluated For: NEW

PERMIT VALID UNTIL: 05/25/2027

***NOTE TO INSPECTIONS DIVISION:** Building Permits cannot be issued with this Improvement Permit.

Applicant: BRANDON WIGGINS

Address: 20 BOTTLAND DR

City: YOUNGSVILLE

State/Zip: NC 27596

Phone #:

Property Owner: ROGER PATTERSON

Address: 95 RIVER ROCK WAY

City: FRANKLINTON

State/Zip: 27525

Phone #:

Property Location & Site Information

Address/Road #: 127 MOHAWK DR , NC

Subdivision: LAKE ROYALE

Phase: NEW

Lot:

Structure: SINGLE FAMILY

of Bedrooms: 3

of People: 3

*Water Supply: N/A

Directions

127 MOHAWK DR

System Specifications

Initial System

*Site Classification:

Design Flow: 360

Soil Application Rate: 0.3000

*System Classification/Description:

TYPE II A. CONV SYSTEM (SINGLE-FAMILY OR 480 GPD OR LESS)

*Proposed System:
25% REDUCTION

Minimum Trench Depth: _____ Inches

Maximum Trench Depth: 24 Inches

Septic Tank: 1000 Gallons

Pump Required ☐ Yes ☒ No ☐ May Be Required

Pump Tank: _____ Gallons

Repair System Required: ☐ Yes ☐ No ☐ No, but has Available Space

* 15A NCAC 18A. 1945 * Repair Area Exempt

No grading or construction activity is allowed in areas designated for system and repair without approval of Health Department

*Site Modifications

The issuance of this permit by the Health Department in no way guarantees the issuance of other permits. The permit holder is responsible for checking with appropriate governing bodies in meeting their requirements.

*Permit Conditions

The Department and Local Health Department may impose conditions on the issuance and may revoke the permits for failure of the system to satisfy the conditions, the rules, or this article. This permit is subject to revocation if the site plan, plat, or intended use changes (NCGS 130A-335(f)). The person owning or controlling the system location, installing, operation, maintenance, monitoring, reporting, and repair (1938(h)).

Authorized State Agent:

Bendel, Joel

Date of Issue:

05/25/2022

Total Time: (HH:MM)

☐ Hand Drawing

☐ Import Drawing

Site Plan/Drawing attached.



Construction Authorization

Franklin County Health Department
107 Industrial Drive
Louisburg, NC 27549
Phone: _____

For Office Use Only

*CDP File Number: 372593 - 1
County ID Number: 2272
Evaluated For: NEW

PERMIT VALID UNTIL: 05/25/2027

☐ Open Pump System Sheet

Applicant: BRANDON WIGGINS

Address: 20 BOTTOMLAND DR

City: YOUNGSVILLE

State/Zip: NC 27596

Phone #: _____

Property Owner: ROGER PATTERSON

Address: 95 RIVER ROCK WAY

City: FRANKLINTON

State/Zip: 27525

Phone #: _____

Property Location & Site Information

Address/Road #: 127 MOHAWK DR, NC Subdivision: LAKE ROYALE Phase: NEW Lot: _____

Directions:

Structure: SINGLE FAMILY 127 MOHAWK DR

of Bedrooms: 3

of People: 3

*Water Supply: _____

System Specifications

*Site Classification: _____

Design Flow: 360

Soil Application Rate: 0.3000

Minimum Trench Depth: _____ Inches

Maximum Trench Depth: 24 Inches

*System Classification/Description:

TYPE II A. CONV SYSTEM (SINGLE-FAMILY OR 480 GPD OR LESS)

Minimum Soil Cover: _____ Inches

Maximum Soil Cover: _____ Inches

*Proposed System:

25% REDUCTION

*Distribution Type: GRAVITY - PARALLEL (eq. d-box)

Nitrification Field: _____ Sq. ft.

No. Drain Lines: _____

Total Trench Length: 300 ft.

Trench Spacing: _____ - 9

Trench Width: _____ - 3

Aggregate Depth: _____ inches

Septic Tank: 1,000 Gallons

Pump Required: ☐ Yes ☒ No ☐ May Be Required

Pump Tank: _____ Gallons

Grease Trap: _____ Gallons

Septic Tank Installer

Grade Level Required: ☐ I ☐ II ☐ III ☐ IV

The issuance of this permit by the Health Department in no way guarantees the issuance of other permits. The permit holder is responsible for checking with appropriate governing bodies in meeting their requirements.

*Permit Conditions:

The Authorization for Wastewater System Construction shall be valid for a period equal to the period of validity of the Improvement Permit and may be issued at the same time the Improvement Permit issued (NCGS 130A-336(b)). If the installation has not been completed during the period of validity of the Construction Permit, the information submitted in the application for a permit or Construction Authorization shall become invalid, and may be suspended or revoked (.1937(g)). The person owning or controlling the system shall be responsible for assuring compliance with the laws, rules, and permit conditions regarding system location, installation, operation, maintenance, monitoring, reporting

Authorized State Agent: Bendel, Joel

Date of Issue: 05/25/2022

☐ Hand Drawing

☐ Import Drawing

Site Plan/Drawing attached.

Total Time : (HH:MM) _____



File # 372593 PIN# _____

Property Address: 127 Mohawk Dr.

Applicant or Owner Name: Brandon Wiggins

Environmental Health Septic/Well Permit Diagram

Building permits cannot be issued nor should construction begin without Construction Authorization issuance.

☒ Septic Improvement Permit ☒ Septic Construction Authorization (CA) ☐ CA Reissue** ☐ As Built
☐ Well Construction Authorization ☐ Additional Diagram/Specifications Attached

Diagram Date**: 5-25-22 EHS: Joel Bendel

**Any previously dated CA diagram is revoked and/or invalid. Confirm this is the valid diagram for the site before beginning any construction.

Installation/grouting inspections may be scheduled the day before, or, the day of installation until 9am by contacting the Environmental Health office at 919 496 8100. A revisit fee may apply if installation is not ready for inspection at the time requested. Septic Operations Permits will be issued after installation is approved, all permits conditions are met, and any outstanding fees are paid. Well Certificate of Completion will be issued after well head approval, all permit conditions are met, and any outstanding fees are paid.

Septic Tank 1000 Pump Tank N/A Drainfield 3'x300' Type System Acc Max Trench Depth 24"

Septic Contractor _____ Septic/Pump tank dates _____ Pump fee? ☒ YES ☐ NO

Well Contractor _____ Well Grout date: _____

