

Franklin County Health Department

Name: TORRES

Permit Number


7457

CONTRACTOR Owner TANK MANU _____ MANU DATE _____

WELL INSTALLED YES _____ NO _____ SYSTEM CODE _____

SEPTIC SYSTEM LAYOUT
(SKETCH SYSTEM LAYOUT HERE)

- * Found old septic lines near house was connected to system. Ground water ~~was~~ was being drawn from old lines into ~~septic~~ pump tank - new solid PVC was connected from ST to pump tank.
- * Found two pipes entering septic tank - cut and capped off line not connected to Mr Torres house. Patched knockout in septic tank.

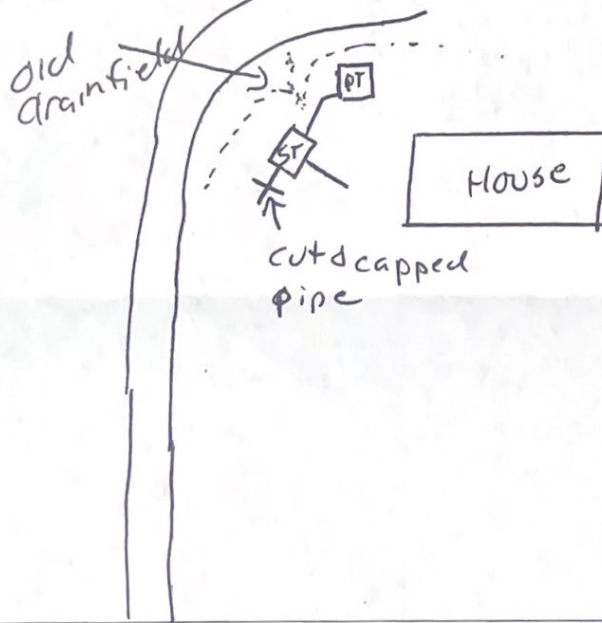

SEPTIC SYSTEM AS-BUILT

(IF DIFFERENT FROM INITIAL LAYOUT)

ON REVERSE

OPERATIONS PERMIT

DATE

4/7/14

EHS