

4130955

Granville - Vance District Health Department
Environmental Health


Final Sketch

Pin _____

Keller Pond 341
Subdivision - Section - Lot

Physical Address: 3177 Keller Lane

System design and details as installed.

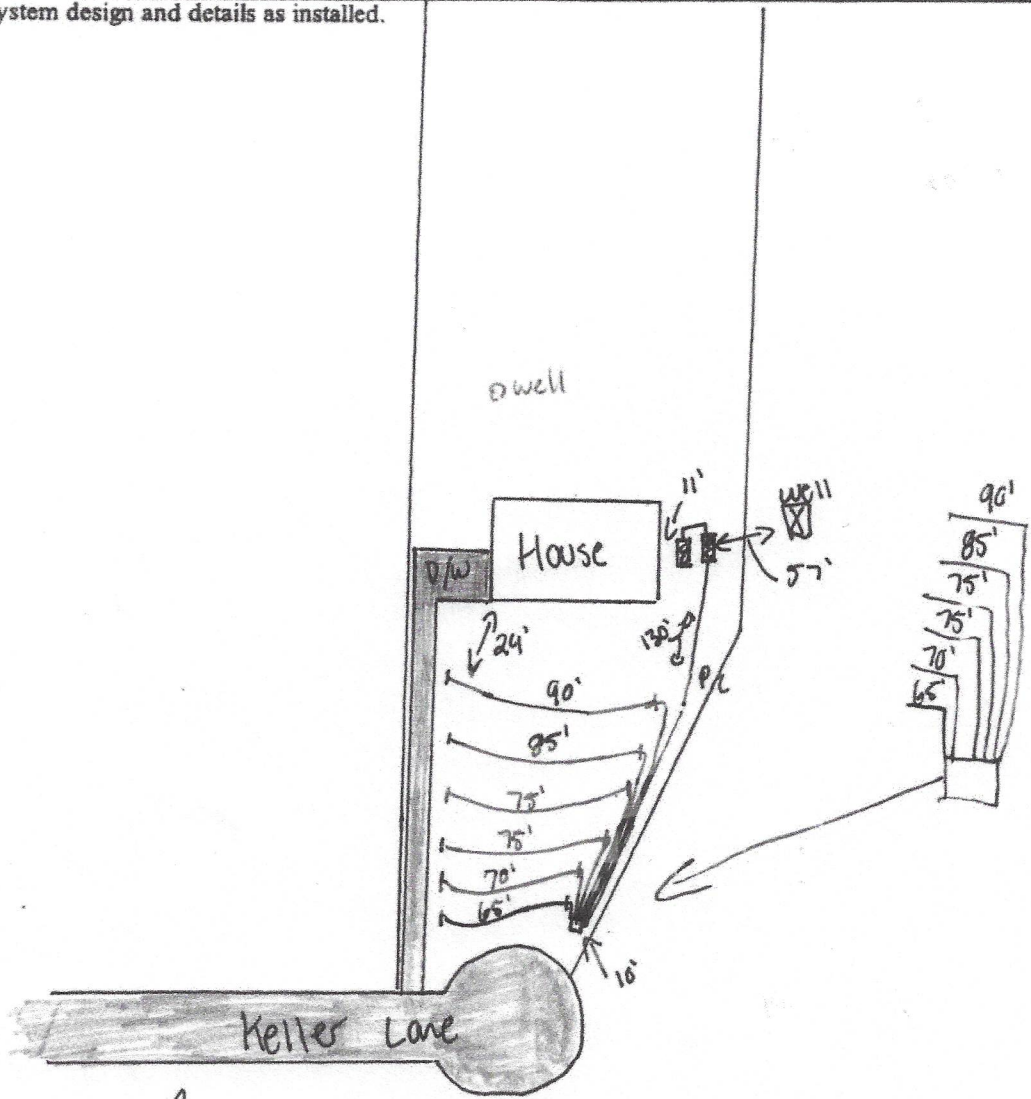

Alexi Wi REHS
Authorized Signature

3/6/28
Date

SEWAGE DISPOSAL SYSTEM INSTALLATION REVIEW

OWNER Michael McNally PERMIT # 4130955 DATE 3/6/26
CONTRACTOR James Madden WEATHER CONDITIONS Sunny
SOIL WETNESS Dry

SEPTIC AND PUMP TANK INSPECTION

SEPTIC TANK	INITIAL	DATE
Manufacturer <u>Mills</u>	_____	_____
Date of Manufacture <u>11/8/25</u>	_____	_____
Stamp <u>68</u>	_____	_____
Capacity <u>1000</u>	_____	_____
Tee <u>✓</u>	_____	_____
Baffle _____	_____	_____
Sealant _____	_____	_____

PUMP TANK	INITIAL	DATE
Manufacture <u>Mills</u>	_____	_____
Date of Manufacture <u>10/28/25</u>	_____	_____
Stamp <u>72</u>	_____	_____
Capacity <u>1000</u>	_____	_____
Sealant _____	_____	_____
Manhole _____	_____	_____
Draw Down Test _____	_____	_____

MECHANICAL INSPECTION

PUMP	INITIAL	DATE
Manufacturer and Model # _____	_____	_____
Control Panel _____	_____	_____
Alarm _____	_____	_____
Electrical Connection _____	_____	_____

NITRIFICATION/DISTRIBUTION AND DRAINFIELD INSPECTION

DISTRIBUTION BOX	INITIAL	DATE
Level _____	_____	_____
Equal Distribution _____	_____	_____
Other _____	_____	_____

DISTRIBUTION MANIFOLD	INITIAL	DATE
Pipe Size <u>2in</u> <u>→ 130'</u>	_____	_____
Gate Valves _____	_____	_____
Other _____	_____	_____

OTHER DISTRIBUTION
Type _____

NITRIFICATION LINES	LINE 1	LINE 2	LINE 3	LINE 4	LINE 5	LINE 6
Trench Width	<u>3'</u>	<u>3'</u>	<u>3'</u>	<u>3'</u>	<u>3'</u>	<u>3'</u>
Trench Length	<u>65'</u>	<u>70'</u>	<u>75'</u>	<u>75'</u>	<u>85'</u>	<u>90'</u>
Trench Grade	<u>✓</u>	<u>✓</u>	<u>✓</u>	<u>✓</u>	<u>✓</u>	<u>✓</u>
Stone Depth	<u>poly</u>	_____	_____	_____	_____	_____

COMMENTS:

N-P-Poly