

GRANVILLE-VANCE HEALTH DEPARTMENT—Sewage Disposal Record

Owner or Contractor Master's Properties Date 1-6-86 S.R. No. 1114

Location/Address Woodland Ch. Rd

Subdivision/Mobile Home Park Name Merrieweather Lot Size _____


Permit No. # _____ Lot No. 8

New System ☒ Repair _____
 House ☒ Mobile Home _____ Business _____
 No. Bedrooms 3 No. People 1 No. Toilets _____
 Water Supply: Private ☒ Approved _____
 Semi-Public _____ Unapproved _____
 Public _____ None _____

Nitrification System:

Tank Size 1000 gal. _____
 Distribution Box 455 No. Lines 4
 Nitrification Field 900 Sq. Ft. _____
 Lines: 1 2 3 4 5 6
 Width 3 3 3 3 _____
 Length 75 75 75 75 _____
 Grade ✓ ✓ ✓ ✓ _____
 Stone Depth NA _____
Free Flow

Layout to be followed by installer:

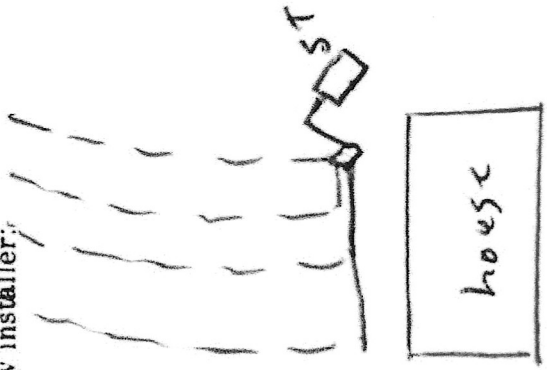

Chatham Ct

Improvements Permit By D. Cumber Installer David Brantley

Certificate of Completion By Ed. Vaughan Date of Inspection 3-30-88

* Construction must comply with all other applicable state and local regulations, but the permit is not a guarantee that the system will not malfunction and the Granville-Vance Health District will not be held responsible for a malfunctioning system.