

PERMIT NUMBER 06258

GRANVILLE-VANCE DISTRICT HEALTH DEPARTMENT IMPROVEMENT AND OPERATION PERMITS

COUNTY:	TAX NO.	TYPE OF ESTABLISHMENTS			*THIS PERMIT SHALL BE ACCOMPANIED BY A LAYOUT SHOWN ON A PLAT, INCLUDING SYSTEM REQUIREMENTS.
OWNER:	SR. NO.	RESIDENCE ☒	NUMBER OF BEDROOMS:	NUMBER OF OCCUPANTS:	
		BUSINESS ☐			
APPLICANT'S ADDRESS:		OTHER ☐	WATER SUPPLY	WELL PUBLIC ☐	
PROPERTY ADDRESS/LOCATION:		TYPE OF WASTEWATER SYSTEM	INITIAL INSTALLATION	REPAIR	*THIS IMPROVEMENT PERMIT IS SUBJECT TO REVOCATION IF THE INTENDED USES CHANGE FROM THOSE SHOWN ON THE IMPROVEMENT PERMIT. CHANGES SHALL REQUIRE HEALTH DEPARTMENT APPROVAL.
SUBDIVISION:		DESIGN FLOW:			
LOT NUMBER:		LTAR:			
		ABSORPTION AREA:			
REFERENCE SKETCH (SEE PLAT FOR DETAILS)		TRENCH WIDTH:			PERMIT VALID FOR: 5 YEARS YES ☒ NO ☐
		TRENCH DEPTH:			
		TRENCH SPACING:			
		TOTAL TRENCH LENGTH:			
		NUMBER OF TRENCHES:			NO EXPIRATION YES ☐ NO ☒
		GRAVEL DEPTH:			
		TANK SIZE:			
		PUMP TANK SIZE:			
		DISTRIBUTION DEVICE:			

***** IMPROVEMENT PERMIT DATE: 4-9-07 *****

FOR: Steven Hayes
ISSUED BY: David Cumbee

CONSTRUCTION AUTHORIZATION FOR IMPROVEMENT PERMIT# 06258

Unless otherwise indicated, the same conditions above apply regarding system type, layout, location and installation requirements.
(The wastewater system cannot be installed until authorization is signed)

Comments: Use NEMA 4 external alarm - Do not install in wet conditions - call 693-2688 w/ questions

Date: 4-9-07 Environmental Health Specialist: David Cumbee Construction Authorization Addendum ☐ Yes ☒ No

OPERATION PERMIT

DATE: 6-1-2011

SYSTEM INSTALLED BY: David Blantly
ISSUED BY: David Cumbee

PERFORMANCE, MONITORING, MAINTENANCE AND OPERATION
AS REQUIRED BY RULE .1961

Granville - Vance District Health Department
Environmental Health

Pin 183400130668

Permit Number 6258

☒ Improvement Permit

☒ Construction Authorization

Final Sketch

Steven Hayes
Applicants Name

Silverleaf 68
Subdivision - Section - Lot

Physical Address: Silverleaf Dr

David Brantley + Sons
System Installer

6-1-2011
Date

System design and details as installed.

Septic Tank Information:

Date: 4-9-10
Manufacture: DB 1250 gal
ID #: STB-398

Pump Tank Information:

Date: 1-9-9
Manufacturer: DB 1500
ID #: PT-322

Distribution Box

Pressure Manifold ☒ - 4
Serial Distribution 1/2" taps

Type of Facility: House

Number of Bedrooms: 4


Type of System: pump to E-Z Flow

Zoeller Pump
N152 1/2 H.P.

AquaWorx - Infiltrator
Transducer
(No floats)

2' Head Pressure

± 210 gal/dose
7.5 min
pump
Run
Time

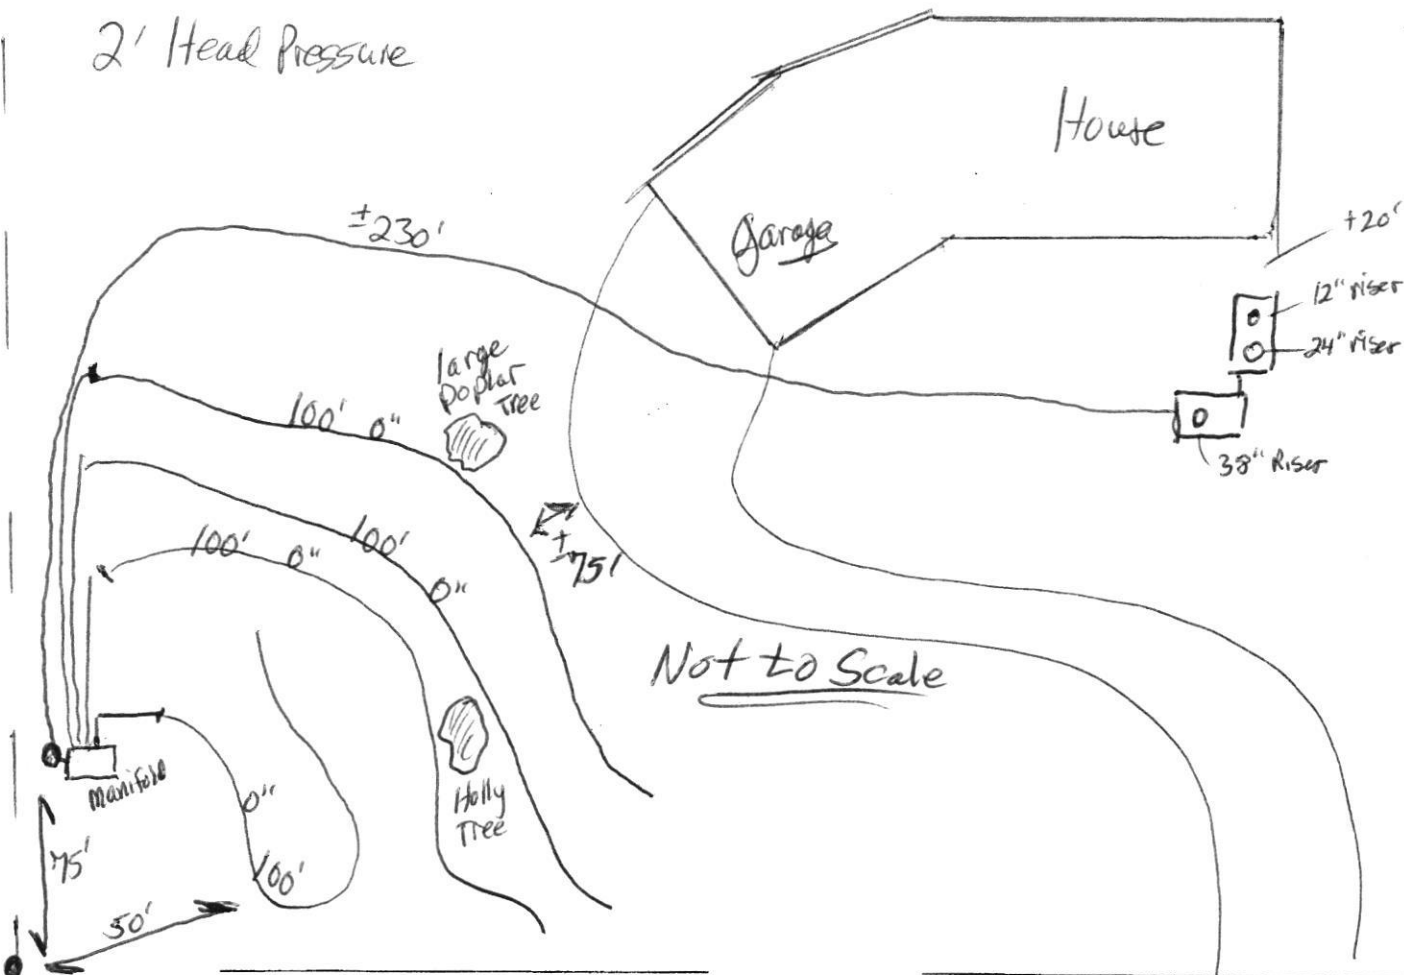

Authorized Signature

David Brantley

Date

6-1-2011