

CR



Franklin County
215 E. Nash St. Louisburg, NC 27549
Phone (919) 496-2281
www.franklincountync.us

353450

Issued to: Brandon Wiggins

Location: 121 MOHAVE DR LOUISBURG , NC 27549

NEW SEPTIC APPLICATION

2830-50-7533

Application Type: NEW SEPTICApplication Number: **E-21-162**

Date: February 24, 2021

Building Type:

Acreage: 0.42

Project Type: Single Family Dwelling

Zoning: R-1

of Bedrooms: 3

of People: 3

Parcel ID #: 023019

Subdivision: LOT ROYALE

lot 44

Applicant Information

Applicant Name: Brandon Wiggins

Address: 30 Bottomland Dr Youngsville , North Carolina 27596

Phone: 919-671-9377

Email: brandon@roostbuildingcompany.com

Property Owner Information

Owner Name: STEVENS JOHN R

Address: 5 WALTER CIR FREDERICKSBURG , VA 22405

Phone:

Email:

General Contractor Information

Contractor Name: Roost Building Company Inc.

Address: 30 Bottomland Dr. null Youngsville , NC 27596

Phone: (919) 671-9377

Email: brandon@roostbuildingcompany.com

Zoning

Zoning Permit #: Z-21-313

County Water: TESI

Front Setback: 30

Right Setback: 10

Left Setback: 10

Rear Setback: 25

Call Environmental Health (919-496-8100) between 8:00 - 9:00 a.m. Monday - Friday in order to schedule an appointment with an environmental Health Specialist for your lot evaluation. This application for an improvement permit/construction authorization and well permit does not constitute approval for zoning, septic, and building permits. It will be necessary to meet all guidelines for zoning, septic, and building permits prior to construction. The application is valid for either 12 months or without expiration, depending upon documentation submitted.

Please contact the Environmental Health Department at 919-496-8100 to determine the status of your application prior to visiting the Planning & Inspections Department to obtain a building permit.

I hereby certify that I am the owner, or authorized by the owner to act as his/her legal representation. Furthermore, as legal representative (if applicable) I have advised the owner of my intention to apply for this wastewater treatment and disposal system and drinking water and well system permit.


I also certify that all of the statements made in this application and any attached documents are true, complete, and correct, to the best of my knowledge and belief, and are made in good faith. If information in this application for these improvements is falsified, changed or site is altered, then improvement permits and authorization to construct these improvements shall become invalid. Authorized county representatives are granted right of entry to make these evaluations or inspections, and to be release information upon public request.

February 24, 2021

1. AREAS COMPUTED BY COORDINATE METHOD.
2. BASIS OF BEARINGS: PLAT BOOK 12 PAGE 6 OF FRANKLIN COUNTY REGISTER OF DEEDS.
3. THIS PROPERTY HAS A TOTAL ACREAGE OF 0.42 OR 18,476 SQ FT.
4. THIS MAP IS OF FRANKLIN COUNTY PARCEL NUMBERED (PIN) 2830-56-7533.
5. LOT 44 OF THE LAKE SAGAMORE MAP 1 OF 20 SHEET 6 OF 14.
6. BUILDING SETBACKS ARE: 10' SIDES; 25' REAR AND 30' FRONT.
7. THIS PROPERTY IS SUBJECT TO RESTRICTIVE COVENANTS OF THE LAKE ROYALE POA.

I, GUY V. COOKE, AS A PROFESSIONAL LAND SURVEYOR IN THE STATE OF NORTH CAROLINA, DO HEREBY CERTIFY THAT THIS PLAT WAS DRAWN UNDER MY SUPERVISION FROM AN ACTUAL SURVEY MADE UNDER MY SUPERVISION AND COMPLETED ON 2-17-2021, USING THE REFERENCES SHOWN HEREON; THAT THE BOUNDARIES NOT SURVEYED ARE CLEARLY INDICATED AS DRAWN FROM INFORMATION FOUND IN THE REFERENCES SHOWN HEREON; THAT THE RATIO OF PRECISION AS CALCULATED IS 1 : 10,000 + ; THAT THIS MAP WAS PREPARED IN ACCORDANCE WITH NORTH CAROLINA GENERAL STATUTES 47-30, AS AMENDED. WITNESS MY ORIGINAL SIGNATURE AND SEAL THIS

18th DAY OF February A.D., 2021.

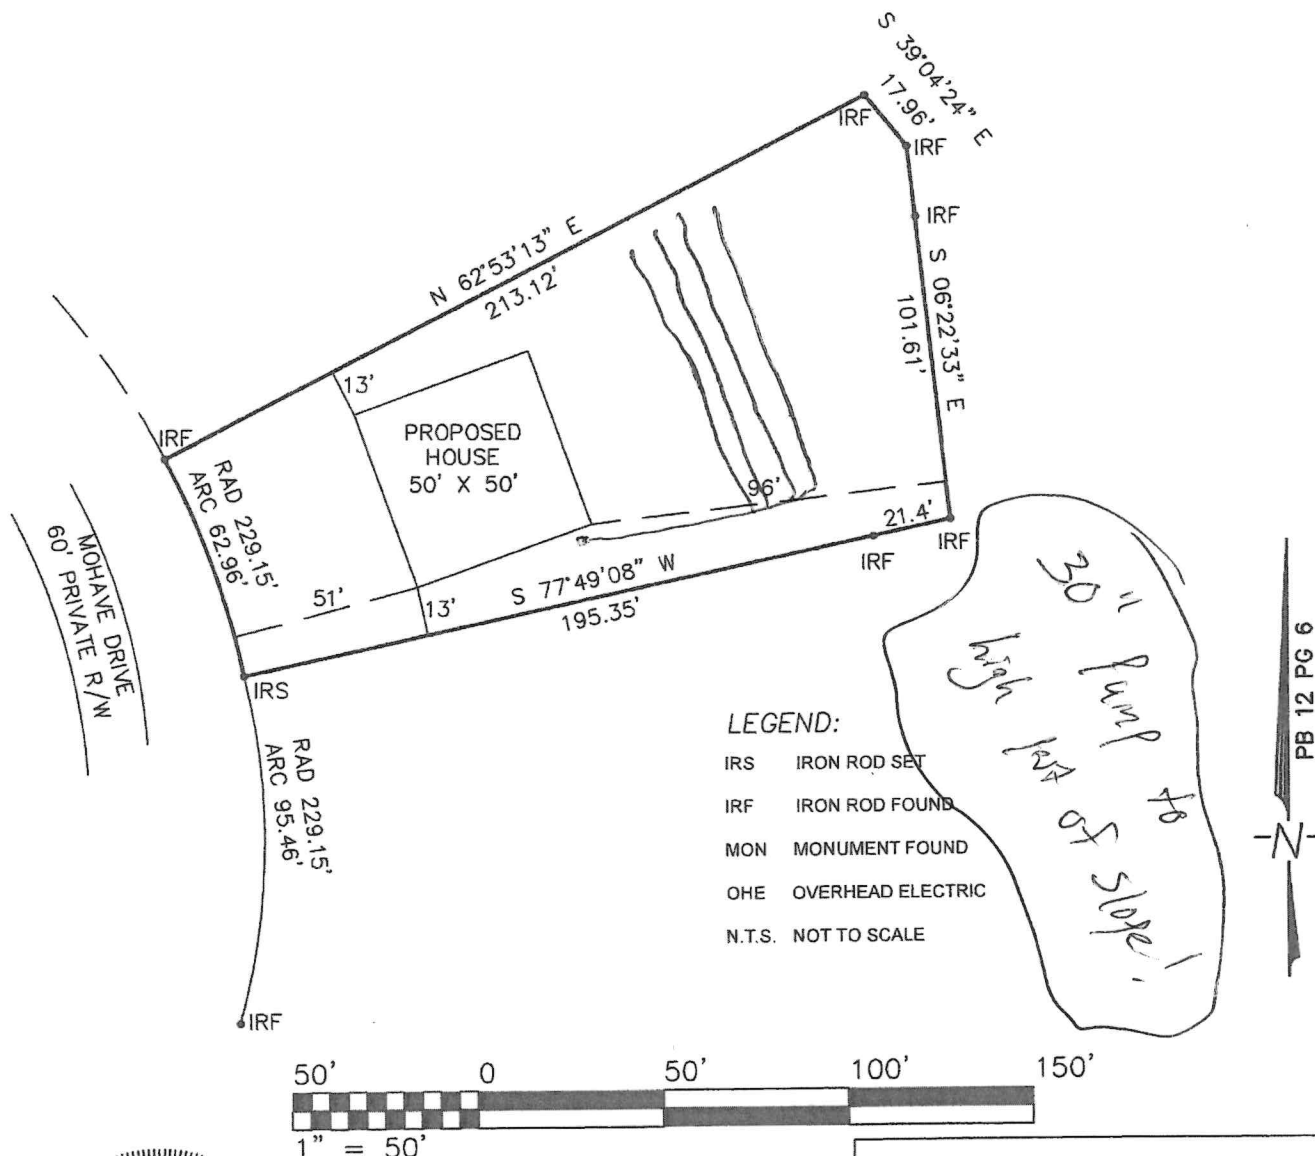

ROOST CONSTRUCTION CO.
121 MOHAVE DRIVE
CYPRESS CREEK TOWNSHIP
FRANKLIN COUNTY
NORTH CAROLINA

711 LAKE ROYALE
LOUISBURG, NC 27549
GUY V. COOKE, PLS L-4596
FIRM # P-1311
919-901-5641



IMPROVEMENT PERMIT

Franklin County Health Department
107 Industrial Drive
Louisburg, NC 27549
Phone: _____

For Office Use Only

*CDP File Number: 353456 - 1
County ID Number: 2830-56-7533
Evaluated For: NEW

PERMIT VALID UNTIL: 03/22/2026

***NOTE TO INSPECTIONS DIVISION:** Building Permits cannot be issued with this Improvement Permit.

Applicant: BRANDON WIGGINS
Address: 30 BOTTOMLAND DR
City: YOUNGSVILLE
State/Zip: NC 27596
Phone #: _____

Property Owner: JOHN STEVENS
Address: 5 WALTER CIR
City: FREDERICKSBURG
State/Zip: VA. 22405
Phone #: _____

Property Location & Site Information

Address/Road #: 121 MOHAVE DR LOUISBURG, Subdivision: LAKE ROYALE Phase: NEW Lot: 44
NC 27549
Structure: SINGLE FAMILY
Directions: 121 MOHAVE DR
of Bedrooms: 3
of People: 3
*Water Supply: N/A

System Specifications

Initial System

*Site Classification:

Design Flow: 360

Soil Application Rate: _____

*System Classification/Description:

TYPE III B. SYSTEM W/SINGLE EFFLUENT PUMP

*Proposed System:

25% REDUCTION

Minimum Trench Depth: _____ Inches

Maximum Trench Depth: 30 Inches

Septic Tank: 1000 Gallons

Pump Required ☒ Yes ☐ No ☐ May Be Required

Pump Tank: 1000 Gallons

Repair System Required: ☐ Yes ☒ No ☐ No, but has Available Space * 15A NCAC 18A. 1945 * Repair Area Exempt

No grading or construction activity is allowed in areas designated for system and repair without approval of Health Department

*Site Modifications

The issuance of this permit by the Health Department in no way guarantees the issuance of other permits. The permit holder is responsible for checking with appropriate governing bodies in meeting their requirements.

*Permit Conditions

The Department and Local Health Department may impose conditions on the issuance and may revoke the permits for failure of the system to satisfy the conditions, the rules, or this article. This permit is subject to revocation if the site plan, plat, or intended use changes (NCGS 130A-335(f)). The person owning or controlling the system location, installing, operation, maintenance, monitoring, reporting, and repair (1938(b)).

Authorized State Agent:

Bendel, Joel

Date of Issue:

03/22/2021

Total Time: (HH:MM)

☐ Hand Drawing

☐ Import Drawing

Site Plan/Drawing attached.



Construction Authorization

Franklin County Health Department
107 Industrial Drive
Louisburg, NC 27549
Phone: _____

For Office Use Only

*CDP File Number: 353456 - 1

County ID Number: 2830-56-7533

Evaluated For: NEW

PERMIT VALID UNTIL: 03/22/2026

☐ Open Pump System Sheet

Applicant: BRANDON WIGGINS

Address: 30 BOTTOMLAND DR

City: YOUNGSVILLE

State/Zip: NC 27596

Phone #: _____

Property Owner: JOHN STEVENS

Address: 5 WALTER CIR

City: FREDERICKSBURG

State/Zip: VA. 22405

Phone #: _____

Property Location & Site Information

Address/Road #: 121 MOHAVE DR LOUISBURG, NC 27549 Subdivision: LAKE ROYALE Phase: NEW Lot: 44

Directions:

Structure: SINGLE FAMILY 121 MOHAVE DR

of Bedrooms: 3

of People: 3

*Water Supply: _____

System Specifications

*Site Classification: _____

Design Flow: 360

Soil Application Rate: _____

*System Classification/Description:

TYPE III B. SYSTEM W/SINGLE EFFLUENT PUMP

*Proposed System:

25% REDUCTION

Minimum Trench Depth: _____ Inches

Maximum Trench Depth: 30 Inches

Minimum Soil Cover: _____ Inches

Maximum Soil Cover: _____ Inches

*Distribution Type: PUMP TO GRAVITY

Nitrification Field: _____ Sq. ft.

No. Drain Lines: _____

Total Trench Length: 300 ft.

Trench Spacing: _____ - _____

Trench Width: _____ - _____

Aggregate Depth: _____ inches

☐ Inches O.C.

☐ Feet O.C.

☐ Inches

☐ Feet

Septic Tank: 1,000 Gallons

Pump Required: ☒ Yes ☐ No ☐ May Be Required

Pump Tank: 1,000 Gallons

Grease Trap: _____ Gallons

Septic Tank Installer

Grade Level Required:

☐ I

☐ II

☐ III

☐ IV

The issuance of this permit by the Health Department in no way guarantees the issuance of other permits. The permit holder is responsible for checking with appropriate governing bodies in meeting their requirements.

*Permit Conditions:

The Authorization for Wastewater System Construction shall be valid for a period equal to the period of validity of the Improvement Permit and may be issued at the same time the Improvement Permit issued (NCGS 130A-336(b)). If the installation has not been completed during the period of validity of the Construction Permit, the information submitted in the application for a permit or Construction Authorization shall become invalid, and may be suspended or revoked (.1937(g)). The person owning or controlling the system shall be responsible for assuring compliance with the laws, rules, and permit conditions regarding system location, installation, operation, maintenance, monitoring, reporting

Authorized State Agent: Bendel, Joel

Date of Issue: 03/22/2021

☐ Hand Drawing

☐ Import Drawing

****Site Plan/Drawing attached.****

Total Time : (HH:MM) _____



File # 353456 PIN# _____

Property Address: 121 Mohave Dr.

Applicant or Owner Name: Brandon Wiggins

Environmental Health Septic/Well Permit Diagram

Building permits cannot be issued nor should construction begin without Construction Authorization issuance.
☒ Septic Improvement Permit ☒ Septic Construction Authorization (CA) ☐ CA Reissue** ☒ As Built
☐ Well Construction Authorization ☐ Additional Diagram/Specifications Attached

Diagram Date**: 3-22-21 EHS: Joel Bendel


**Any previously dated CA diagram is revoked and/or invalid. Confirm this is the valid diagram for the site before beginning any construction.

Installation/grouting inspections may be scheduled the day before, or, the day of installation until 9am by contacting the Environmental Health office at 919 496 8100. A revisit fee may apply if installation is not ready for inspection at the time requested. Septic Operations Permits will be issued after installation is approved, all permit conditions are met, and any outstanding fees are paid. Well Certificate of Completion will be issued after well head approval, all permit conditions are met, and any outstanding fees are paid.

Septic Tank 1000 Pump Tank 1000 Drainfield 3'x300' Type System Pto Acc Max Trench Depth 30"

Septic Contractor _____ Septic/Pump tank dates _____ Pump fee? ☒ Yes ☐ No

Well Contractor _____ Well Grout date: _____

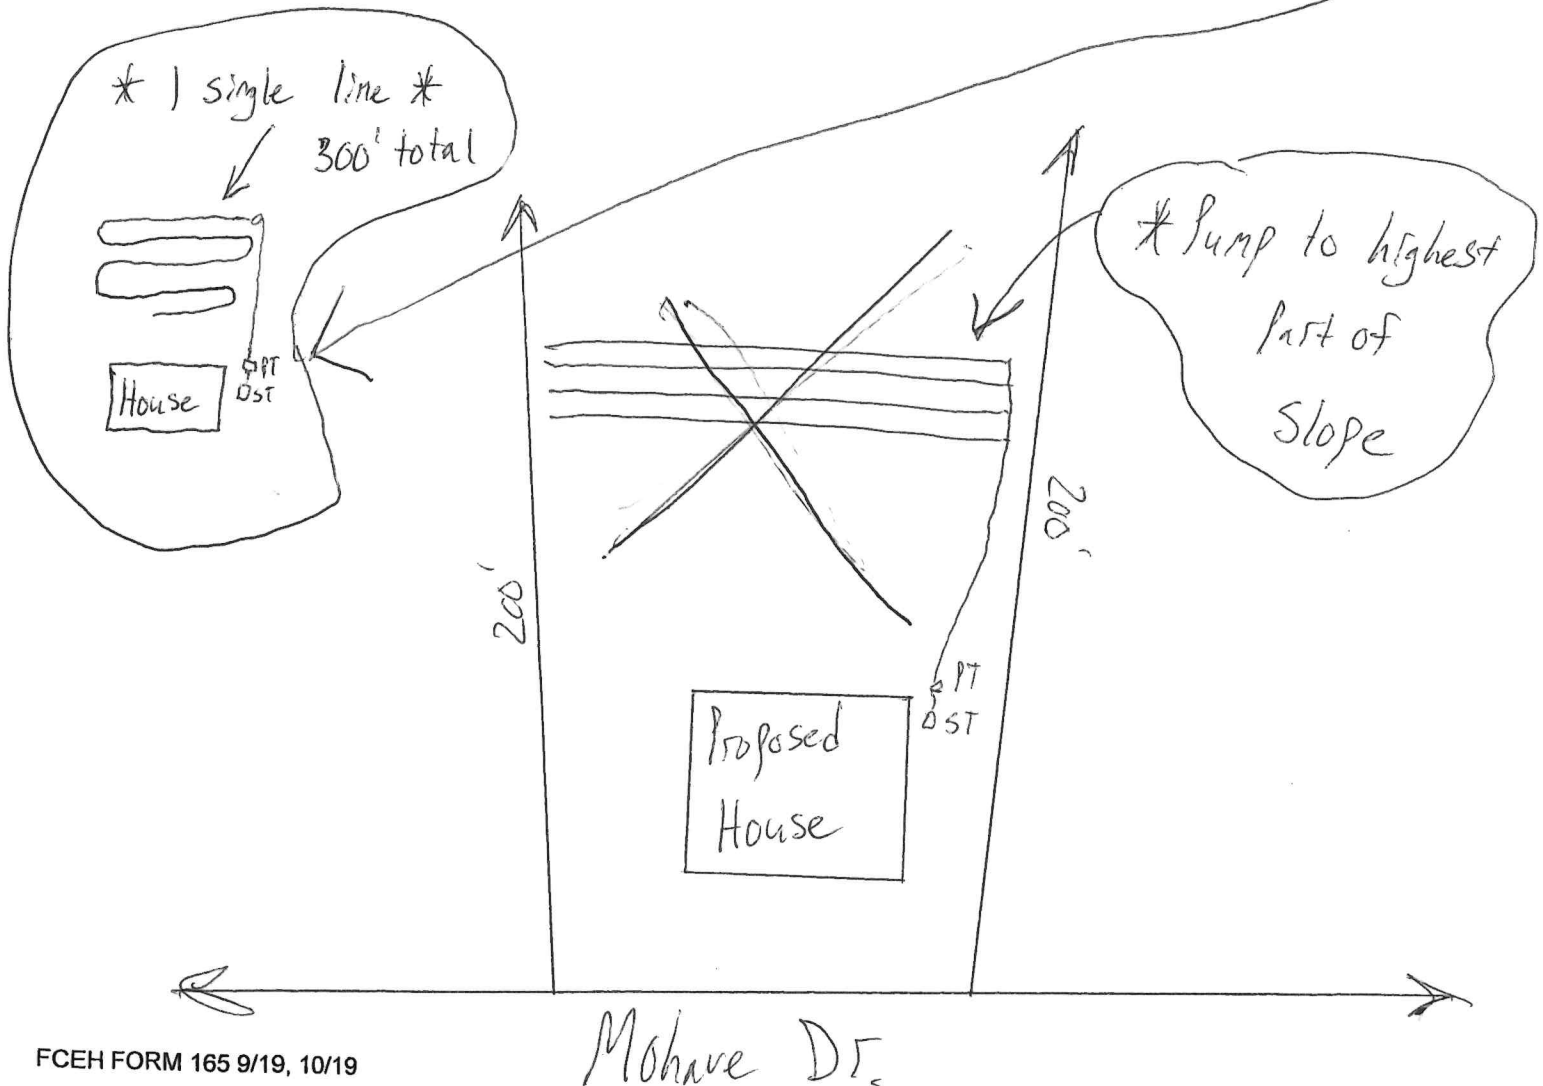



OPERATION PERMIT

Franklin County Health Department
107 Industrial Drive
Louisburg, NC 27549
Phone:

For Office Use Only

*CDP File Number 353456 - 1
County ID Number: 2830-56-7533
Evaluated For: NEW

Property Owner: JOHN STEVENS

Address: 5 WALTER CIR

Road #:

City: FREDERICKSBURG

State/Zip: VA/ 22405

Phone #:

Township:

Subdivision: LAKE ROYALE

Phase: NEW

Lot: 44

Structure: SINGLE FAMILY

of Bedrooms: 3

of People: 3

Water Supply: N/A

Saprolite System?: ☐ Yes ☒ No

Pump Required?: ☐ Yes ☒ No

Design Flow: 360

System Classification/Description: TYPE III B. SYSTEM
W/SINGLE EFFLUENT PUMP

Installer: DBS

Specific System UNKNOWN

Installed:

STB: 1000

PT: 1000

Comments:

Certification #:

Septic Tank Date: 08/30/2021

Pump Tank Date: 08/24/2021

This system has been installed in compliance with applicable NC General Statutes, Rules for Sewage Treatment and Disposal, and all conditions of the Improvement Permit and Construction Authorization.

PERMIT CONDITIONS:

I. Performance: System shall perform in accordance with Rule .1961.

II. Monitoring: As required by Rule .1961.

III. Maintenance: Ground absorption sewage treatment and disposal systems shall be checked, and the contents of the septic tank removed, periodically from all compartments, to ensure proper operation of the system. The contents shall be pumped whenever the solids level is found to be more than 1/3 of the liquid depth in any compartment.

Other:

Subsurface Operator Required: ☐ Yes ☒ No

If yes, see attached sheet for additional operation conditions, maintenance and reporting.

Operation:

Other:

Authorized State Agent: Bendel, Joel

Date of Issue: 10/21/2021

Owner/Applicant: _____