

Granville - Vance District Health Department

Environmental Health

Well Construction Permit

00105


Owner/Applicant: Downey Homes Date: 10-23-08
 Address or Location of Property: Old 75 → Cross Tr. River → (R) into subdivision
→ (R) → lot on (R) at end
 Subdivision & Lot #: Woodlief Meado-18 Septic Permit #: 6852
 Zoning Permit #: 16078 Environmental Health Specialist: Carey Champion

This well permit is to locate and site the area that a private groundwater well may be established on the property listed above by the Environmental Health Specialists of Granville County. If one does not locate the well in the approved area and complete the well as specified by the 15A NCAC .02C rules, then permits may be revoked. At completion of drilling of the well, grout must be witnessed by EHS and a well log turned into Environmental Health.

Minimum Setbacks: (these are the main setbacks, but not all required setbacks)

Setback from property lines – 10 ft Setback from septic tank and drain field, including repair area – 100 ft
 Setback from structural foundations – 25 ft Setback from ponds, lakes or other bodies of water – 50 ft

Site Sketch:

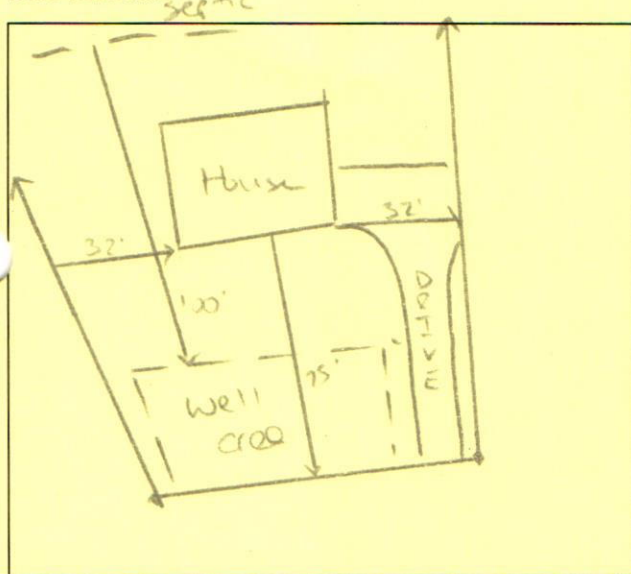


Conditions:

Authorized Agent: Carey Champion
 Date: 10-23-08

Well Grout: (Circle or write in)

Witnessed: Yes or No EHS Agent: Champion
 Date: 6-29-10 Annular Space Open: Yes or No
 Over reamed: Yes or No
 Method: Pump ☒ Poured ☐ Pressure
 Depth Grouted: 20 ft +
 Well Log received: Yes or No (EHS to Attach to Permit)

As Built Drawing:

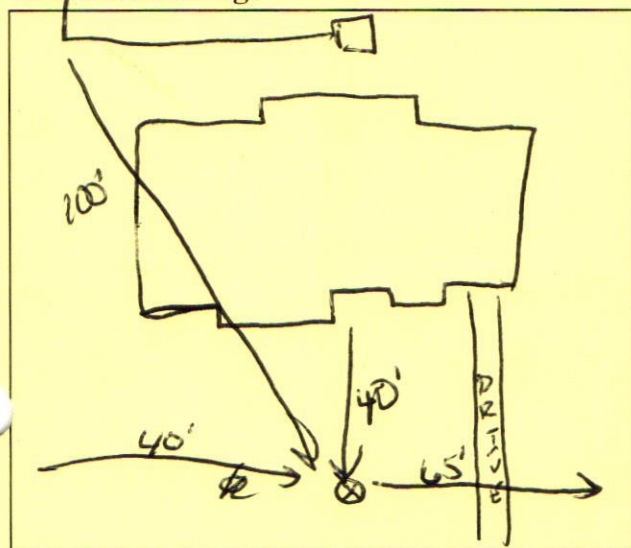

Well Final: (Place a check mark when finalized)

Seal Present and Intact: ☒ Air Vent: ☒
 Hose Spigot: ☒ Electrical Box: ☒
 Pump Installer Tag: ☒ Well Installer Tag: ☒
 All holes sealed: ☒ 12" above grade: ☒

Comments:

Well Completion Permit: SKnoft, EHS
 Date Completed: 7/20/10

Water Samples Taken: Date: 7/20/10
 EHS: SK Results: _____
 Retest: _____ Results: _____

Pin 099104506913

✓ Improvement Permit

✓ Construction Authorization

Donney Jones
Applicants Name

Woodleaf Meadows - lot #18
Subdivision - Section - Lot

Physical Address: _____

Blackley
System Installer

~~6-16-10~~ 6-15-10
Date

Septic Tank Information:

Date: 3-27-09

Manufacture: Ellis-1000

ID #: 8TB-789

Pump Tank Information:

Date: / /

Manufacturer: /

ID #: _____

Distribution Box ✓


Pressure Manifold

Serial Distribution

Type of Facility: Residence

Number of Bedrooms: 3

Type of System: EZ-Flow / Gravity

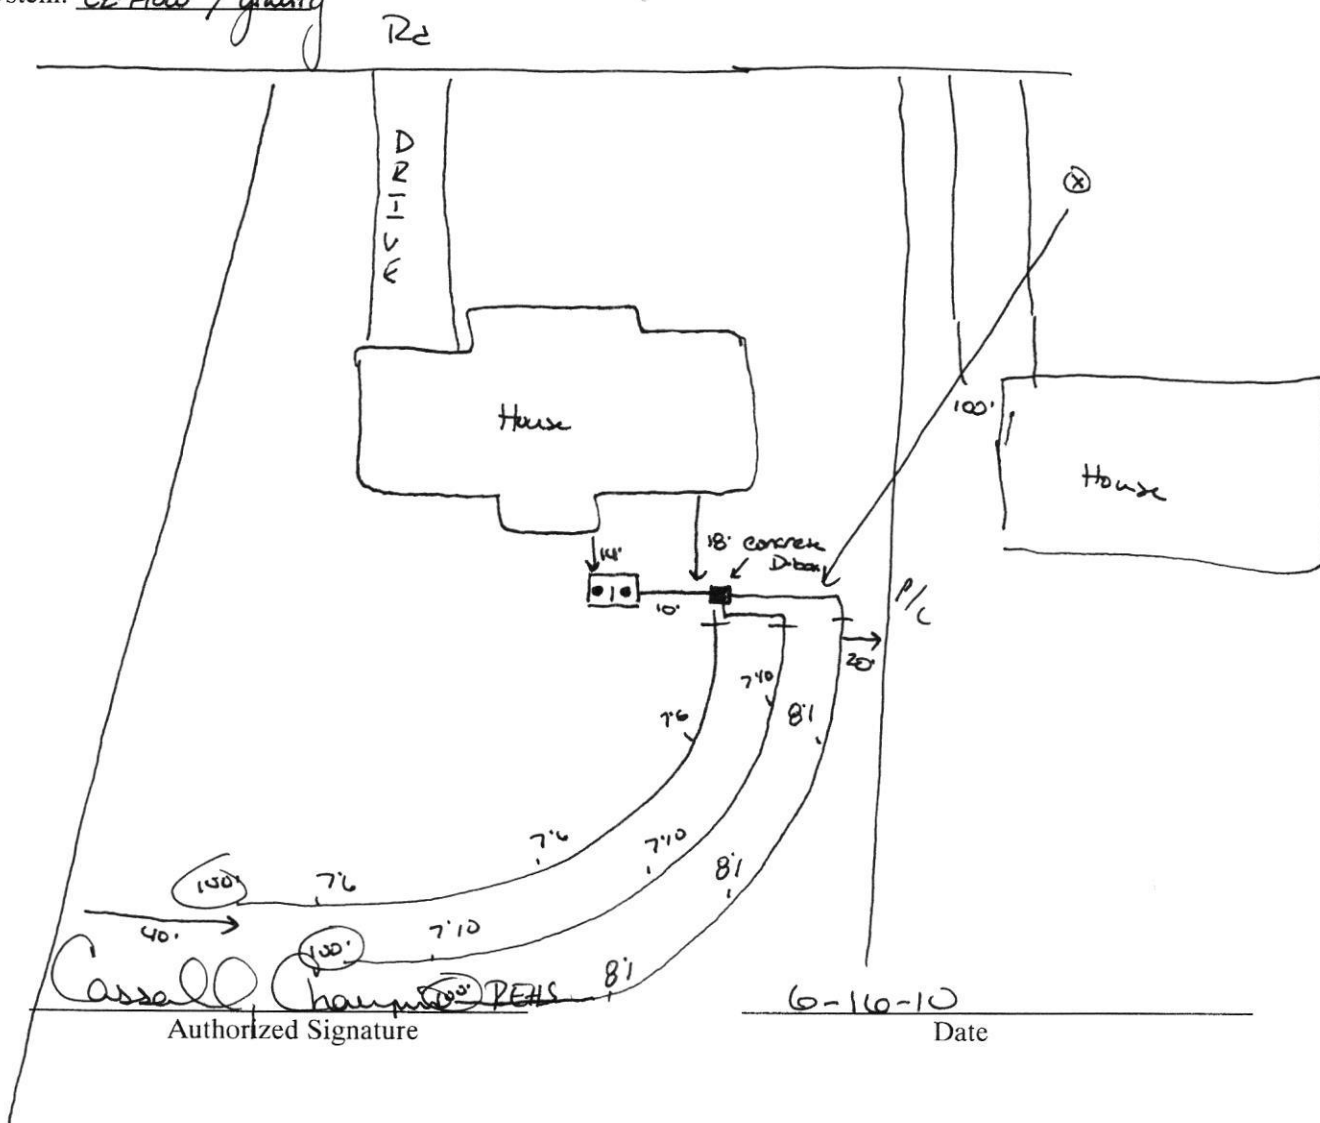

2P# 16078

PERMIT NUMBER 06852

GRANVILLE-VANCE DISTRICT HEALTH DEPARTMENT IMPROVEMENT AND OPERATION PERMITS

COUNTY:	TAX NO. 099104506913	TYPE OF ESTABLISHMENTS			*THIS PERMIT SHALL BE ACCOMPANIED BY A LAYOUT SHOWN ON A PLAT, INCLUDING SYSTEM REQUIREMENTS.
OWNER: Downey Homes	SR. NO. 0475	RESIDENCE ☒ BUSINESS ☐ OTHER ☐	NUMBER OF BEDROOMS: 3	NUMBER OF OCCUPANTS: max 6	
APPLICANT'S ADDRESS: 4016 W 88th Rd Kennesaw, NC 27596		WATER SUPPLY Private	WELL ☒ PUBLIC ☐	OTHER ☐	
		TYPE OF WASTEWATER SYSTEM	INITIAL INSTALLATION II	REPAIR III	
PROPERTY ADDRESS/LOCATION: 4016 W 88th Rd → (R) → 1st → (R)		DESIGN FLOW:	360	360	*THIS IMPROVEMENT PERMIT IS SUBJECT TO REVOCATION IF THE INTENDED USES CHANGE FROM THOSE SHOWN ON THE IMPROVEMENT PERMIT. CHANGES SHALL REQUIRE HEALTH DEPARTMENT APPROVAL.
		LTAR:	.30	.30	
SUBDIVISION: West of Meadow		ABSORPTION AREA:	1200 ft²	980 ft²	
LOT NUMBER: 18		TRENCH WIDTH:	36"	36"	
REFERENCE SKETCH (SEE PLAT FOR DETAILS) - Follow site sketch. - Do construction meeting to layout system. - Be careful clearing.		TRENCH DEPTH:	2' 30"	2' 1"	PERMIT VALID FOR: 5 YEARS YES ☒ NO ☐
		TRENCH SPACING:	9' on center	9' on center	
		TOTAL TRENCH LENGTH:	400 ft	300 ft	
		NUMBER OF TRENCHES:	4-100 ft		
		GRAVEL DEPTH:	12"	Adopted	
		TANK SIZE:	1000 gal		
		PUMP TANK SIZE:	N/A		
	DISTRIBUTION DEVICE:	Distribution Box			NO EXPIRATION YES ☒ NO ☐

IMPROVEMENT PERMIT

DATE: 10-23-08

FOR: Downey Homes

ISSUED BY: Cassarachi, Champion BS - "Cass"

CONSTRUCTION AUTHORIZATION FOR IMPROVEMENT PERMIT# 6852

Unless otherwise indicated, the same conditions above apply regarding system type, layout, location and installation requirements.
(The wastewater system cannot be installed until authorization is signed)

Comments: Follow site sketch

Date: 10-23-08 Environmental Health Specialist: Cassarachi, Champion BS

Construction Authorization Addendum ☐ Yes ☒ No

OPERATION PERMIT

DATE: 6-15-10

SYSTEM INSTALLED BY: Blackley

ISSUED BY: Cassarachi, Champion BS

PERFORMANCE, MONITORING, MAINTENANCE AND OPERATION
AS REQUIRED BY RULE .1961