

FRANKLIN COUNTY HEALTH DEPARTMENT

PERMIT NUMBER: 17339C CONST IMPROVE PERMIT	DATE: 20030502	1832-76-6114	SIZE: 0.750A
APPLICANT: GEORGETOWN WOODS LLC 118 NORTHBEND DR YOUNGSVILLE NC 27596		OWNER: GEORGETOWN WOODS	
TELEPHONE: SFD	201-4027		
COMMENT: SFD	DESCRIPTION: 5 YEAR	☒	LIFETIME: ☐
LOCATION/DIRECTIONS: SILO GLEN #13 -120 BARNHILL LANE WF			
FEE: 225.00		SIGNATURE OR OWNER OR AUTHORIZED AGENT:	

THE ABOVE SIGNATURE INDICATES THAT I HAVE READ, UNDERSTAND, AND AGREE WITH ALL PROVISIONS AND INFORMATION AS OUTLINED ON THE BACK SIDE OF THIS FORM


TOPO <u>PS</u>	TEXTURE <u>PS</u>	STRUCTURE <u>PS</u>	DEPTH <u>PS</u>
R. HOR <u>PS</u>	SOIL. WET <u>PS</u>	AVAIL. SP <u>PS</u>	OTHER
MINRL <u>PS</u>	OVERALL <u>PS</u>	LTAR <u>29.3</u>	
#BEDRMS <u>3</u>	GPD <u>480360</u>	DISPOSAL <u>310'</u>	TYPE. SYS <u>Env</u>
SZ. TANK <u>1000</u>	SZ. CHAMB	NITRIFI <u>3'X550</u>	TYPE. WAT <u>Public</u>
SITE. LOC	MAX TRENCH DEP <u>28"</u>	TYP. FAC <u>SFD</u>	
REMARKS: <u>*CA Signed ONCE HOME LOCATION IS Determined</u>			

CONTRACTOR: Mike Brown

TANK MANUF: 711/51/00

MANUF DATE: 3/18/05

I Q4 - 300'

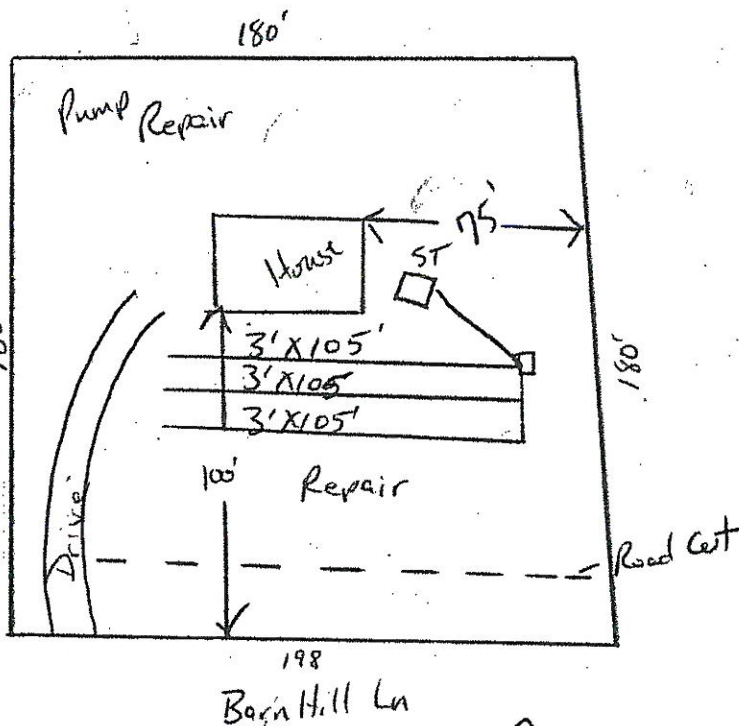

IMPROVEMENT PERMIT DATE: 5/5/03

CONSTRUCTION AUTHORIZATION DATE: 9-7-05

OPERATION PERMIT DATE: 12/30/05

ENV HEALTH SPEC: Andy Smith

ENV HEALTH SPEC: Shad Gansel

ENV HEALTH SPEC: Jeffery