

9194968136

11:50:17 p.m. 06-09-2014

1/2

88-2-1183

Franklin County Health Department
Division of Environmental Health
107 Industrial Drive-Suite C
Louisburg, North Carolina 27549

PAGE 1 OF 2

Phone: 919-496-8100

SEPTIC PERMIT

Fax: 919-496-8136

Permit Number: 7513 Type: I PIN: 2801-02-5156 Date: 5/13/2014

Applicant: CHAD BALL CONSTRUCTION Owner:
106 SPRING CT
YOUNGSVILLE, NC 27596

Telephone: (919) 669-5972 Telephone:

Subdivision: BISHOPS RIDGE Lot Number: 47 Size:

Physical Address/ Location /Directions 120 DUNHILL LN

Description: LifeTime _____ 5 Year XTYPE FACIL Res # EMPLOY _____ # BEDRMS 3 GPD 360 LTAR 325TYPE WAT com TYPE SYS Ac TYPE REP Ac BSMT N/A BST FX N/ASIZE TANK 1000 SIZE CHB N/A SIZE NITR 276 MTD 24COMMENTS: 276 ft septic line needed pump to back of lot.

Septic Contractors are responsible for notifying the health department for final inspections, between 8:00-9:00 AM on the day of completion, Monday - Friday. Any request for final inspections received afterwards will be scheduled the same day, if possible, or the next workday. Have permit number and owner/applicant's name ready when making the call.

Actions of representatives of state or local agencies engaged in the evaluation and determination of measures required to effect the compliance with the provisions of this permit shall in no way be taken as a guarantee that wastewater disposal systems permitted and approved will function in a satisfactory manner for any given period of time, or that such employees assume any liability for damages, consequential or direct which are caused, or may be caused, by a malfunction of this wastewater treatment and disposal system.

Proper precautions must be taken to assure the proper functioning of the system after it has been covered. Do not run any heavy equipment over the system, as soft earth will allow damage to the tank and lines. Pipe all roof drains away from the septic system site to prevent flooding of the lines from surface water. Terrace the ground to prevent excessive drainage from higher areas adjacent to the system. Do not construct driveways over any part of the septic system unless proper provisions were made when the septic system was constructed. Only grass, not trees or shrubbery, should be cultivated over the lines. All plumbing fixtures should be carefully inspected periodically and any problems repaired immediately. All septic tanks should be pumped off by a permitted pump operator on a regular schedule, not to exceed every five years.

The improvement permit and construction authorization is a site approval, for the future installation of a wastewater treatment and disposal system. Changes in ownership of the site do not affect the validity of this permit. However, any alteration of the site or soil conditions, changes in the location of the proposed facility, changes to the wastewater flow and/or characteristics, or submittal of false information with the application or misrepresentation of the property lines may subject this permit to suspension or revocation.

FOR THIS TO BE A VALID CONSTRUCTION AUTHORIZATION, A LAYOUT SHEET MUST BE ATTACHED

IMPROVEMENT PERMIT DATE 5/27/14 EHS [Signature]
 CONSTRUCTION AUTHORIZATION DATE 5/27/14 EHS [Signature]

Visit www.franklincountyenvironmentalhealth.com for permit information and tracking.

DS
MM

Franklin County Health Department


Name: CHAD BALL CONST

Permit Number

7513

CONTRACTOR _____ TANK MANU _____ MANU DATE _____

WELL INSTALLED YES _____ NO _____ SYSTEM CODE _____

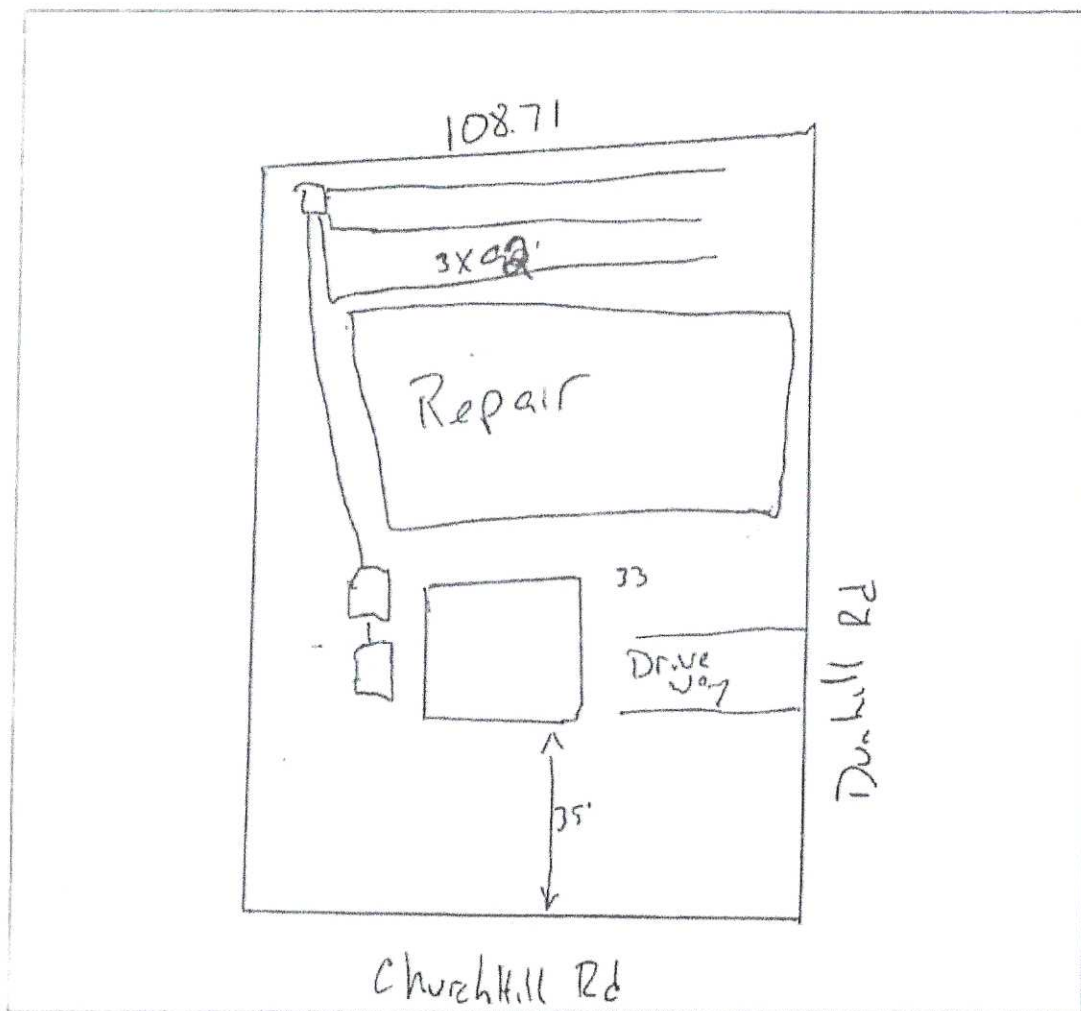SEPTIC SYSTEM LAYOUT
(SKETCH SYSTEM LAYOUT HERE)**SEPTIC SYSTEM AS-BUILT**
(IF DIFFERENT FROM INITIAL LAYOUT)
ON REVERSE

OPERATIONS PERMIT

DATE _____ EHS _____

DS
MM

PRELIMINARY PLOT PLAN FOR
CHAD BALL CONSTRUCTION, LLC.

LOT 47, BISHOPS RIDGE

120 DUNHILL LANE

REF: B.M. 2006, PAGE 151


HARRIS TOWNSHIP

FRANKLIN COUNTY, NORTH CAROLINA


MAY 12, 2014

REVISED JULY 25, 2014


ZONED R-30

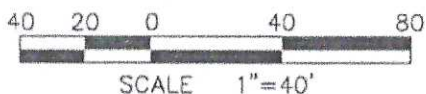

CHURCHILL ROAD 50' PUBLIC R/W

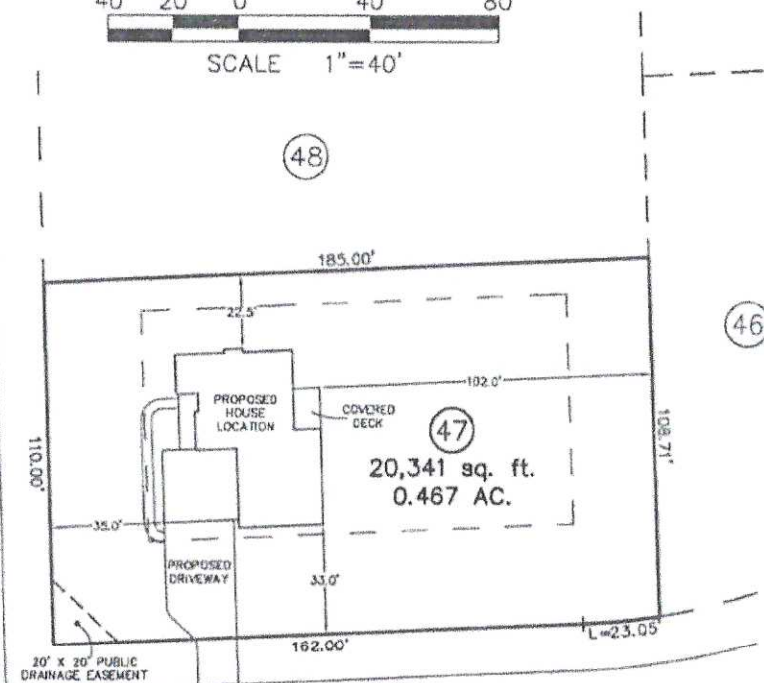

THIS SURVEYOR DOES NOT
WARRANTY THE ACCURACY
OF ARCHITECTURAL DIMENSIONS.
THEY ARE TO BE VERIFIED BY
THE CONTRACTOR.

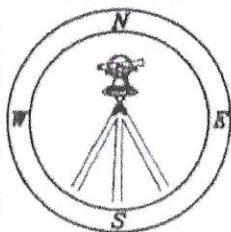

**CAWTHORNE, MOSS
& PANCIERA, P.C.**

Professional Land Surveyors
C-1525

333 S. White Street
Post Office Box 1253
Wake Forest, N.C. 27588
(919)556-3148

NOTES:

-THIS PLAN DOES NOT REFLECT AN
ACTUAL SURVEY. IT IS A PRELIMINARY
PLAN AND SHOULD BE USED FOR ITS
INTENDED PURPOSE ONLY.
-NOT FOR RECORDATION, CONVEYANCES,
OR SALES.

DS

mm