



Lake Royale

LAKE ROYALE CAMPING PERMIT

THIS PERMIT MUST BE CONSPICUOUSLY POSTED ON
YOUR CAMPER WINDOW OR AVAILABLE FOR
EXAMINATION.

Know by all these presents that Sterling Hunt
_____, who owns lot number 564-C, has been
issued a permit to situate a SEPTIC TANK
on lot number 564-C.

Said SEPTIC TANK has been
inspected by the undersigned and is in compliance with applicable
rules, regulations and restrictions for camper lots at Lake Royale.

Said permit shall expire on December 10, 1988.

Issued this 10th day of October, 1988 at Lake
Royale, Bunn, North Carolina.

LAKE ROYALE PROPERTY OWNERS ASSOC.

By: Michael R. Warren

5:30

FRANKLIN COUNTY HEALTH DEPARTMENT

IMPROVEMENTS PERMIT AND CERTIFICATE OF COMPLETION

126706

Date 9-14-88

 Owner Stirling Hunt
 Location Lake Royale # 564-C
☒ Septic Tank ☐ Repair ☐ Home ☐ New
☐ Privy ☐ Electric Svc. ☒ Mobile Home ☐ Business

☒ Garbage Disposal ☐ Dishwasher ☐ Washing Machine
 No. Bedrooms 2
 No. Bathrooms 1
 No. Persons -

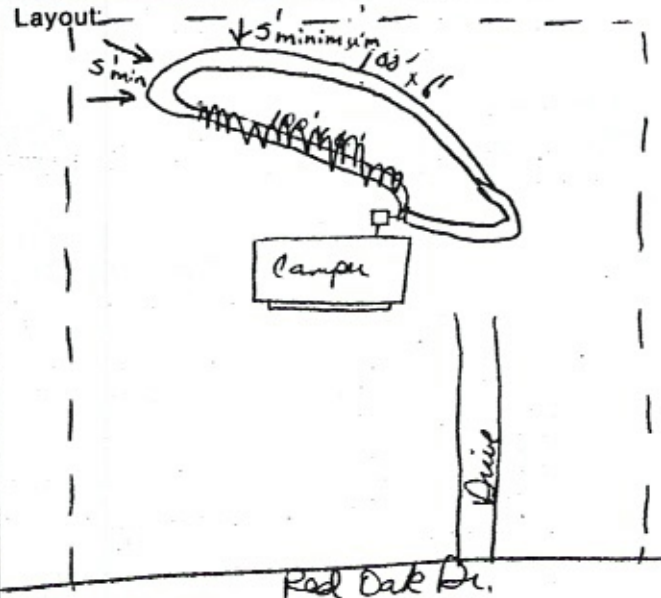
 Size of Tank 1800 gal Area of Nit. Field 600 ft²
 Total Length of Lines 500' No. of Lines 2
 Trench Width 6' Depth of Stone 12"

 Water Supply: ☐ Private ☒ Community

 Basement ☐ Yes ☒ No
 Fixtures ☐ Yes ☒ No

 Comments Keep system shallow, stay
5' from property lines.

 Imp. Permit Terry O. Chappell R.S.
 Cert. of Comp. May Bright, R.S.
 Contractor J. Layton Date 10-7-88

 Lot Size: 60X100 Township: _____


Fee _____

*PERMIT EXPIRES THREE YEARS FROM ISSUE DATE *PERMIT VOID IF LAYOUT IS ALTERED WITHOUT APPROVAL FROM FCHD