

Franklin County Health Department  
Environmental Health Section  
107 Industrial Drive-Suite C  
Louisburg, North Carolina 27549

PAGE 1 OF 2

Phone: 919-496-8100

Fax: 919-496-8136

Permit Number: 2213      Type: I      PIN :      1867-33-2786      Date:      1/13/2006  
Applicant: AFFORDABLE HOMES      Owner: TARHEEL LAND COMPANY  
1906 S MAIN ST      112 NEW COLLEGE ST  
WAKE FOREST, NC 27587      OXFORD, NC 27565  
Telephone: (919) 562-7773      Telephone:  
Subdivision: KENDAL FOREST      Lot Number: 11      Size: 0.680

Physical Address/ Location /Directions 115 CORNERSTONE DR

Description: LifeTime      5 Year ☒

TYPE FACIL RES # EMPLOY        # BEDRMS 3 GPD 360 LTAR .3  
TYPE WAT County TYPE SYS Accepted TYPE REP P to Accept BSMT No BST FX N/A  
SIZE TANK 900 SIZE CHB N/A SIZE NITR 3'X300' MTD 18"

COMMENTS Maintain setbacks. Install drain lines on contour. Do not  
exceed max. trench depth.

Septic Contractors are responsible for notifying the health department for final inspections, between 8:00-9:00 AM on the day of completion, Monday - Friday. Any request for final inspections received afterwards will be scheduled the same day, if possible, or the next workday. Have permit number and owner/applicant's name ready when making the call.

Actions of representatives of state or local agencies engaged in the evaluation and determination of measures required to effect the compliance with the provisions of this permit shall in no way be taken as a guarantee that wastewater disposal systems permitted and approved will function in a satisfactory manner for any given period of time, or that such employees assume any liability for damages, consequential or direct which are caused, or may be caused, by a malfunction of this wastewater treatment and disposal system.

Proper precautions must be taken to assure the proper functioning of the system after it has been covered. Do not run any heavy equipment over the system, as soft earth will allow damage to the tank and lines. Pipe all roof drains away from the septic system site to prevent flooding of the lines from surface water. Terrace the ground to prevent excessive drainage from higher areas adjacent to the system. Do not construct driveways over any part of the septic system unless proper provisions were made when the septic system was constructed. Only grass, not trees or shrubbery, should be cultivated over the lines. All plumbing fixtures should be carefully inspected periodically and any problems repaired immediately. All septic tanks should be pumped off by a permitted pump operator on a regular schedule, not to exceed every five years.

The improvement permit and construction authorization is a site approval, for the future installation of a wastewater treatment and disposal system. Changes in ownership of the site do not affect the validity of this permit. However, any alteration of the site or soil conditions, changes in the location of the proposed facility, changes to the wastewater flow and/or characteristics, or submittal of false information with the application or misrepresentation of the property lines may subject this permit to suspension or revocation.

FOR THIS TO BE A VALID CONSTRUCTION AUTHORIZATION, A LAYOUT SHEET MUST BE  
ATTACHED

IMPROVEMENT PERMIT

DATE

1/24/06

EHS

CONSTRUCTION AUTHORIZATION

DATE

1/24/06

EHS

*Shad Feenore*  
*Shad Feenore*

# Franklin County Health Department

Name: AFFORDABLE HOM

Permit Number


2213

CONTRACTOR Quality Landscapes TANK MANU Mills 1000 MANU DATE 1-17-06WELL INSTALLED YES ☐ NO ☐ SYSTEM CODE 

## SEPTIC SYSTEM LAYOUT

(SKETCH SYSTEM LAYOUT HERE)

- Drawing not to scale
- Stay 50' from Creek

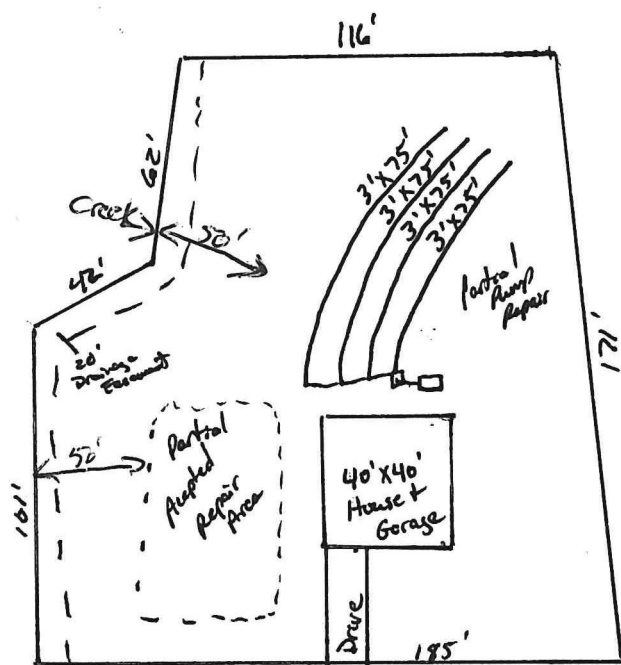

Cornerstone Dr.

## SEPTIC SYSTEM AS-BUILT

(IF DIFFERENT FROM INITIAL LAYOUT)

ON REVERSE

OPERATIONS PERMIT

DATE

3-20-06

EHS