

GRANVILLE-VANCE HEALTH DEPARTMENT—Sewage Disposal Record

Owner or Contractor Shane Mitchell/Wynn Const. Date 1-5-01 S.R. No. 1200
Location/Address Wes Sandling Road off Grove Hill Rd Franklin County
Subdivision/Mobile Home Park Name Stonefield Lot Size 1.2 acres
Permit No. # 2653 Lot No. 12

New System ☒ Repair _____
House ☒ Mobile Home _____ Business _____
No. Bedrooms 3 No. People _____ No. Toilets _____
Water Supply: Private ☒ Approved _____
Semi-Public _____ Unapproved _____
Public _____ None _____

Nitrification System:

Tank Size 1000 gal.
Distribution Box ☒ No. Lines 4
Nitrification Field 1200 Sq. Ft.
Lines:


	1	2	3	4	5	6
Width	<u>3'</u>	<u>3'</u>	<u>3'</u>	<u>3'</u>		
Length	<u>100'</u>	<u>100'</u>	<u>100'</u>	<u>100'</u>		
Grade	<u>0"</u>	<u>0"</u>	<u>0"</u>	<u>0"</u>		
Stone Depth	<u>12"</u>	<u>12"</u>	<u>12"</u>	<u>12"</u>		

Layout to be followed by installer:

Improvements Permit By Jimmy Clayton Installer Robert Blackley
Certificate of Completion By Eddie Yount Date of Inspection 1-5-01

* Construction must comply with all other applicable state and local regulations, but the permit is not a guarantee that the system will not malfunction and the Granville-Vance Health District will not be held responsible for a malfunctioning system.

NOTE: Make sketch of installation showing location of house, septic tanks, privies, water supplies on adjacent property, etc. Write in measurements in order that installations may be located at later date.

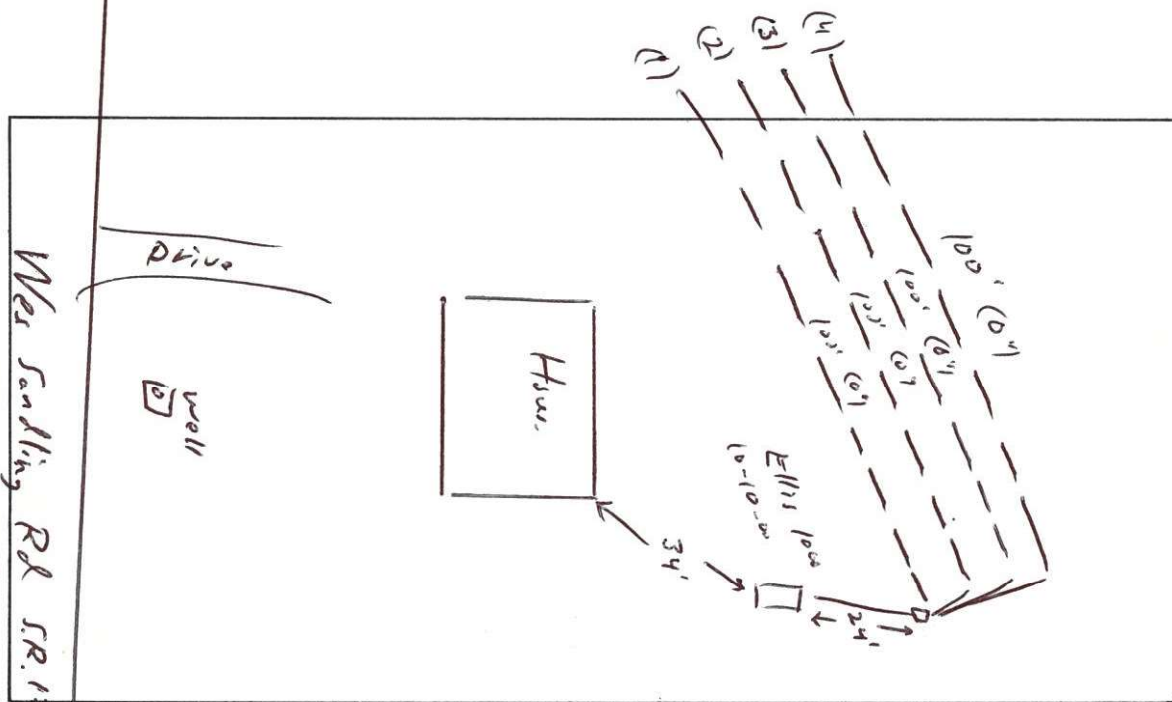

Wes Sandling Rd S.R. 1800

Franklin County

Grove Hill Road

S.R. 1625