

Granville - Vance District Health Department
Environmental Health

Final Sketch

Pin _____

____ Improvement Permit

☒ Construction Authorization

SUZANNE TEMPLE

Permit No. 8888

FIELSTONE WEST 67

Applicant's Name

Subdivision - Section - Lot

Physical Address: 509 BELMONT CIRCLE


TRUE WORKS

System Installer

5-4-17

Date

System design and details as installed.

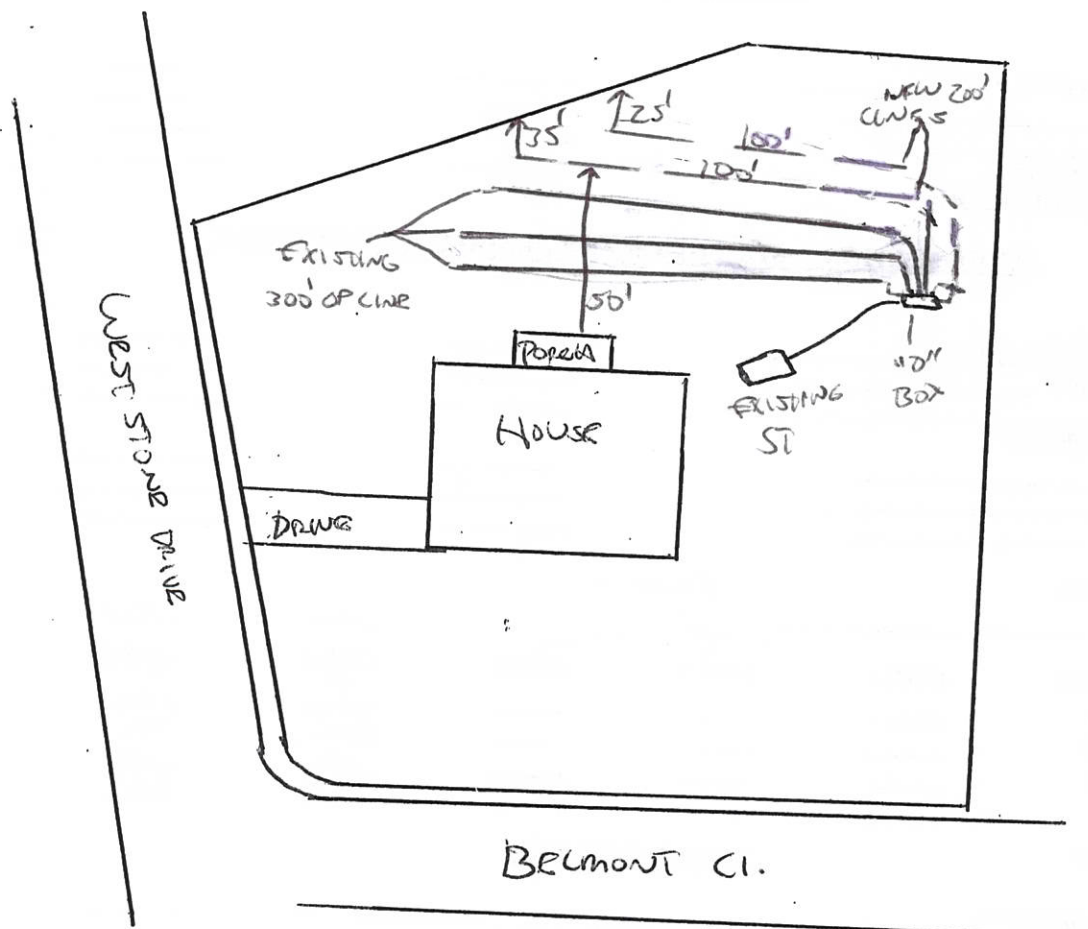

[Signature]

Authorized Signature

5-4-17

Date

SEWAGE DISPOSAL SYSTEM INSTALLATION REVIEW

SEPTIC AND PUMP TANK INSPECTION

SEPTIC TANK	INITIAL	DATE
Manufacturer <u>EXISTING</u>	_____	_____
Date of Manufacture _____	_____	_____
Stamp _____	_____	_____
Capacity _____	_____	_____
Tee _____	_____	_____
Baffle _____	_____	_____
Sealant _____	_____	_____
AIR GAP _____, FILTER _____, RISER _____	_____	_____

PUMP TANK		
Manufacture _____	_____	_____
Date of Manufacture _____	_____	_____
Stamp _____	_____	_____
Capacity _____	_____	_____
Sealant _____	_____	_____
Manhole _____	_____	_____
RISER _____, SEALANT _____	_____	_____

MECHANICAL INSPECTION

PUMP		
Manufacturer and Model # _____	_____	_____
Control Panel _____	_____	_____
Alarm _____	_____	_____
Electrical Connection _____	_____	_____
SEALANT AROUND CONDUIT _____	_____	_____

NITRIFICATION/DISTRIBUTION AND DRAINFIELD INSPECTION

DISTRIBUTION BOX		
Level <u>EXISTING</u>	_____	_____
Equal Distribution _____	_____	_____
Other _____	_____	_____
DISTRIBUTION MANIFOLD		
Pipe Size _____	_____	_____
Gate Valves _____	_____	_____
Other _____	_____	_____

OTHER DISTRIBUTION	EXISTING					
Type _____	LINE 1	LINE 2	LINE 3	NEW LINE 4	NEW LINE 5	LINE 6
NITRIFICATION LINES						
Trench Width	_____	_____	_____	3'	3'	_____
Trench Length	_____	_____	_____	100'	100'	_____
Trench Grade	_____	_____	_____	26"	26"	_____
Stone Depth	_____	_____	_____	_____	_____	_____

POLYSTYRENE

WELL INSPECTION

LOCATION OF WELL _____

COMMENTS: _____

GRANVILLE-VANCE HEALTH DEPARTMENT—Sewage Disposal Record

Owner or Contractor Oakview Homes Date 2-27-07 S.R. No. 1717
 Location/Address West Stone Drive + Belmont Circle off Woodland Church Rd
 Subdivision/Mobile Home Park Name Fieldstone West Lot Size 98 acres
 Permit No. # 05286 Lot No. 67

New System ☒ Repair _____
 House ☒ Mobile Home _____ Business _____
 No. Bedrooms 3 No. People _____ No. Toilets _____
 Water Supply: Private ☒ Approved _____
 Semi-Public _____ Unapproved _____
 Public _____ None _____

Layout to be followed by installer:


Nitrification System:
 Tank Size 1000 gal. No. Lines 3
 Distribution Box ☒ No. Lines _____
 Nitrification Field 1200 Sq. Ft.
 Lines: 1 2 3 4 5 6
 Width 3' 3' 3' _____
 Length 100' 100' 100' _____
 Grade 0' 0' 0' _____
 Stone Depth 10 10 10 _____

EZ Flow units

Improvements Permit By Eddie Yount Installer David Brantley & Son
 Certificate of Completion By Eddie Yount Date of Inspection 2-27-07

* Construction must comply with all other applicable state and local regulations, but the permit is not a guarantee that the system will not malfunction and the Granville-Vance Health District will not be held responsible for a malfunctioning system.

NOTE: Make sketch of installation showing location of house, septic tanks, privies, water supplies on adjacent property, etc. Write in measurements in order that installations may be located at later date.

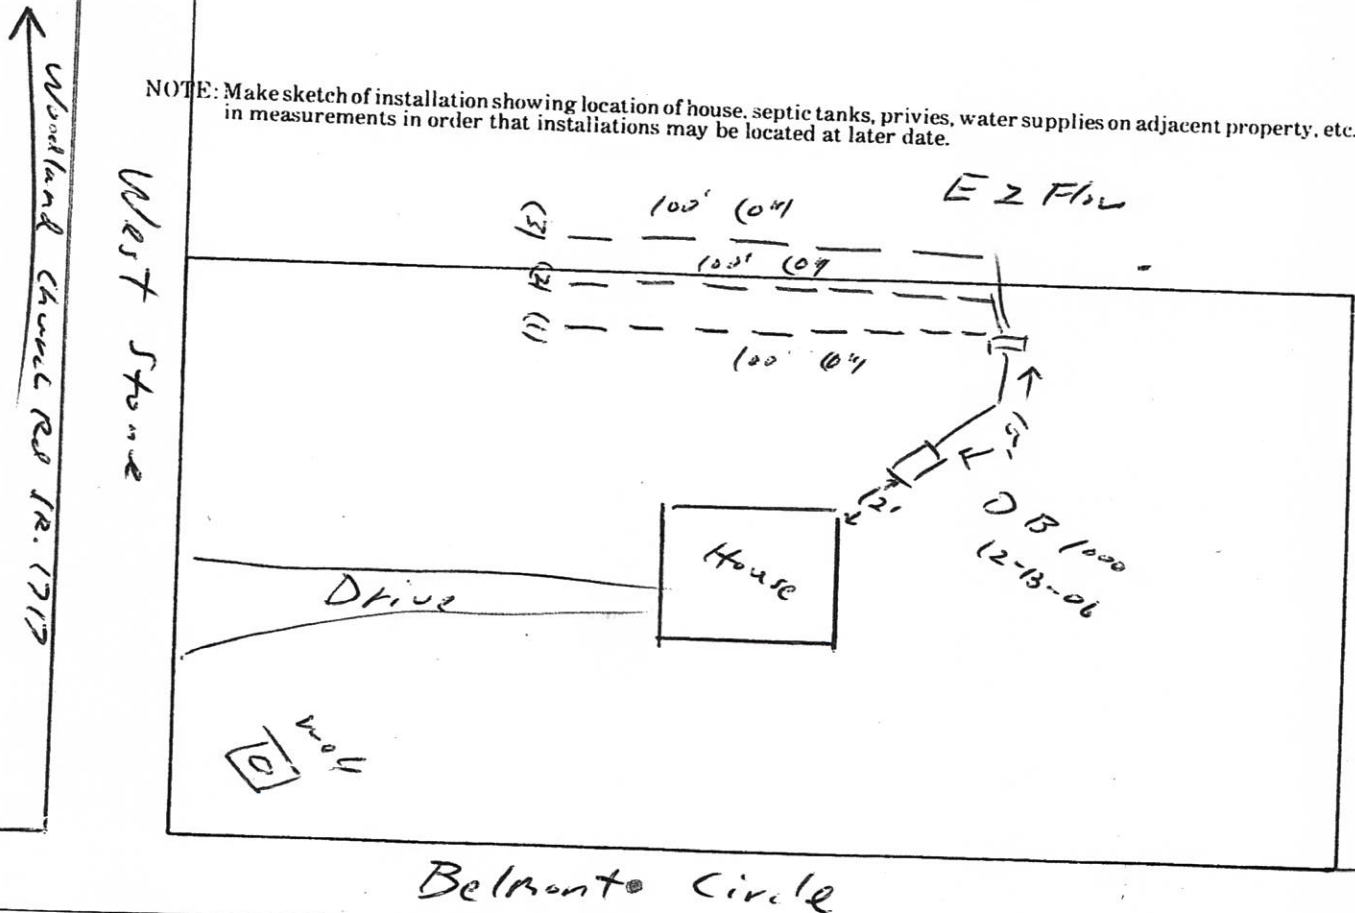

REPAIR

PERMIT NUMBER 8888

GRANVILLE-VANCE DISTRICT HEALTH DEPARTMENT IMPROVEMENT AND OPERATION PERMITS

COUNTY:	TAX NO.	TYPE OF ESTABLISHMENTS			*THIS PERMIT SHALL BE ACCOMPANIED BY A LAYOUT SHOWN ON A PLAT, INCLUDING SYSTEM REQUIREMENTS.
APPLICANT: SUZANNE TEMPLE	SR. NO.	RESIDENCE ☒ BUSINESS ☐ OTHER ☐	NUMBER OF BEDROOMS:	NUMBER OF OCCUPANTS:	
	APPLICANT'S NAME & ADDRESS: 509 BELMONT CIRCLE WAKE FOREST, NC 27587	WATER SUPPLY EXISTING	WELL ☐ PUBLIC ☐	OTHER ☐	
	PROPERTY ADDRESS/LOCATION: 509 BELMONT CIRCLE	TYPE OF WASTEWATER SYSTEM	INITIAL INSTALLATION	REPAIR	
SUBDIVISION: FIELDSTONE WEST	LOT NUMBER: 67	DESIGN FLOW:			*THIS IMPROVEMENT PERMIT IS SUBJECT TO REVOCATION IF THE INTENDED USES CHANGE FROM THOSE SHOWN ON THE IMPROVEMENT PERMIT. CHANGES SHALL REQUIRE HEALTH DEPARTMENT APPROVAL.
		LTAR:			
		ABSORPTION AREA:			
		TRENCH WIDTH:		36"	
REFERENCE SKETCH (SEE PLAT FOR DETAILS) - PUT IN 200' OF ACCEPTED PRODUCT TO EXISTING (3) 100' LINES - STAY MINIMUM 10' OFF CURB LINE - HAVE TRENCHES 9' ON CENTER - MINIMUM 50' FROM ALL WELLS, DIVERS, CREEKS, + PONDS - REPLACE "D" BOX OR TANK (IF NEEDED)		TRENCH DEPTH:		18-20"	
		TRENCH SPACING:		9' O.C.	
		TOTAL TRENCH LENGTH:		200' ACCEPTED	
		NUMBER OF TRENCHES:		2 OR 3	
		GRAVEL DEPTH:		ACCEPTED	
		TANK SIZE:		EXISTING	
		PUMP TANK SIZE:			
		DISTRIBUTION DEVICE:		"D" BOX	PERMIT VALID FOR: 5 YEARS YES ☒ NO ☐
					NO EXPIRATION YES ☐ NO ☒

IMPROVEMENT PERMIT

DATE: 2-20-17

FOR: SUZANNE TEMPLE

ISSUED BY: Will Paul

CONSTRUCTION AUTHORIZATION FOR IMPROVEMENT PERMIT# 8888

Unless otherwise indicated, the same conditions above apply regarding system type, layout, location and installation requirements.
(The wastewater system cannot be installed until authorization is signed)

Comments: CONTRACTOR TO ESTABLISH & FOLLOW CONTOUR!

Date: 2-20-17 Environmental Health Specialist: Will Paul

Construction Authorization Addendum ☐ Yes ☒ No

OPERATION PERMIT

DATE: 5-4-17

SYSTEM INSTALLED BY: TRUE WORKS

ISSUED BY: Will Paul

PERFORMANCE, MONITORING, MAINTENANCE AND OPERATION
AS REQUIRED BY RULE .1961