

Granville - Vance District Health Department
Environmental Health

Pin 183500261043

Permit Number 7560

☒ Improvement Permit

☒ Construction Authorization

Final Sketch

William Howerton

Applicants Name

#1A

Subdivision - Section - Lot

Physical Address: 1641 Hwy 96 South

Triangle Pump & Tank
System Installer

9-12-13-2013
Date

System design and details as installed.

Septic Tank Information:

Date: 6-27-13
Manufacture: Mills-1200
ID #: 5TB-857

Pump Tank Information:

Date: _____
Manufacturer: _____
ID #: _____


Distribution Box ☒
Pressure Manifold _____
Serial Distribution _____

* Not to scale

Type of Facility: House

Number of Bedrooms: 4

Type of System: gravity → Chambers
(Type IIIg)

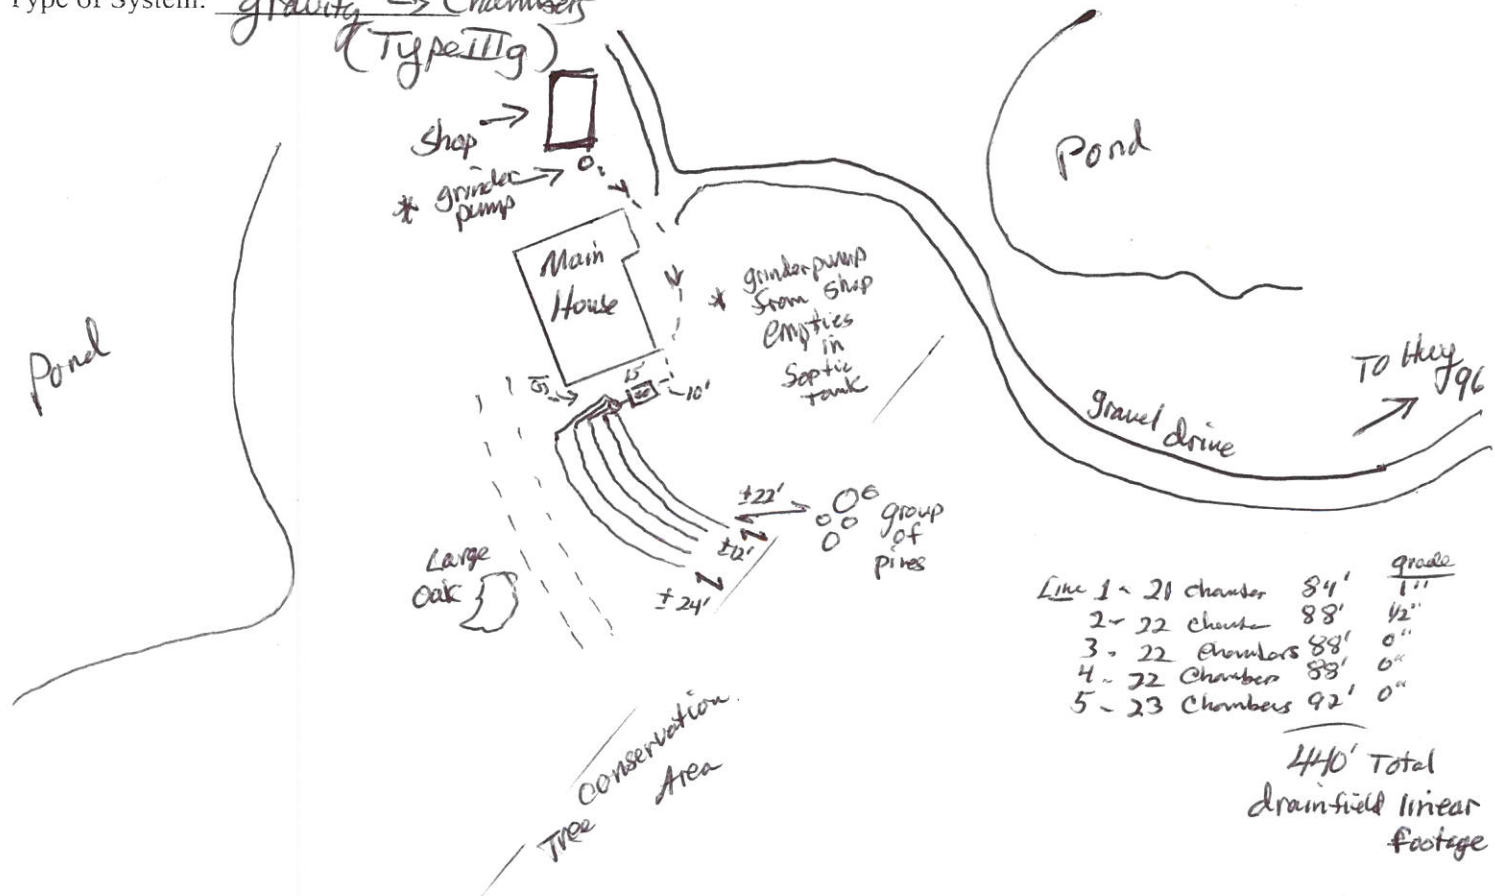

David Carr
Authorized Signature

9-13-13
Date

PERMIT NUMBER

07560

GRANVILLE-VANCE DISTRICT HEALTH DEPARTMENT IMPROVEMENT AND OPERATION PERMITS

Zoning #
17768

COUNTY:	TAX NO.	TYPE OF ESTABLISHMENTS			*THIS PERMIT SHALL BE ACCOMPANIED BY A LAYOUT SHOWN ON A PLAT, INCLUDING SYSTEM REQUIREMENTS.
OWNER:	SR. NO.	RESIDENCE ☒	NUMBER OF BEDROOMS:	NUMBER OF OCCUPANTS:	
	APPLICANT'S ADDRESS:	BUSINESS ☐	WELL ☒ Existing Well	OTHER ☐	
		OTHER ☐			
PROPERTY ADDRESS/LOCATION:	TYPE OF WASTEWATER SYSTEM	INITIAL INSTALLATION	REPAIR		*THIS IMPROVEMENT PERMIT IS SUBJECT TO REVOCATION IF THE INTENDED USES CHANGE FROM THOSE SHOWN ON THE IMPROVEMENT PERMIT. CHANGES SHALL REQUIRE HEALTH DEPARTMENT APPROVAL.
SUBDIVISION:	DESIGN FLOW:				
LOT NUMBER:	LTAR:				
REFERENCE SKETCH (SEE PLAT FOR DETAILS)	ABSORPTION AREA:				
	TRENCH WIDTH:				
	TRENCH DEPTH:				
	TRENCH SPACING:				
	TOTAL TRENCH LENGTH:			PERMIT VALID FOR: 5 YEARS YES ☒ NO ☐	
	NUMBER OF TRENCHES:				
	GRAVEL DEPTH:			NO EXPIRATION YES ☒ NO ☐	
	TANK SIZE:				
	PUMP TANK SIZE:				
	DISTRIBUTION DEVICE:				

IMPROVEMENT PERMIT

DATE:

FOR:

ISSUED BY:

CONSTRUCTION AUTHORIZATION FOR IMPROVEMENT PERMIT#

Unless otherwise indicated, the same conditions above apply regarding system type, layout, location and installation requirements.

(The wastewater system cannot be installed until authorization is signed)

Comments:

Date:

Environmental Health Specialist:

Construction Authorization Addendum

☐ Yes ☒ No

OPERATION PERMIT

DATE:

SYSTEM INSTALLED BY:

ISSUED BY:

PERFORMANCE, MONITORING, MAINTENANCE AND OPERATION
AS REQUIRED BY RULE .1961