

GRANVILLE VANCE

public health

Existing System Approval

Granville County Health Department
Environmental Health Section
Environmental Health
Oxford, NC 27565
Phone: (252) 492-5263 Fax: (252) 492-2361

For Office Use Only

*CDP File Number:
450446

County ID Number:

Evaluated For:
EXISTING

Permit Valid Until: 03/12/2025

Applicant: NATHAN APEL
Address: 923 WEATHERBY LANE
City: CREEDMOOR
State/Zip: NC / 27522
Phone #: (724) 989-1700

Property Owner: NATHAN APEL
Address: 923 WEATHERBY LANE
City: CREEDMOOR
State/Zip: NC / 27522
Phone #: (724) 989-1700

Property Location & Site Information

Address: 923 WEATHERBY LANE Subdivision: WEATHERBY Phase: Lot: 15
Road#: CREEDMOOR NC 27522 Township:
*Structure: SINGLE FAMILY
of Bedrooms: # of People: Directions: GPS
OFF BRUCE GARNER ROAD
*Water Supply: EXISTING WELL Type of business:
Basement: ☐ Yes ☒ No Total sq. Footage: No. Of Employees:

*Proposed Improvement: 10 X 10 ACCESSORY STRUCTURE FOR PERSONAL STORAGE

*Release Conditions: Keep proposed storage building 5ft min. from any part of the septic. Only deliver building during a dry time, due to having to drive over the drain Feild.

This release in no way expresses or implies that the existing subsurface sewage treatment and disposal system serving the site will continue to function for any period of time.

Applicant/Legal Reps. Signature Required? ☐ Yes ☐ No

Applicant/Legal Reps. Signature: Date:

*Issued By: Wilkerson, Austin *Date of Issue: 03/12/2025

Authorized State Agent: Adam Wilkerson REHS

****Site Plan/Drawing attached.****

Total Time: (HH:MM)

NO
Drawing

☐ Hand Drawing

☐ Import Drawing

Hours Minutes

Activity Code: -

Granville - Vance District Health Department
Environmental Health

Pin _____

Permit Number 323892

Final Sketch

661 Homes
Applicants Name

Weatherby 15
Subdivision - Section - Lot

Physical Address: 923 Weatherby Ln.


Number of Bedrooms 3

Quality Septic
System Installer

3-9-21
Date

(3) 110' lines
Chambers

= 330' total

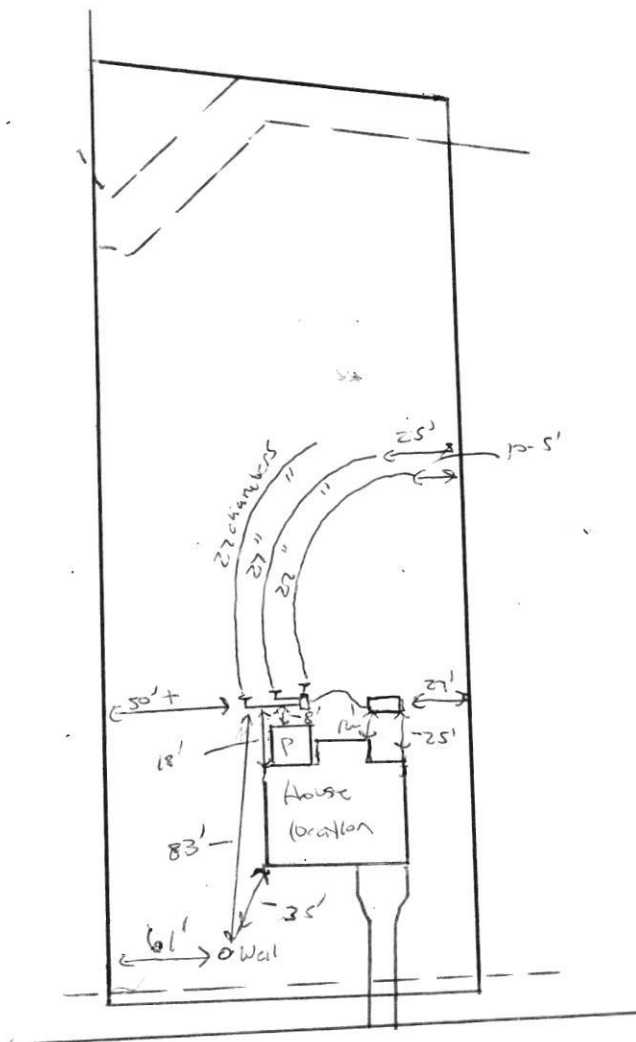

[Signature]

Authorized Signature

Weatherby Ln.

3-9-21

Date

SEWAGE DISPOSAL SYSTEM INSTALLATION REVIEW

SEPTIC AND PUMP TANK INSPECTION

SEPTIC TANK

Manufacturer Hills
 Date of Manufacture 11/6/21
 Stamp SB 858
 Capacity 1000
 Tee /
 Baffle /
 Sealant /
 AIR GAP /, FILTER /, RISER /

INITIAL

WTB
/
/
DATE

3-9-21
/
/
WF
 pump/well tag
 elc box
 spigot/
 w/ backflow
 12"
 vent
 holes
 sealed
 inspect

PUMP TANK

Manufacture _____
 Date of Manufacture _____
 Stamp _____
 Capacity _____
 Sealant _____
 Manhole _____
 RISER _____, SEALANT _____

MECHANICAL INSPECTION

PUMP

Manufacturer and Model # _____
 Control Panel _____
 Alarm _____
 Electrical Connection _____
 SEALANT AROUND CONDUIT _____

NITRIFICATION/DISTRIBUTION AND DRAINFIELD INSPECTION

DISTRIBUTION BOX

Level /
 Equal Distribution /
 Other _____

WTB
/
/
/

3-9-21
/
/
/

DISTRIBUTION MANIFOLD

Pipe Size _____
 Gate Valves _____
 Other _____

OTHER DISTRIBUTION

Type _____

NITRIFICATION LINES

Trench Width
 Trench Length
 Trench Grade
 Stone Depth

LINE 1

3'
110'
/
20"

LINE 2

3'
110'
/
20"

LINE 3

3'
110'
/
20"

LINE 4

LINE 5

LINE 6

Chambers

WELL INSPECTION

LOCATION OF WELL 83' to last line

WTB


3-9-21

COMMENTS:

N-G-I-DY

SCALE: 1" = 54.5 ft

TREE REMOVAL

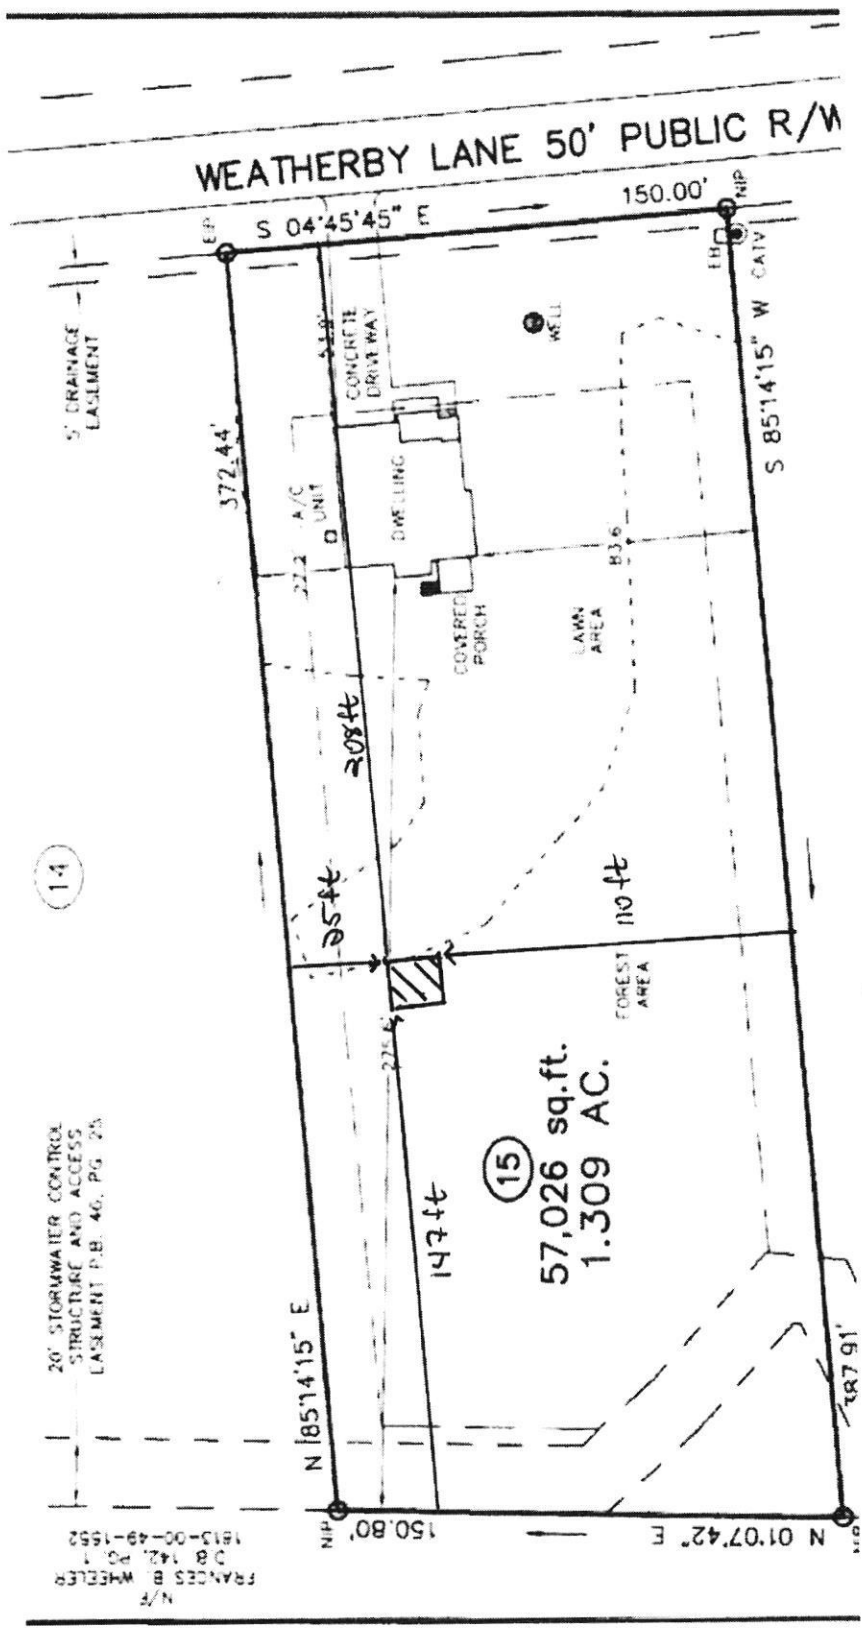

CLEAR TREES FROM MARKED AREA
235' SQFT OF FOREST AREA CLEARED. 154'X15'ft
DIMENSIONS SUPERCEDE DRAWING SCALE.



OPERATION PERMIT

Granville County Health Dept
Environmental Health
101 Hunt Drive
Oxford, NC 27565

Phone: (252) 492-5263 Fax: (252) 492-2361

For Office Use Only

*CDP File Number 323892 - 1
County ID Number: 181300487882
Evaluated For: NEW

Property Owner: LGI Homes

Address: 1450 Lake Robbins Drive
Road #: Suite 430

City:

State/Zip: /

Phone #: (252) 915-0741

Township:

Subdivision: Weatherby

Phase: NEW

Lot: 15

Structure: SINGLE FAMILY

of Bedrooms:

of People:

Water Supply: NEW WELL

Saprolite System?: ☐ Yes ☒ No

Pump Required?: ☐ Yes ☒ No

Design Flow: 360

System Classification/Description: TYPE III G. OTHER
NON-CONV. TRENCH SYSTEMS

Installer: Quality Septic

Certification #: 4530

Specific System CHAMBER

Installed:

STB: 858

PT:

Septic Tank Date: 01/06/2021

Pump Tank Date: _____

Comments: Installed (3) 110' lines (Chambers). 3 bedroom system.

This system has been installed in compliance with applicable NC General Statutes, Rules for Sewage Treatment and Disposal, and all conditions of the Improvement Permit and Construction Authorization.

PERMIT CONDITIONS:

I. Performance: System shall perform in accordance with Rule .1961.

II. Monitoring: As required by Rule .1961.

III. Maintenance: Ground absorption sewage treatment and disposal systems shall be checked, and the contents of the septic tank removed, periodically from all compartments, to ensure proper operation of the system. The contents shall be pumped whenever the solids level is found to be more than 1/3 of the liquid depth in any compartment.

Other:

Subsurface Operator Required: ☐ Yes ☒ No

If yes, see attached sheet for additional operation conditions, maintenance and reporting.

Operation:

Other: Installed (3) 110' lines (Chambers). 3 bedroom system.

Authorized State Agent: Bullock, Will

Date of Issue: 03/09/2021

Owner/Applicant:

LGI

Monitor Report

Date/Time: 04/14/2021 08:09 AM

Fax Number : 9196030106
Company Name : GV Environmental Health

The documents were sent.

No.	Job#	Remote Station	Start Time	Dura.	Pages	Mode	Contents	Result
001	0400	99196936794	04/14/2021 08:08AM	0'23"	2/ 2	SG3		Done



OPERATION PERMIT

Granville County Health Dept
Environmental Health
101 Hunt Drive
Oxford, NC 27565
Phone: (252) 492-5263 Fax: (252) 492-2361

For Office Use Only

*CDP File Number 323892 - 1
County ID Number: 181300487882
Evaluated For: NEW

Property Owner: LGI Homes

Address: 1450 Lake Robbins Drive
Road #: Suite 430

City:

State/Zip:

Phone #: (252) 915-0741

Township:

Subdivision: Weatherby

Phase: NEW

Lot: 15

Structure: SINGLE FAMILY

of Bedrooms:

of People:

Water Supply: NEW WELL

Saprolite System?: ☐ Yes ☒ No

Pump Required?: ☐ Yes ☒ No

Design Flow: 360

System Classification/Description: TYPE III G. OTHER
NON-CONV. TRENCH SYSTEMS

Installer: Quality Septic

Certification #: 4530

Specific System: CHAMBER

Installed:

Septic Tank Date: 01/08/2021

STB: 858

Pump Tank Date:

PT:

Comments: Installed (3) 110' lines (Chambers). 3 bedroom system.

This system has been installed in compliance with applicable NC General Statutes, Rules for Sewage Treatment and Disposal, and all conditions of the Improvement Permit and Construction Authorization.

PERMIT CONDITIONS:

I. Performance: System shall perform in accordance with Rule .1961.

II. Monitoring: As required by Rule .1961.

III. Maintenance: Ground absorption sewage treatment and disposal systems shall be checked, and the contents of the septic tank removed, periodically from all compartments, to ensure proper operation of the system. The contents shall be pumped whenever the solids level is found to be more than 1/3 of the liquid depth in any compartment.

Other:

Subsurface Operator Required: ☐ Yes ☒ No

If yes, see attached sheet for additional operation conditions, maintenance and reporting.

Operation:

Other: Installed (3) 110' lines (Chambers). 3 bedroom system.

Authorized State Agent: Bullock, Will *W. Bullock*

Date of Issue: 03/09/2021

Owner/Applicant: *LCI*

The Fax Transmit prints each time when the documents are sent or unsent. To turn off this page:

- 1.) At the printer's control panel, press "Machine Status"
- 2.) At the LCD Panel, press the "Tools" tab and then press "Admin Settings..."
- 3.) Press "Fax Settings..." and then press "Fax Reports..."
- 4.) Press "Fax Transmit" and set the setting to "Print Disable"

Page:1(Last Page)

*File #: 323894 - 1
PIN #: 181300487882
Tax Lot #: 15
Tax Block #:

WELL CONSTRUCTION RECORD

Owner: LGI Homes
1450 Lake Robbins Drive
Suite 430

Directions

Right off Bruce Garner Rd

Weatherly lot 15

Drilling Contractor: Southern Well Drilling

Driller Registration: 4165

Date Drilled: 01/18/2021

Use of Well: SINGLE FAMILY

Total Depth: 500 Ft.

Static Water Level: Ft.

Replacement Well: NO

Yield: 1 gpm

Water Zone: 1) Ft. 2) Ft.
3) Ft. 4) Ft.

Disinfection Type: GRANULAR Amount: 16oz

WELL HEAD CONSTRUCTION

Location:

Latitude:

Longitude:

Enclosure	☒ Yes	☐ No	☐ N/A
Enclosure Floor	☐ Yes	☐ No	☒ N/A
Access Port	☒ Yes	☐ No	☐ N/A
Vent:	☒ Yes	☐ No	☐ N/A
Sample Tap	☒ Yes	☐ No	☐ N/A
Back Flow	☒ Yes	☐ No	☐ N/A
Tee (jet)	☐ Yes	☐ No	☒ N/A
Suction Line	☐ Yes	☐ No	☐ N/A
Temporary	☐ Yes	☐ No	☒ N/A
Well ID Plate	☒ Yes	☐ No	☐ N/A
Pump ID Plate	☒ Yes	☐ No	☐ N/A

EHS: Bullock, Will

Issue Date: 04/13/2021

Casing: Depth: 130 Ft. Thickness: In. Comments:

Diameter: 6 In. Top of Casing: 12 In.

Material: SDR 21

Grout:

	Depth	Material	Method
From 0 To 20 Ft.	BENTONITE	POUR	
From 0 To Ft.	N/A	N/A	

* Liner Date: From 0 To Ft.

Grout:

	Depth	Material	Method
From 0 To Ft.	N/A	N/A	

Issued by: Stiles, Bailey

Date of Issue: 06/25/2020

WG witnessed by Bailey Stiles on 1/20/21,
GW-1 received 2/5/21. WF done on 4/13/21
by WTB.