

GRANVILLE-VANCE DISTRICT HEALTH DEPARTMENT IMPROVEMENT AND OPERATION PERMITS

COUNTY:		TAX NO.	TYPE OF ESTABLISHMENTS			*THIS PERMIT SHALL BE ACCOMPANIED BY A LAYOUT SHOWN ON A PLAT, INCLUDING SYSTEM REQUIREMENTS.
OWNER:		SR. NO.	RESIDENCE ☒ BUSINESS ☐ OTHER ☐	NUMBER OF BEDROOMS:	NUMBER OF OCCUPANTS:	
APPLICANT'S ADDRESS:			WATER SUPPLY	WELL ☒ PUBLIC ☐	OTHER ☐	*THIS IMPROVEMENT PERMIT IS SUBJECT TO REVOCATION IF THE INTENDED USES CHANGE FROM THOSE SHOWN ON THE IMPROVEMENT PERMIT. CHANGES SHALL REQUIRE HEALTH DEPARTMENT APPROVAL.
PROPERTY ADDRESS/LOCATION:			TYPE OF WASTEWATER SYSTEM	INITIAL INSTALLATION	REPAIR	
SUBDIVISION:			DESIGN FLOW:			
LOT NUMBER:			LTAR:			
REFERENCE SKETCH (SEE PLAT FOR DETAILS):			ABSORPTION AREA:			
			TRENCH WIDTH:			
			TRENCH DEPTH:			
			TRENCH SPACING:			
			TOTAL TRENCH LENGTH:			
			NUMBER OF TRENCHES:			
			GRAVEL DEPTH:			PERMIT VALID FOR: 5 YEARS YES ☒ NO ☐
			TANK SIZE:			
			PUMP TANK SIZE:			NO EXPIRATION YES ☐ NO ☒
			DISTRIBUTION DEVICE:			

IMPROVEMENT PERMIT DATE: 6/17/15

FOR: Grande Marine
ISSUED BY: Ch. H. H.

ISSUED BY: *CA*

CONSTRUCTION AUTHORIZATION FOR IMPROVEMENT PERMIT# 8032

Unless otherwise indicated, the same conditions above apply regarding system type, layout, location and installation requirements.
(The wastewater system cannot be installed until authorization is signed)

Comments: Installed according to architectural plans

Date: 6/17/15 Environmental Health Specialist: [Signature] Construction Authorization Addendum ☐ Yes ☐ No

OPERATION PERMIT

DATE: 3/28/2016

SYSTEM INSTALLED BY: Walter H. KHS A.C.
ISSUED BY: _____

PERFORMANCE, MONITORING, MAINTENANCE AND OPERATION
AS REQUIRED BY RULE .1961

Granville - Vance District Health Department

Environmental Health

1606

Well Construction Permit

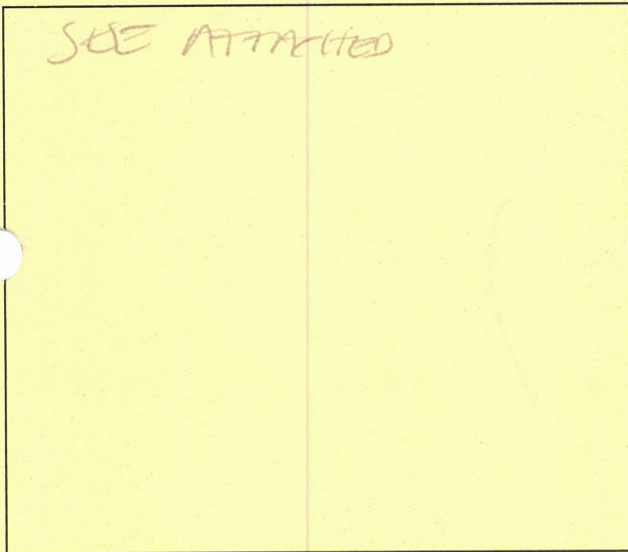
Owner/Applicant: Grande Manor Home Date: 6/17/15
Address or Location of Property: Grande Tracway

Subdivision & Lot #: The Preserve 609 Septic Permit #: 8232
Zoning Permit #: 18436 Environmental Health Specialist: _____

This well permit is to locate and site the area that a private groundwater well may be established on the property listed above by the Environmental Health Specialists of Granville County. If one does not locate the well in the approved area and complete the well as specified by the 15A NCAC .02C rules, then permits may be revoked. At completion of drilling of the well, grout must be witnessed by EHS and a well log turned into Environmental Health.

Minimum Setbacks: (these are the main setbacks, but not all required setbacks)

Setback from property lines - 10 ft Setback from septic tank and drain field, including repair area - 100 ft
Setback from structural foundations - 25 ft Setback from ponds, lakes or other bodies of water - 50 ft

Site Sketch:**Conditions:** _____

Authorized Agent: C. Hall

Date: 6/17/15

1 Well Grout: (Circle or write in)

Witnessed: Yes or No EHS Agent: Willie

Date: 2/10/16 Annular Space Open: Yes or No

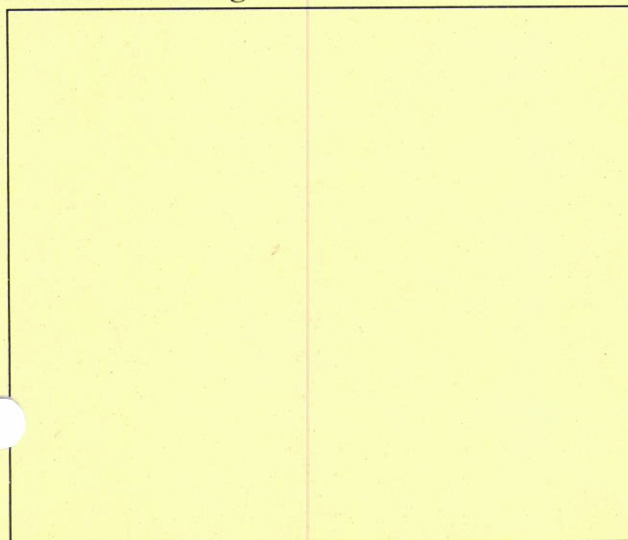
Over reamed: Yes or No Depth Grouted: 20+

Method: _____ Pump ✓ Poured _____ Pressure

Well Log received: Yes or No (EHS to Attach to Permit)

Driller Name: DAVIS Cert. # 2385

Depth: 305 Casing Depth: 68 GPM: 12

As Built Drawing:**# 2 Well Final: (Place a check mark when finalized)**

Seal Present and Intact: ✓ Air Vent: ✓

Hose Spigot: ✓ Electrical Box: ✓

Pump Installer Tag: ✓ Well Installer Tag: ✓

All holes sealed: ✓ 12" above grade: ✓

Comments: _____

3 Well Completion Permit: Willie EHS

Date Completed: 7/13/16

4 Water Samples Taken: Date: 7/13/16

EHS: Willie Results: _____

Retest: _____ Results: _____

Granville – Vance District Health Department
Environmental Health

Final Sketch

Pin _____

☐ Improvement Permit

☒ Construction Authorization

Grande Manor Homes Permit No. _____
Applicant's Name

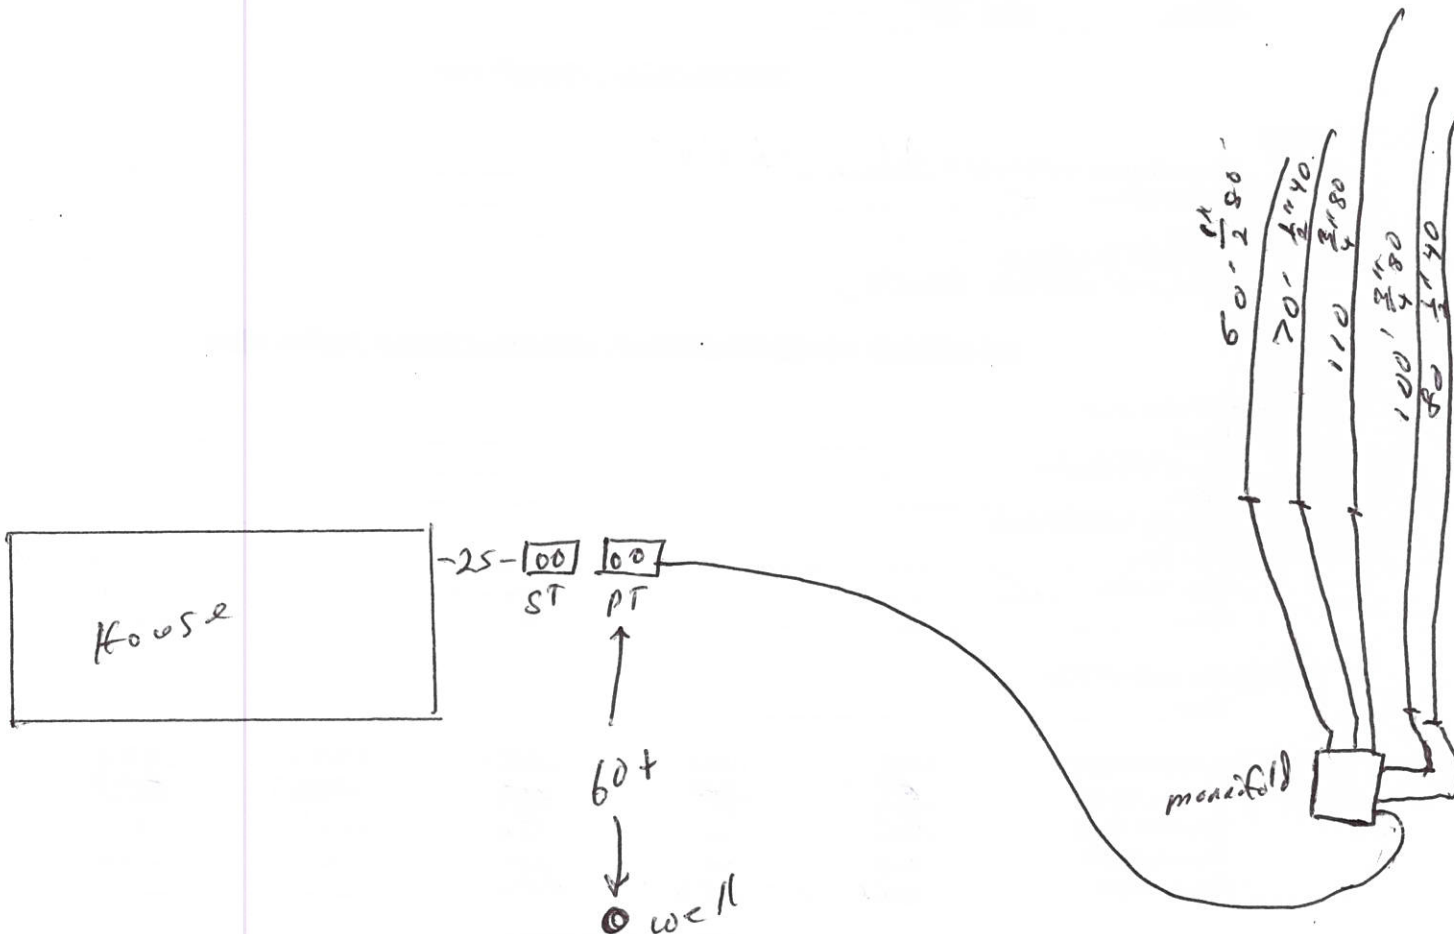
Preserve 69
Subdivision – Section – Lot

Physical Address: Garner Terrace Way

Biontley
System Installer

3/28/2016
Date

System design and details as installed.



Garner Terrace Way

Walter T. Vayns REHS
Authorized Signature

3/28/2016
Date

SEWAGE DISPOSAL SYSTEM INSTALLATION REVIEW

SEPTIC AND PUMP TANK INSPECTION

SEPTIC TANK

Manufacturer D-B
 Date of Manufacture 11-2-15
 Stamp 646
 Capacity 1000
 Tee _____
 Baffle _____
 Sealant _____
 AIR GAP _____, FILTER _____, RISER _____

INITIAL

WTV

DATE

3/28/2016

PUMP TANK

Manufacture D-B
 Date of Manufacture 9-22-15
 Stamp _____
 Capacity 1000
 Sealant _____
 Manhole _____
 RISER _____, SEALANT _____

MECHANICAL INSPECTION

PUMP

Manufacturer and Model # AshLand EP 45
 Control Panel ✓
 Alarm _____
 Electrical Connection _____
 SEALANT AROUND CONDUIT ✓

NITRIFICATION/DISTRIBUTION AND DRAINFIELD INSPECTION

DISTRIBUTION BOX

Level _____
 Equal Distribution _____
 Other _____

DISTRIBUTION MANIFOLD

Pipe Size _____
 Gate Valves ✓
 Other _____

OTHER DISTRIBUTION

Type _____

NITRIFICATION LINES

Trench Width _____
 Trench Length _____
 Trench Grade _____
 Stone Depth _____

LINE 1

60

LINE 2

70

LINE 3

110

LINE 4

100

LINE 5

80

LINE 6

60

70

110

100

80

✓

✓

accept

polyethylene

✓

✓

✓

WELL INSPECTION

LOCATION OF WELL _____

COMMENTS:
