



OPERATION PERMIT

Franklin County Health Department
107 Industrial Drive
Louisburg, NC 27549
Phone:

For Office Use Only

*CDP File Number 454824 - 1

County ID Number:

Evaluated For: NEW

Property Owner:

Owner Address:

City:

State/Zip: /

Phone #:

Address: 125 Cherry Bark Dr
Youngsville, NC 27596

Road #:

Township:

Subdivision: Sorrell Oaks

Phase : NEW Lot: 84

Structure: SINGLE FAMILY

of Bedrooms: 4

of People: 4

Water Supply: PUBLIC

Saprolite System?: ☐ Yes ☒ No

Pump Required?: ☐ Yes ☒ No

Design Flow: 480

System Classification/Description: TYPE III B. SYSTEM
W/SINGLE EFFLUENT PUMP

Installer: Trueworks

Certification #:

Specific System EZFLOW EZ 1203H-GEO

Installed:

STB: 502

PT:

Septic Tank Date: _____

Pump Tank Date: _____

Comments: Product not documented during inspection. Suspect EZflow. Lori J only permitted the OP after pump fee was paid; she did not do the final inspection; that was done by J Wood.

This system has been installed in compliance with applicable NC General Statutes, Rules for Sewage Treatment and Disposal, and all conditions of the Improvement Permit and Construction Authorization.

PERMIT CONDITIONS:

I. Performance: System shall perform in accordance with Rule .1301.

II. Monitoring: As required by Rule .1301.

III. Maintenance: Ground absorption sewage treatment and disposal systems shall be checked, and the contents of the septic tank removed, periodically from all compartments, to ensure proper operation of the system. The contents shall be pumped whenever the solids level is found to be more than 1/3 of the liquid depth in any compartment.

Other:

Subsurface Operator Required: ☐ Yes ☒ No

If yes, see attached sheet for additional operation conditions, maintenance and reporting.

Operation:

Other: Product not documented during inspection. Suspect EZflow. Lori J only permitted the OP after pump fee was paid; she did not do the final inspection; that was done by J Wood.

Authorized State Agent: Jones, Lori

Date of Issue: 03/24/2026

Owner/Applicant:



Applicant or Owner Name: Brandywine

Building permits cannot be issued nor should construction begin without Construction Authorization issuance.

Diagram Date**: 6/10/25 EHS: A. Mas

****Any previously dated CA diagram is revoked and/or invalid. Confirm this is the valid diagram for the site before beginning any construction.**

Installation/grouting inspections may be scheduled the day before, or, the day of installation until 9am by contacting the Environmental Health office at 919 496 8100. A revisit fee may apply if installation is not ready for inspection at the time requested. **Septic Operations Permits** will be issued after installation is approved, all permits conditions are met, and any outstanding fees are paid. **Well Certificate of Completion** will be issued after well head approval, all permit conditions are met, and any outstanding fees are paid.


Septic Tank 1000 Pump Tank 1000 Drainfield 3x300 Type System P+A Max Trench Depth 30"

Septic Contractor Davis Tractor Septic/Pump tank dates 7 Pump Fee Paid Applied 3-12-26
Well Contractor _____ Well Head Date: _____ Pump Final: _____ N/A (circle) ll

ST Dd B1000 12/11/25 STB 532

PT DOB 1000

PT DOB 1000
CK'd tanks & lines 1/20/25 237
JRW 269
wounded

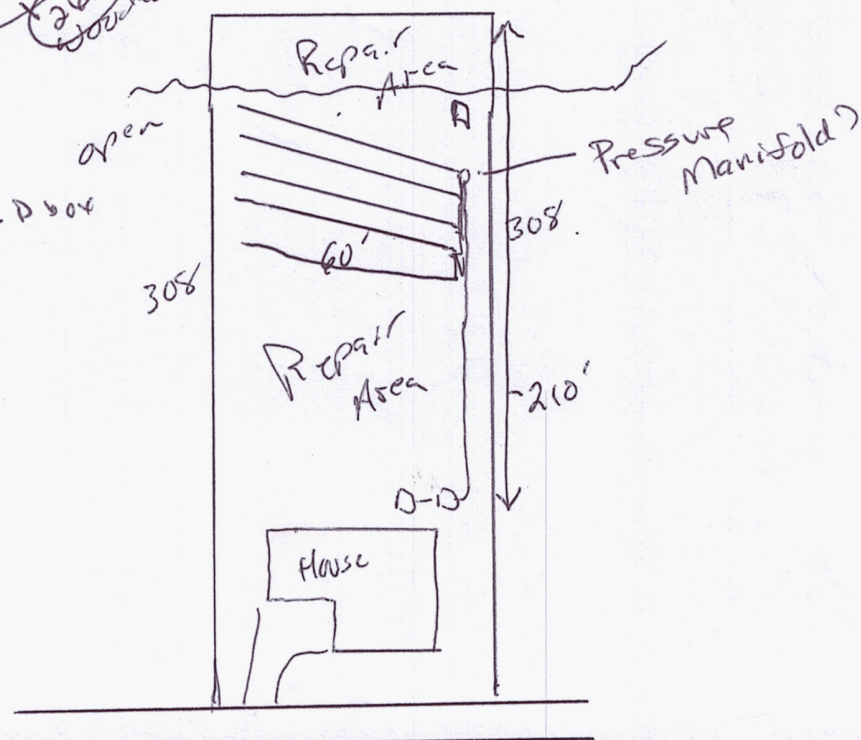

Pump
Final
Sheet



P.O. Box 1675, Wake Forest, NC 27588

PUMP FINAL

Location: 125 Cherry Bark Dr. Yonkersville
Sorrell Oaks Lot 84

CDP- 454824-1

Date: 2.12.26

- 1) ☒ Pump to D-box lines of equal length 5-60' lines
 - ☐ Pump to D-box serial distribution
 - ☐ Pump to pressure manifold
- ☒ 2) Float control levels:
- ☒ 3) High-water alarm, including sound:
- ☒ 4) Operating pressure head, if applicable:
- ☒ 5) Delivery of water to the dispersal field:

Completed by:

Bernie Goodwin

Print

Bernie Goodwin

Signature

2.12.26

Date