


NOTE: Make sketch of installation showing location of house, septic tanks, privies, water supplies on adjacent property, etc. Write in measurements in order that installations may be located at later date.

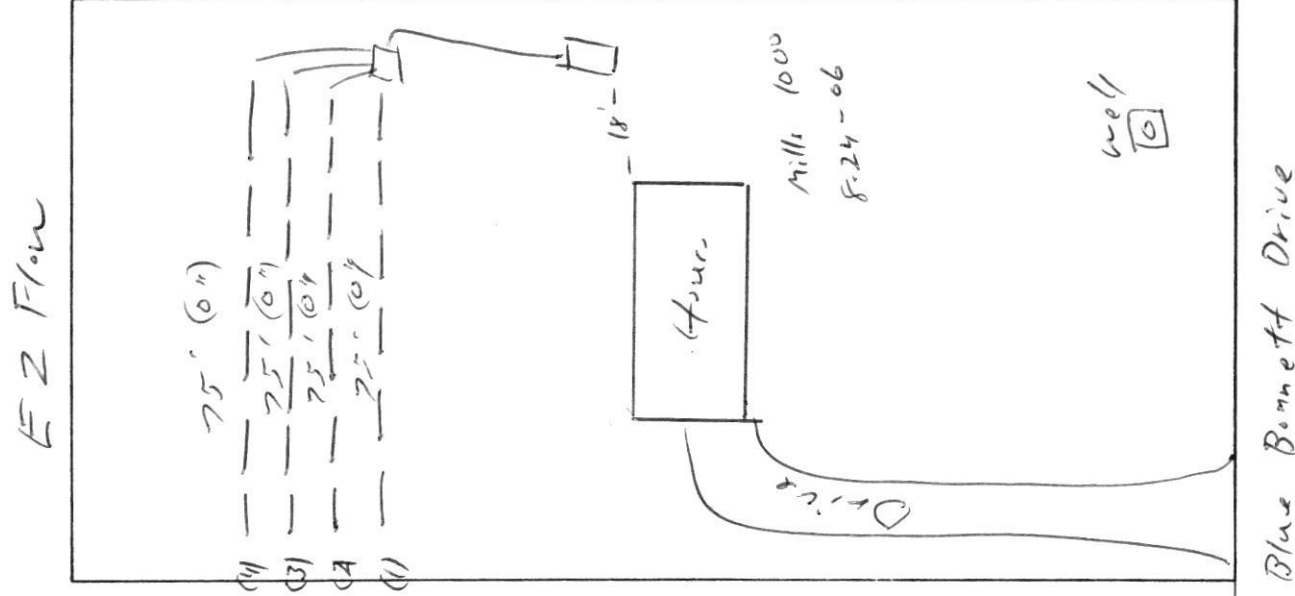

GRANVILLE-VANCE HEALTH DEPARTMENT—Sewage Disposal Record

Owner or Contractor A.P. Baker Date 10-11-06 S.R. No. 1710
 Location/Address Blue Bennett Drive off Lawrence Road
 Subdivision/Mobile Home Park Name Cherleigh Lot Size .92 acrs
 Permit No. # 05497 Lot No. 16

New System ☒ Repair _____
 House ☒ Mobile Home _____ Business _____
 No. Bedrooms 3 No. People _____ No. Toilets _____
 Water Supply: Private ☒ Approved _____
 Semi-Public _____ Unapproved _____
 Public _____ None _____

Nitrification System:

Tank Size 1000 gal.
 Distribution Box ☒ No. Lines 4
 Nitrification Field 1200 Sq. Ft.

Lines:	1	2	3	4	5	6
Width	<u>3'</u>	<u>3'</u>	<u>3'</u>	<u>3'</u>	_____	_____
Length	<u>75'</u>	<u>75'</u>	<u>75'</u>	<u>75'</u>	_____	_____
Grade	<u>0'</u>	<u>0'</u>	<u>0'</u>	<u>0'</u>	_____	_____
Stone Depth	<u>2.5</u>	<u>2.5</u>	<u>2.5</u>	<u>2.5</u>	_____	_____

EZ Flow units

Layout to be followed by installer:

Improvements Permit By David Cumbee Installer HBM Britt Murphree
 Certificate of Completion By Eddie Yount Date of Inspection 10-11-06

* Construction must comply with all other applicable state and local regulations, but the permit is not a guarantee that the system will not malfunction and the Granville-Vance Health District will not be held responsible for a malfunctioning system.