

FRANKLIN COUNTY HEALTH DEPARTMENT

PERMIT NUMBER: 17113C CONST IMPROVE PERMIT	DATE: 20030207	1843-35-2702	SIZE: 0.920A
APPLICANT: SAWYER HOMES INC 1002 DURHAM RD SUITE 600A WAKE FOREST NC 27587		OWNER: BALLINGER WALTER E	
TELEPHONE: 422-1525			
COMMENT: SFD	556-751	DESCRIPTION: 5 YEAR ☒	LIFETIME: ☐
LOCATION / DIRECTIONS: BALLINGER FARMS #2 - 25 BALLINGER DR YNG			
FEE: 225.00		SIGNATURE OR OWNER OR AUTHORIZED AGENT:	

THE ABOVE SIGNATURE INDICATES THAT I HAVE READ, UNDERSTAND, AND AGREE WITH ALL PROVISIONS AND INFORMATION AS OUTLINED ON THE BACK SIDE OF THIS FORM

TOPO <u>PS</u>	TEXTURE <u>PS</u>	STRUCTURE <u>PS</u>	DEPTH <u>PS</u>
R. HOR <u>PS</u>	SOIL. WET <u>PS</u>	AVAIL. SP <u>PS</u>	OTHER
MINRL <u>PS</u>	OVERALL <u>PS</u>	LTAR <u>0.3</u>	
#BEDRMS <u>3</u>	GPD <u>360</u>	DISPOSAL	TYPE. SYS <u>Conv</u>
SZ. TANK <u>1000</u>	SZ. CHAMB	NITRIFI <u>3'x400'</u>	TYPE. WAT <u>Public</u>
SITE. LOC	MAX TRENCH DEP <u>30"</u>	TYP. FAC <u>SFD</u>	

REMARKS: *DRAWING Not to Scale

*EXACT TANK & DRAINFIELD LOCATION May Vary Slightly


CONTRACTOR: David Bramley & Sons

TANK MANUF: D-B 1000

MANUF DATE: 4/4/03

*Install SYSTEM Along Contour & IN DRY Conditions

*Do Not Park or Drive Over SYSTEM AREA

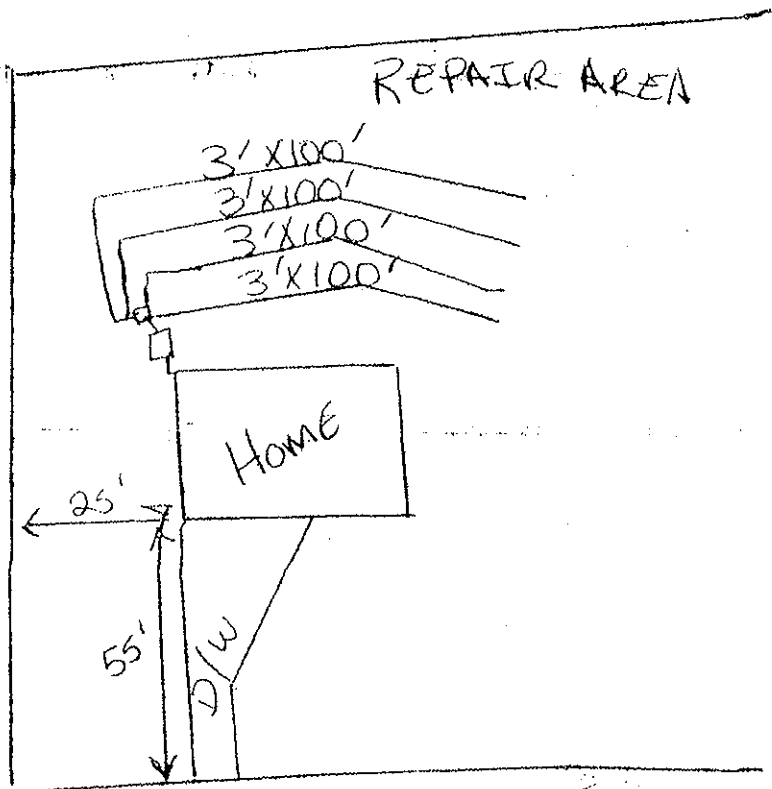

BALLINGER FARM

IMPROVEMENT PERMIT DATE: 2/10/03

CONSTRUCTION AUTHORIZATION DATE: 2/10/03

OPERATION PERMIT DATE: 6/23/03

ENV HEALTH SPEC: Andy Smith

ENV HEALTH SPEC: Andy Smith

ENV HEALTH SPEC: Andy Smith