



OPERATION PERMIT

Franklin County Health Department
107 Industrial Drive
Louisburg, NC 27549
Phone:

For Office Use Only

*CDP File Number 297124 - 2

County ID Number: 2709140585

Evaluated For: NEW

Property Owner: ANTONIA ALLEN

Address: 607 23RD ST

Road #:

City: BUTNER

State/Zip: NC/ 27509

Phone #:

Township:

Subdivision:

Phase : ACTIVE

Lot: 1

Structure: SINGLE FAMILY

of Bedrooms: 4

of People: 2

Water Supply: N/A

Saprolite System?: ☐ Yes ☒ No

Pump Required?: ☒ Yes ☐ No

Design Flow: 480

System Classification/Description: TYPE III B. SYSTEM
W/SINGLE EFFLUENT PUMP

Installer: *Hugh Williams*

Specific System UNKNOWN

Installed:

STB: 1000

PT: 1000

Comments:

Certification #:

Septic Tank Date: 06/08/2022

Pump Tank Date: 06/08/2022

This system has been installed in compliance with applicable NC General Statutes, Rules for Sewage Treatment and Disposal, and all conditions of the Improvement Permit and Construction Authorization.

PERMIT CONDITIONS:

I. Performance: System shall perform in accordance with Rule .1961.

II. Monitoring: As required by Rule .1961.

III. Maintenance: Ground absorption sewage treatment and disposal systems shall be checked, and the contents of the septic tank removed, periodically from all compartments, to ensure proper operation of the system. The contents shall be pumped whenever the solids level is found to be more than 1/3 of the liquid depth in any compartment.

Other:

Subsurface Operator Required: ☐ Yes ☒ No

If yes, see attached sheet for additional operation conditions, maintenance and reporting.

Operation:

Other:

Authorized State Agent: Bendel, Joel

Date of Issue: 08/19/2022

Owner/Applicant: _____



File # 297124 PIN#

Property Address: 65 Saggy Bottom Trl.

Applicant or Owner Name: Lillian Capobianco

Environmental Health Septic/Well Permit Diagram

Building permits cannot be issued nor should construction begin without Construction Authorization issuance.
☒ Septic Improvement Permit ☒ Septic Construction Authorization (CA) ☐ CA Reissue** ☒ As Built
☒ Well Construction Authorization ☐ Additional Diagram/Specifications Attached

Diagram Date**: 2-10-22 EHS: Joel Bendel


**Any previously dated CA diagram is revoked and/or invalid. Confirm this is the valid diagram for the site before beginning any construction.

Installation/grouting inspections may be scheduled the day before, or, the day of installation until 9am by contacting the Environmental Health office at 919 496 8100. A revisit fee may apply if installation is not ready for inspection at the time requested. Septic Operations Permits will be issued after installation is approved, all permits conditions are met, and any outstanding fees are paid. Well Certificate of Completion will be issued after well head approval, all permit conditions are met, and any outstanding fees are paid.

Septic Tank 1000 Pump Tank 1000 Drainfield 3' x 400' Type System Pump Max Trench Depth 22"
Septic Contractor Hugh Williams Septic/Pump tank dates ST 6-8-22 Pump fee? NO ES pd 8/19 PA
Well Contractor _____ Well Grout date: PT 6-8-22 paid

Bedrooms: 4

* Drawing not to scale

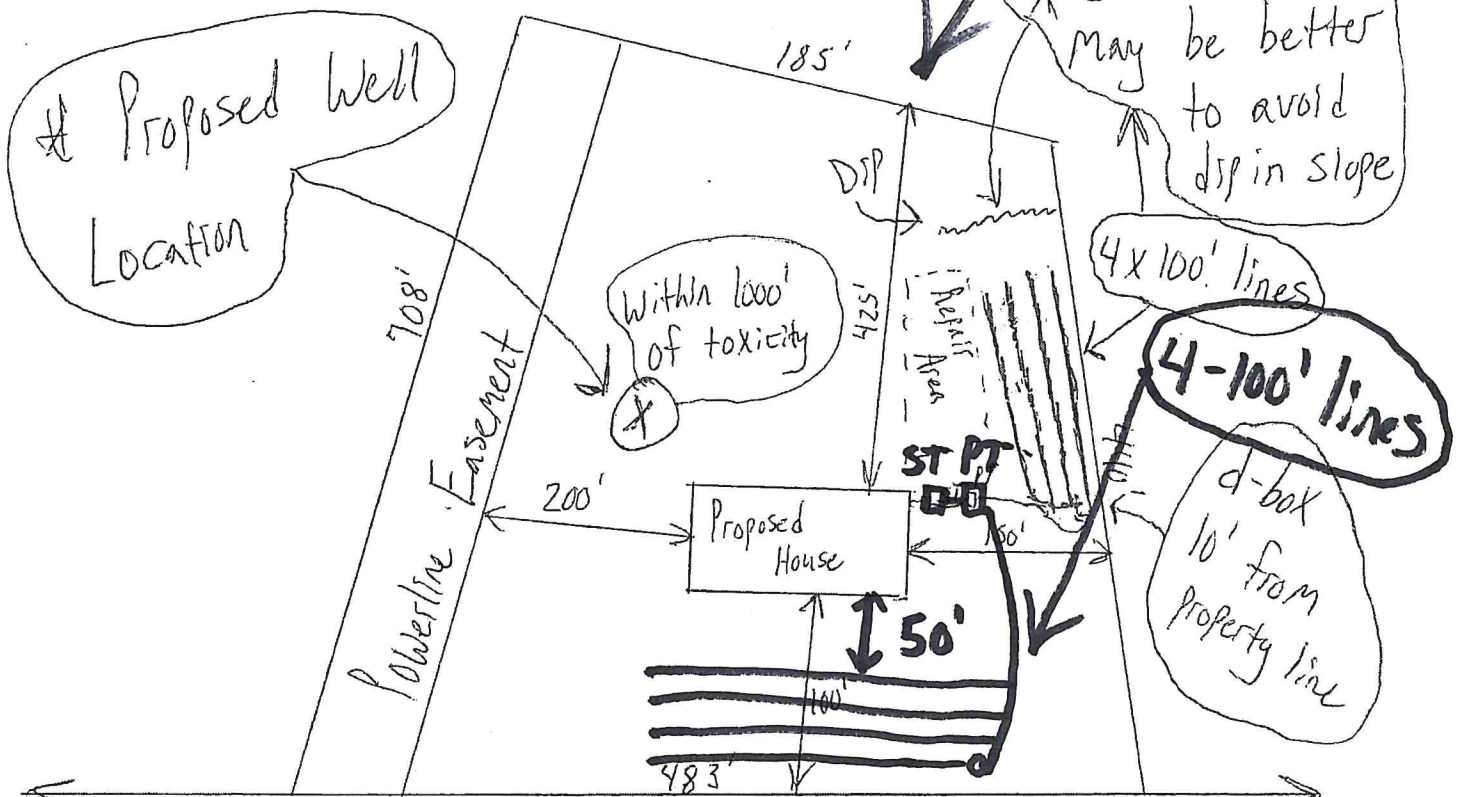

Saggy Bottom Trl.