

FRANKLIN COUNTY HEALTH DEPARTMENT

PERMIT NUMBER: 16017C CONST IMPROVE PERMIT		DATE: 20011128		1853-67-8377		SIZE: 0.920A	
APPLICANT: SUMNER CONSTRUCTION 1265 FLAT ROCK CHURCH RD LOUISBURG NC 27549 TELEPHONE: 556-4481				OWNER: DOWDY MARK E & TONI			
COMMENT: SFD				DESCRIPTION: 5 YEAR ☒		LIFETIME: ☐	
LOCATION / DIRECTIONS: FLEMING FOREST #56 - 25 WINCHESTER CT YNG							
FEE: 175.00				SIGNATURE OR OWNER OR AUTHORIZED AGENT:			

THE ABOVE SIGNATURE INDICATES THAT I HAVE READ, UNDERSTAND, AND AGREE WITH ALL PROVISIONS AND INFORMATION AS OUTLINED ON THE BACK SIDE OF THIS FORM

TOPO <u>PS</u>	TEXTURE <u>PS</u>	STRUCTURE <u>PS</u>	DEPTH <u>PS</u>
R. HOR <u>PS</u>	SOIL. WET <u>S</u>	AVAIL. SP <u>PS</u>	OTHER _____
MINRL <u>PS</u>	OVERALL <u>PS</u>	LTAR <u>0.28</u>	
#BEDRMS <u>3</u>	GPD <u>360</u>	DISPOSAL _____	TYPE. SYS <u>P.OSSO</u>
SZ. TANK <u>1000 gal</u>	SZ. CHAMB <u>1000 gal</u>	NITRIFI <u>3'x 320'</u>	TYPE. WAT <u>ADON</u>
SITE. LOC _____	MAX TRENCH DEP <u>20"</u>	TYP. FAC <u>SFD</u>	
REMARKS: <u>* Drawing Not to Scale</u>			

- * Permit Calls For Use of Innovative System

CONTRACTOR:

TANK MANUF:

MANUF DATE:


- * Install Approved Pressure Manifold System

* Install Lines along Contour As Much as Possible

* Install System In Dry Conditions

* DO NOT PARK OR
Drive over System
Area

* System Converted to Gravity Flow 10/30/02
* 13 EACH PANELS * Lay out May Vary Slightly!

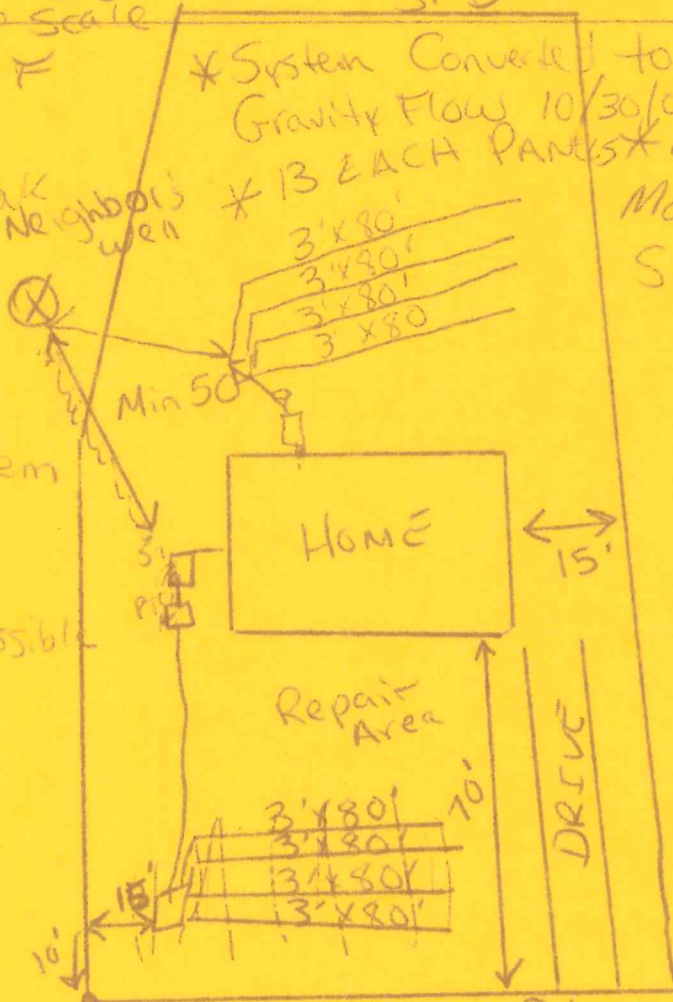

IMPROVEMENT PERMIT DATE:

CONSTRUCTION AUTHORIZATION DATE:

OPERATION PERMIT DATE:

ENV HEALTH SPEC:

ENV HEALTH SPEC:

ENV HEALTH SPEC:

COUNTY OF FRANKLIN
ENVIRONMENT HEALTH APPLICATION (496-8100)

Permit #: **5825**

Permit Type: **SEPTIC PERMIT**

Date Issued: **11/28/2001**

Project Address: **25 WINCHESTER CT, YOUNGSVILLE NC 27596**

Location: **25 WINCHESTER CT**

16017C

Lot #: **56**

Subdivision: **FLEMING FARMS**

Size #: **0.920**

Applicant: **SUMNER CONSTRUCTION: Bobby Sum**
1265 Flat Rock Church Road
Louisburg, NC 27549

Phone: **919-556-4481**

Contractor: **SUMNER CONSTRUCTION**
1265 Flat Rock Church Road
Louisburg, NC 27549

Phone: **919-556-4481**

Proposed Use: **SFD**

Work:

Desc:

Bldg Cost: \$0	Fees Due: \$175.00	Date Paid: 11/28/2001
Zoned: A R	Setbacks Front: 30	Rear 25 Side 10
Tax record: 32789	Pin #: 1853-67-8377	Parcel #: C06E00 056
Township: YOUNGSVILL	Public Water/Sewer: PRIVATE	ST Road #:
Special Conditions/Property Owner: DOWDY MARK E & TONI		
# of bedrooms: 3	# of people: 3	Approved for Issuance by:
I certify that all the statements made in this application and any attached documents are true, complete and correct to the best of my knowledge and belief and are made in good faith. I understand that false information may be grounds for rejection of this application. Authorized county representatives are granted right of entry to make evaluations or inspections and to release information upon public request.		

Call Environment Health (496-8100) between 8:00 AM and 9:00 AM Monday thru Friday to schedule an appointment with the environment health specialist to evaluate your lot. He/She will show you where to locate the well and septic system, in relation to the desired dwelling location and any property lines. If approved, an improvements permit will be issued. After the septic tank has been installed and approved, the Sanitarian will issue a certification of completion.

Terrence Al Brown

(Signature of Contractor, Authorized Agent or Owner)

11 / 28 / 01
Date

Franklin County Zoning Permit



FRANKLIN COUNTY

Franklin County, North Carolina

Planning Department

215 E Nash Street, Louisburg, North Carolina 27549

496-2909

Zoning Permit Number: 1353

ADDRESS: 25 WINCHESTER CT

PARCEL NO.: 1853-67-8377

ZONING: A R

SUBDIVISION: FLEMING FARMS

LOT: 56

ISSUED TO:

SUMNER CONSTRUCTION

P O BOX 1011

YOUNGSVILLE NC 27596

SETBACK: FRONT: 30

RIGHT: 10

LEFT: 10

REAR: 25

COUNTY WATER: NO

FLOODPLAIN: NO

PERMIT TYPE:

ZONING PERMIT

DETAILS:

SINGLE FAMILY DWELLING

PERMIT DATE: 11/28/2001

WATERSHED NO

FEE: \$0.00

TOWNSHIP YNGS

EXPIRE DATE: 05/28/2002

It is hereby certified that the above use as shown on the plats and plans submitted with the application conforms with all applicable provisions of the Franklin County Zoning Ordinance. The issuance of this Permit does not allow the violation of Franklin County Zoning Ordinances or other governing Regulations.

The applicant is responsible for obtaining a building permit (if required) prior to commencing work on the proposed improvement. A final zoning inspection must be scheduled by the applicant.

APPROVED BY:

DATE:




Zoning Inspector

11/28/2001

(59)

(58)

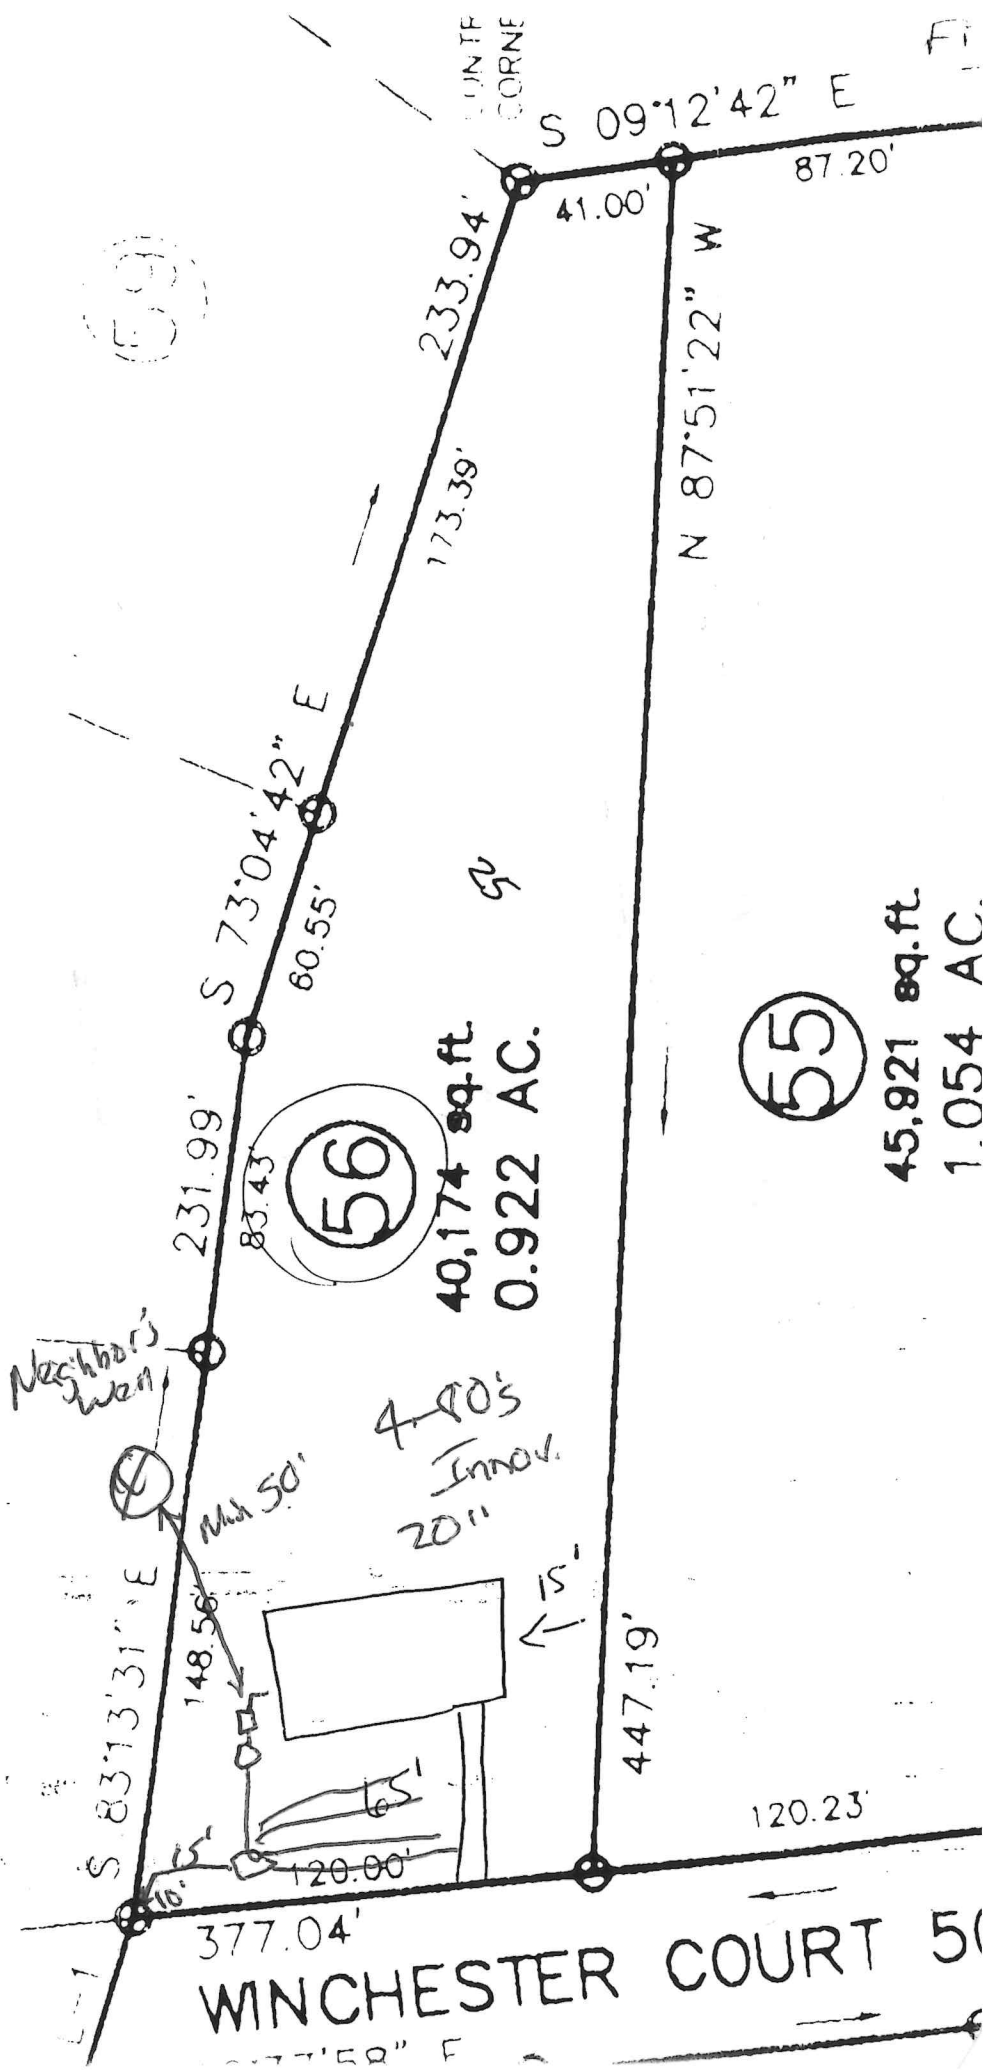

11 1852 17 0047