

Granville – Vance District Health Department
Environmental Health

Pin 182400897080

Permit Number 6886

☒ Improvement Permit

☒ Construction Authorization

Final Sketch

Cirle B Builders

Applicants Name

Brantly Place - lot 10

Subdivision – Section – Lot

Physical Address: 1205 Bayview Ct

Brantly
System Installer

10-15-10
Date

System design and details as installed.

Septic Tank Information:

Date: 10-14-10

Manufacture: DB STB-646

ID #: Cap 1020

Pump Tank Information:

Date: /

Manufacturer: /

ID #: /

Distribution Box ☒


Pressure Manifold

Serial Distribution

Type of Facility: Residence

Number of Bedrooms: 3

Type of System: gravity ez-flow

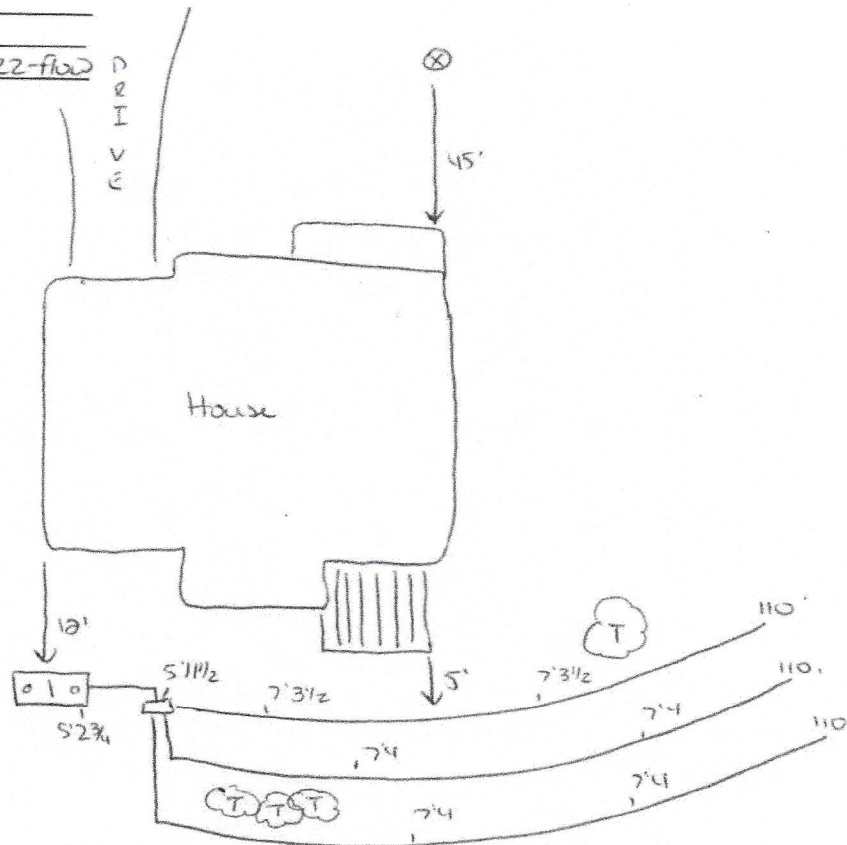

Cassio Champion REHS
Authorized Signature

10-15-10

Date