

Granville - Vance District Health Department

00334

Environmental Health

Well Construction Permit

Owner/Applicant: Circle 3 Builders Date: 6-25-10
 Address or Location of Property: 1205 Bayview Court
 Subdivision & Lot #: Briantley Place 10 Septic Permit #: 6886
 Zoning Permit #: 16745 Environmental Health Specialist: David Rumble

This well permit is to locate and site the area that a private groundwater well may be established on the property listed above by the Environmental Health Specialists of Granville County. If one does not locate the well in the approved area and complete the well as specified by the 15A NCAC .02C rules, then permits may be revoked. At completion of drilling of the well, grout must be witnessed by EHS and a well log turned into Environmental Health.

Minimum Setbacks: (these are the main setbacks, but not all required setbacks)

Setback from property lines – 10 ft Setback from septic tank and drain field, including repair area – 100 ft
 Setback from structural foundations – 25 ft Setback from ponds, lakes or other bodies of water – 50 ft

Site Sketch:

Conditions: Careful with setbacks
to drain field and tank location
call 693-2088 w/ questions

Authorized Agent: David Rumble
Date: 6-25-10

1 Well Grout: (Circle or write in)

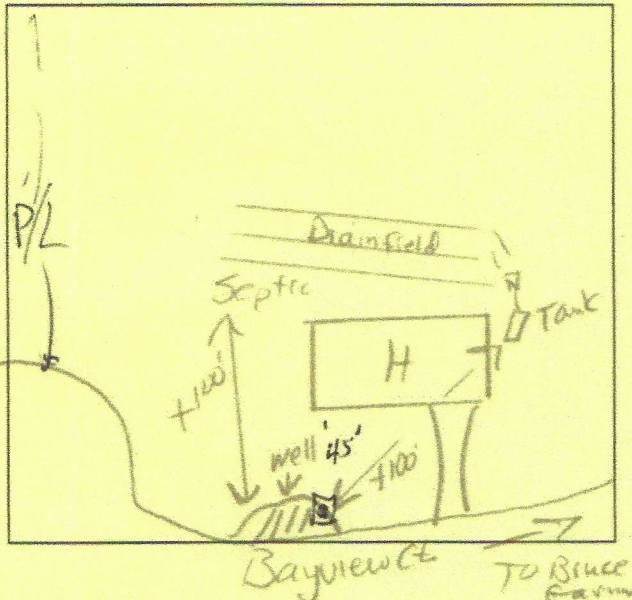
Witnessed: Yes or No EHS Agent: David Rumble
 Date: 10-6-10 Annular Space Open: Yes or No
 Over reamed: Yes or No Depth Grouted: _____
 Method: Pump ✓ Poured Pressure
 Well Log received: Yes or No (EHS to Attach to Permit)
 Driller Name: Southern Cert. # _____
 Depth: 240' Casing Depth: 110' GPM: 30

2 Well Final: (Place a check mark when finalized)

Seal Present and Intact: ✓ Air Vent: ✓
 Hose Spigot: ✓ Electrical Box: ✓
 Pump Installer Tag: ✓ Well Installer Tag: ✓
 All holes sealed: ✓ 12" above grade: ✓
 Comments: Jenks Pump Service
1/2 H.P. depth 100'

3 Well Completion Permit: David Rumble EHS
Date Completed: 3-1-11

4 Water Samples Taken: Date: 3-1-11
 EHS: DR Results: _____
 Retest: _____ Results: _____

**As Built Drawing:**