


NOTE: Make sketch of installation showing location of house, septic tanks, privies, water supplies on adjacent property, etc. Write in measurements in order that installations may be located at later date.

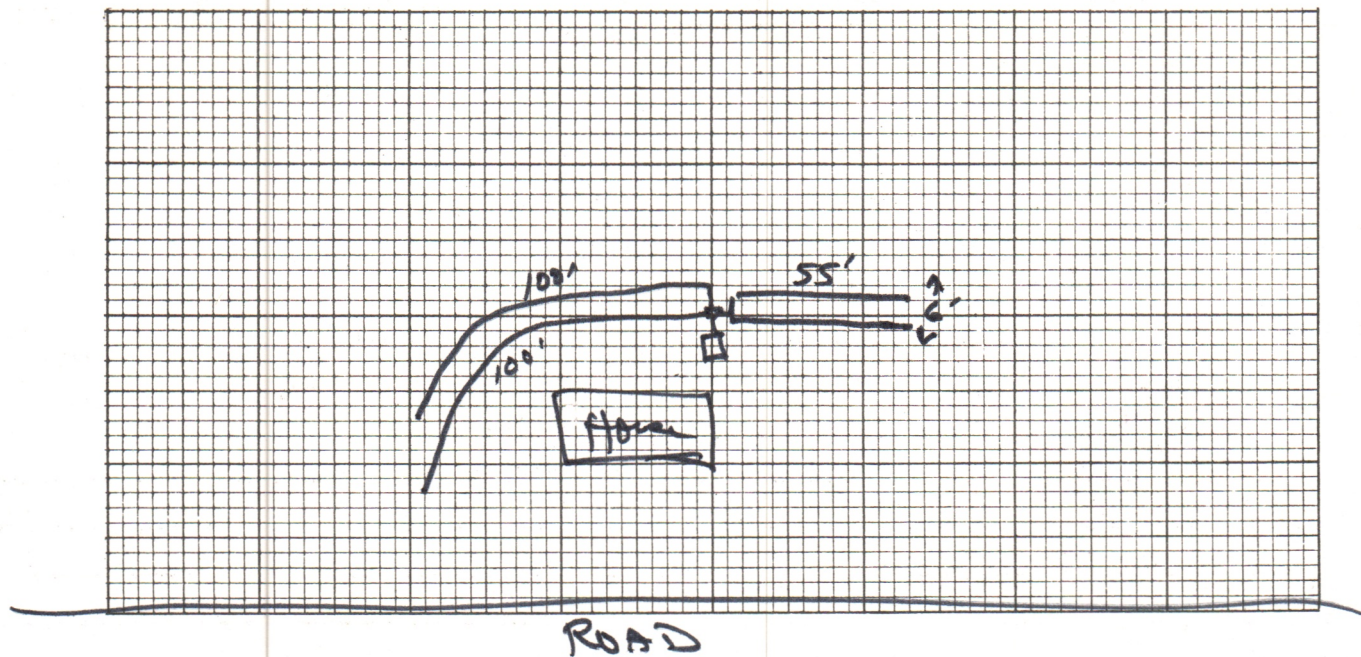

Estates

179

OWNER Wilson, J.D ADDRESS Lynn Bank Rd. 046703051
OCCUPANT _____ SUBDIVISION Lynn Bank Estates
HOUSE ☒ MOBILE HOME _____ BUSINESS _____ LOT AREA .81 LOT # 39
SEPTIC TANK: (SIZE 1000 GALS.) PRIVY: (NUMBER _____)
No. Bedrooms 3 No. Bathrooms 1 New _____ Date _____
Garbage Disposal Unit Yes _____ No ☒ Repaired _____ Date _____
Auto. Dishwasher Yes _____ No ☒
Auto. Wash. Machine Yes ☒ No _____
Nitrification Field 960 sq. ft. WATER SUPPLY:
Depth of stone in lines 12" Individual ☒ Public _____
FHA CASE # _____ VA CASE # _____ If well, type:
FARMERS HOME ADM. CASE # _____ Bored _____ Drilled ☒ Dug _____
Contractor Jimmy Norwood Distance from nearest
Address _____ pollution _____ Ft.
PERMIT # 2455 DATE 9-26-79 REMARKS: _____
APPROVED: YES ☒ NO _____
APPROVED BY: James K. Kelly 10-19-79