

732-1643

FRANKLIN COUNTY HEALTH DEPARTMENT

PERMIT NUMBER: 15452C - CONST IMPROVE PERMIT 20011016	DATE: 1946-47-6891	SIZE: 4.920A
APPLICANT: MITCHELL EDWARD SHANE 650 JOHN SANDLING RD FRANKLINTON NC 27525	OWNER: MITCHELL EDWARD	
TELEPHONE: 494-1041		
COMMENT: SFD	DESCRIPTION: 5 YEAR ☐	LIFETIME: ☐
LOCATION / DIRECTIONS: STONEFIELD #55 - HARDWOOD DR		
FEE: 175.00	SIGNATURE OR OWNER OR AUTHORIZED AGENT:	

THE ABOVE SIGNATURE INDICATES THAT I HAVE READ, UNDERSTAND, AND AGREE WITH ALL PROVISIONS AND INFORMATION AS OUTLINED ON THE BACK SIDE OF THIS FORM

TOPO <u>3</u>	TEXTURE <u>15</u>	STRUCTURE <u>13</u>	DEPTH <u>15</u>
R. HOR <u>1</u>	SOIL. WET <u>5</u>	AVAIL. SP <u>13</u>	OTHER <u>15</u>
MINRL <u>15</u>	OVERALL <u>13</u>	LTAR <u>13</u>	
#BEDRMS <u>2</u>	GPD <u>150</u>	DISPOSAL <u>13</u>	TYPE. SYS <u>Conv</u>
SZ. TANK <u>1000</u>	SZ. CHAMB <u>150</u>	NITRIFI <u>1500</u>	TYPE. WAT <u>1500</u>
SITE. LOC <u>15</u>	MAX TRENCH DEP <u>15</u>	TYP. FAC <u>1500</u>	
REMARKS: <u>Form needs to be filled out in a timely manner.</u>			

*Layout May Vary Slightly!

CONTRACTOR: Robert Blackley

TANK MANUF: Ellis 1000gal


MANUF DATE: 5-31-02

*Install Lines along Contour

*Install System In Dry Conditions

*Do Not PARK or Drive over System Area

*Surface Swale is recommended Hardwood Dr. to be installed As Shown!

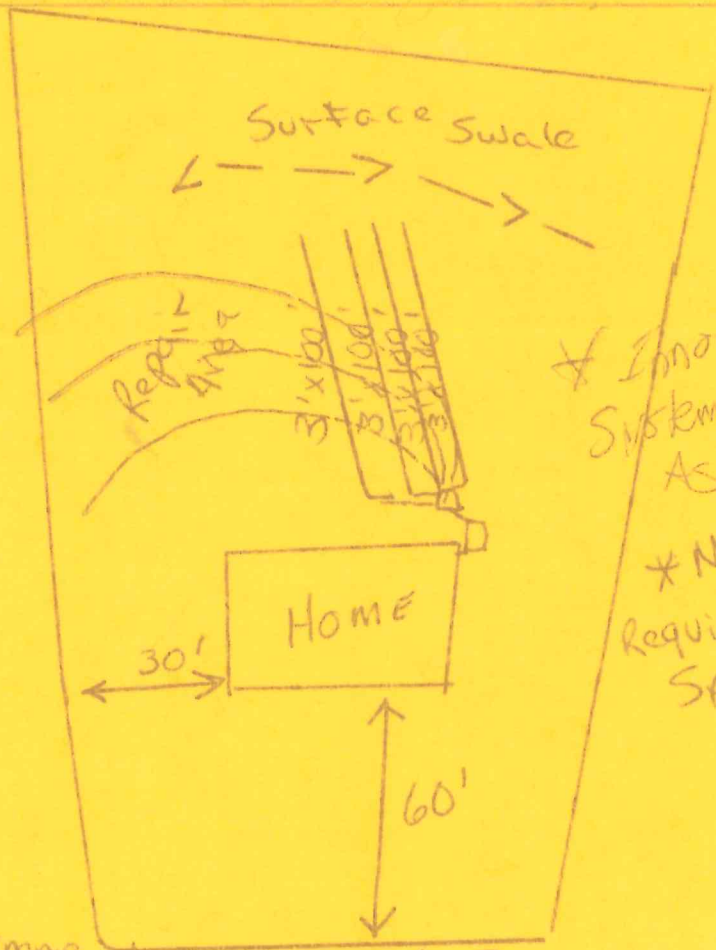

IMPROVEMENT PERMIT DATE: 10/16/01

ENV HEALTH SPEC: Andy Smith

CONSTRUCTION AUTHORIZATION DATE: 12/17/01

ENV HEALTH SPEC: Andy Smith

OPERATION PERMIT DATE: 7/29/02

ENV HEALTH SPEC: Andy Smith

COUNTY OF FRANKLIN

ENVIRONMENT HEALTH APPLICATION (496-8100)

Permit #: **5404**

Permit Type: **SEPTIC PERMIT**

Date Issued: **10/04/2001**

Project Address: **HARDWOOD DRIVE,**

Location: **HARDWOOD DRIVE**

Subdivision: **STONEFIELD**

Lot #: **55**

Size #: **0.920**

15852C

Applicant: **MITCHELL, EDWARD SHANE**
650 JOHN SANDLING ROAD
FRANKLINTON, NC 27525

Phone: **494-1041**

Contractor:

Phone:

Proposed Use: **SFD**

Work:

Desc:

Bldg Cost: \$0	Fees Due: \$175.00	Date Paid: 10/04/2001
Zoned: AR	Setbacks Front: 30	Rear 25 Side 10
Tax record: 35072	Pin #: 1846-47-6891	Parcel #: B02B00 055
Township: FRANKLINTO	Public Water/Sewer: COUNTY	ST Road #:
Special Conditions/Property Owner: MITCHELL, EDWARD		
# of bedrooms: 3	# of people: 3	Approved for Issuance by:
I certify that all the statements made in this application and any attached documents are true, complete and correct to the best of my knowledge and belief and are made in good faith. I understand that false information may be grounds for rejection of this application. Authorized county representatives are granted right of entry to make evaluations or inspections and to release information upon public request.		

Call Environment Health (496-8100) between 8:00 AM and 9:00 AM Monday thru Friday to schedule an appointment with the environment health specialist to evaluate your lot. He/She will show you where to locate the well and septic system, in relation to the desired dwelling location and any property lines. If approved, an improvements permit will be issued. After the septic tank has been installed and approved, the Sanitarian will issue a certification of completion.

Ed Mitchell
 (Signature of Contractor, Authorized Agent or Owner)

10 104 101
 Date

Franklin County Zoning Permit



FRANKLIN COUNTY

Franklin County, North Carolina

Planning Department

215 E Nash Street, Louisburg, North Carolina 27549

496-2909

Zoning Permit Number: 1155

ADDRESS: **HARDWOOD DRIVE**

PARCEL NO.: **1846-47-6891**

ZONING: **AR**

SUBDIVISION: **STONEFIELD**

LOT: **55**

ISSUED TO: **MITCHELL, EDWARD SHANE**

650 JOHN SANDLING ROAD

FRANKLINTON, NC 27525

SETBACK: FRONT: **30** RIGHT: **10** LEFT: **10** REAR: **25**

COUNTY WATER: **COUNTY** FLOODPLAIN: **NO**

PERMIT TYPE: **ZONING PERMIT**

DETAILS: **SINGLE FAMILY DWELLING**

PERMIT DATE: **10/04/2001**

WATERSHED **NO**

FEE: **\$0.00**

TOWNSHIP **FRA**

EXPIRE DATE: **04/04/2002**

It is hereby certified that the above use as shown on the plats and plans submitted with the application conforms with all applicable provisions of the Franklin County Zoning Ordinance. The issuance of this Permit does not allow the violation of Franklin County Zoning Ordinances or other governing Regulations.

The applicant is responsible for obtaining a building permit (if required) prior to commencing work on the proposed improvement. A final zoning inspection must be scheduled by the applicant.

APPROVED BY:

Zoning Inspector

DATE:

10/04/2001

Lot # 55
Stonefield Sub

Phase III

Map Book 2001

Page # 362

Owner / Developer


Edward Shane Mitchell

650 John Sandling Rd

Franklinton NC 27525

(H) 919-494-1041

(M) 919-417-6073

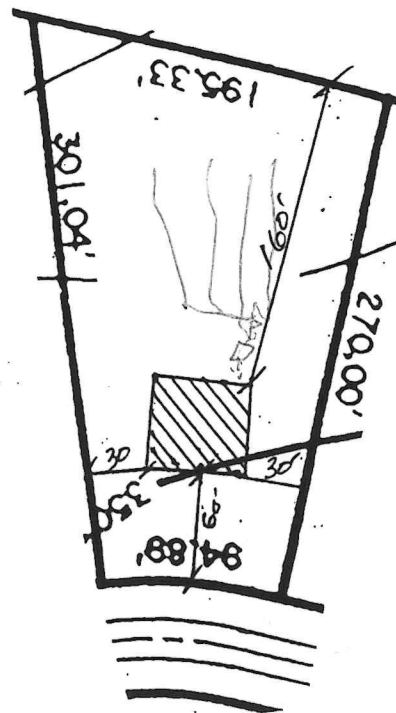

0.920
ACRES

55

Hardwood Dr

Scale 1" = 100'

House 50' x 50'