

PERMIT NUMBER 1174

GRANVILLE-VANCE DISTRICT HEALTH DEPARTMENT IMPROVEMENT AND OPERATION PERMITS

COUNTY:	TAX NO.	TYPE OF ESTABLISHMENTS			*THIS PERMIT SHALL BE ACCOMPANIED BY A LAYOUT SHOWN ON A PLAT, INCLUDING SYSTEM REQUIREMENTS.
Granville	LOT SIZE <u>1.60 AC</u>	RESIDENCE ☒ BUSINESS ☐ OTHER ☐ WATER SUPPLY WELL ☒ PUBLIC ☐ TYPE OF WASTEWATER SYSTEM	NUMBER OF BEDROOMS: <u>4</u>	NUMBER OF OCCUPANTS: <u>8 MAX</u>	
APPLICANT'S NAME & ADDRESS Wynn Construction, Inc. 2550 Capital Dr. Ste. 105 Creedmoor, NC 27622		DESIGN FLOW:	<u>480 gpd</u>	<u>Same</u>	*THIS IMPROVEMENT PERMIT IS SUBJECT TO REVOCATION IF THE INTENDED USE CHANGES FROM THOSE SHOWN ON THE IMPROVEMENT PERMIT. CHANGES SHALL REQUIRE HEALTH DEPARTMENT APPROVAL.
		LTAR:	<u>0.3 gpd/ft²</u>		
SUBDIVISION: <u>Weatherby</u>	ABSORPTION AREA:	<u>1200 ft²</u>			
LOT NUMBER: <u>025</u>	TRENCH WIDTH	<u>3'</u>			
REFERENCE SKETCH (SEE PLAT FOR DETAILS)	TRENCH DEPTH:	<u>22-24"</u>			
o Stay min. 5' off porch/foundations w/ system <u>AND</u> foundation drains o Stay off bad topography o system layed out in field by soil scientist (see attached) o stay off buffer o maintain all setbacks o keep system min. 50' off retention pond	TRENCH SPACING:	<u>9' o.c.</u>			
	TOTAL TRENCH LENGTH:	<u>400'</u>			
	NUMBER OF TRENCHES:	<u>1 (serial)</u>			
	GRAVEL / ACCEPTED:	<u>Accepted</u>			
	TANK SIZE:	<u>1000 gallon</u>			
	PUMP TANK SIZE:	<u>-</u>		PERMIT VALID FOR: 5 YEARS ☒ YES ☐ NO	
	DISTRIBUTION DEVICE:	<u>"D" BOX</u>			NO EXPIRATION YES ☒ NO ☐

IMPROVEMENT PERMIT
FOR: Wynn const.

DATE: 8-10-18

ISSUED BY: Wynn const.

CONSTRUCTION AUTHORIZATION FOR IMPROVEMENT PERMIT# 1174

Unless otherwise indicated, the same conditions above apply regarding system type, layout, location and installation requirement.
(The wastewater system cannot be installed until authorization is signed)

Comments: Contractor to establish & follow contour!

Date: 8-10-18

Environmental Health Specialist: [Signature]

Construction Authorization Addendum ☒ Yes ☐ No


OPERATION PERMIT


DATE:

SYSTEM INSTALLED BY: _____

ISSUED BY: _____

PERFORMANCE, MONITORING, MAINTENANCE AND OPERATION
AS REQUIRED BY R.U.F. 1961

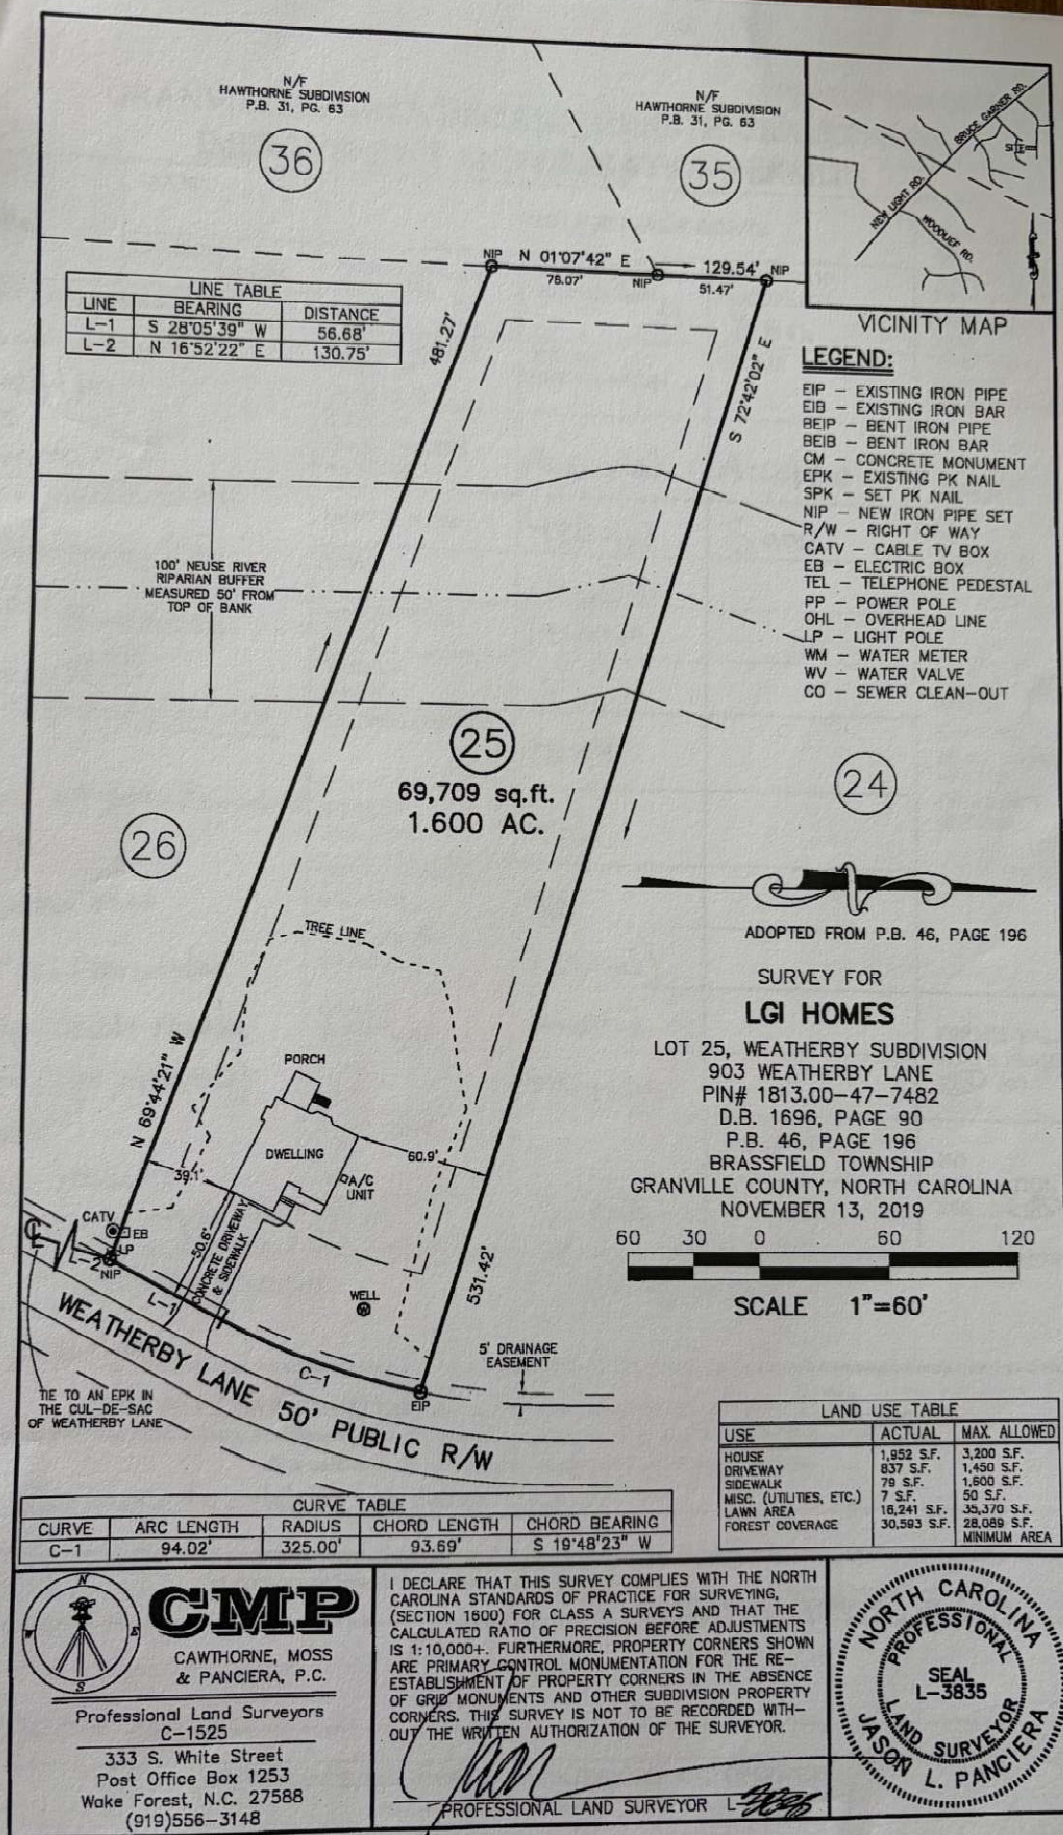


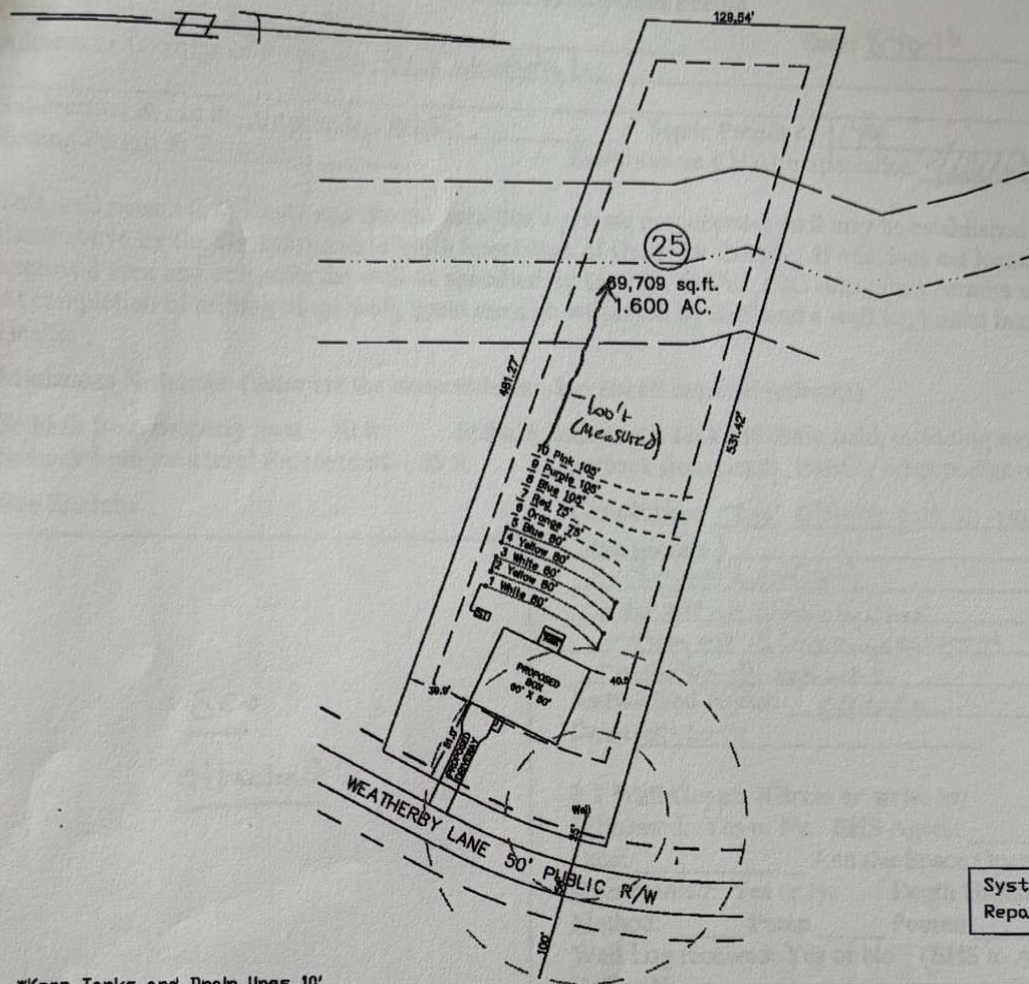

System: _____
 Repair: - - - - -


- Keep Tanks and Drain Lines 10' from property lines.
- Not a Survey
- Not a guarantee of a septic permit.
- Keep supply lines >5' from property lines.
- Some lines are flagged longer in the field than lengths indicated above.
- No foundation drains.

GRAPHIC SCALE
 1" = 100'

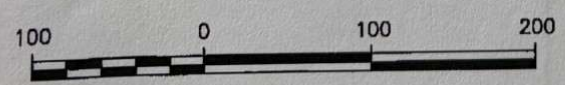

System: Gravity to Serial
 Lines: 1-5, (400')
 0.3 Soil LTAR
 24" Trench Bottom
 Accepted Status System

Repair: Gravity to Serial
 Lines: 6-10, (465')
 0.3 Soil LTAR
 24" Trench Bottom
 Accepted Status System

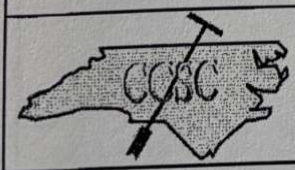

Central Carolina Soil Consulting, PLLC
 1900 South Main Street, Suite 110
 Wake Forest, North Carolina 27587
 Phone (919)569-6704 Fax (919)569-6703

Septic Site Plan
 Lot 25 Weatherby Subdivision
 Granville County, North Carolina

Job# : 1818
Drawn By : AH
Date : 08/9/2018
Revisions:

Granville County Health Department
Environmental Health

Pin _____

Improvement Permit

Permit Number 1174 (septic)

Construction Authorization 2605 (well)

Site Sketch

Wynn Const.
Applicants Name

Weatherby ZS (903 Weatherby Ln.)
Subdivision - Section - Lot

WMOB
Authorized State Agent

8-10-18
Date

System components represent approximate contours only. The contractor must flag the system prior to beginning the installation to insure that proper grade is maintained.

