



OPERATION PERMIT

Franklin County Health Department
107 Industrial Drive
Louisburg, NC 27549
Phone:

For Office Use Only

*CDP File Number 464728 - 1

County ID Number:

Evaluated For: NEW

Property Owner: Huntsburg Development LLP
Owner Address: PO BOX 337

City: Atlantic Beach
State/Zip: NC/ 28512
Phone #:
Address: 220 Whistlers Cove
Louisburg, NC 27549

Road #:
Township:
Subdivision: Huntsburg
Phase : NEW Lot: 28

Structure: SINGLE FAMILY

of Bedrooms: 4

of People: 8

Water Supply: NEW WELL

Saprolite System?: ☐ Yes ☒ No

Pump Required?: ☐ Yes ☒ No

Design Flow: 480

System Classification/Description: Type IIa - Conventional System

Installer: DBS

Specific System EZFLOW EZ 1203H-GEO
Installed:

STB: 502

PT:

Comments:

Certification #:

Septic Tank Date: 04/06/2026

Pump Tank Date:

This system has been installed in compliance with applicable NC General Statutes, Rules for Sewage Treatment and Disposal, and all conditions of the Improvement Permit and Construction Authorization.

PERMIT CONDITIONS:

I. Performance: System shall perform in accordance with Rule .1301.

II. Monitoring: As required by Rule .1301.

III. Maintenance: Ground absorption sewage treatment and disposal systems shall be checked, and the contents of the septic tank removed, periodically from all compartments, to ensure proper operation of the system. The contents shall be pumped whenever the solids level is found to be more than 1/3 of the liquid depth in any compartment.

Other:

Subsurface Operator Required: ☐ Yes ☒ No

If yes, see attached sheet for additional operation conditions, maintenance and reporting.

Operation:

Other:

Authorized State Agent: Jones, Lori

Date of Issue: 04/29/2026

Owner/Applicant:



File # 464728 PIN# _____

Property Address: 220 Whistlers Cove

Applicant or Owner Name: Braelyn Momes

Environmental Health Septic/Well Permit Diagram

Building permits cannot be issued nor should construction begin without Construction Authorization issuance.

☒ Septic Improvement Permit ☒ Septic Construction Authorization (CA) ☒ CA Reissue** ☒ As Built
☒ Well Construction Authorization ☒ Additional Diagram/Specifications Attached

Diagram Date**: 1/2/26 EHS: [Signature]


**Any previously dated CA diagram is revoked and/or invalid. Confirm this is the valid diagram for the site before beginning any construction.

Installation/grouting inspections may be scheduled the day before, or, the day of installation until 9am by contacting the Environmental Health office at 919 496 8100. A revisit fee may apply if installation is not ready for inspection at the time requested. Septic Operations Permits will be issued after installation is approved, all permits conditions are met, and any outstanding fees are paid. Well Certificate of Completion will be issued after well head approval, all permit conditions are met, and any outstanding fees are paid.

Septic Tank 1000 Pump Tank — Drainfield 3x350' Type System C/A Max Trench Depth 30"
Septic Contractor DBS Septic/Pump tank dates 4-6-26 502 Pump Fee Paid _____

Well Contractor _____ Well Head Date: _____ Pump Final: _____ N/A (circle)

350' Accepted drainline
or
440' gravel

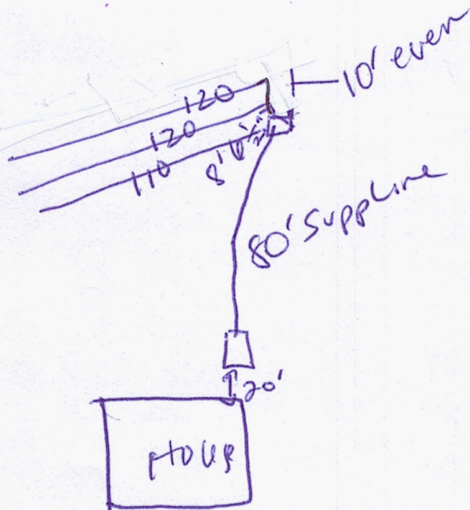

E2flow
dbox

