

FRANKLIN COUNTY HEALTH DEPARTMENT


9199770860

PERMIT NUMBER: 11714C	CONST IMPROVE PERMIT	DATE: 10.02.98	25032	SIZE:
APPLICANT: EATON WANDA JEAN 4529 GRAY ROCK RD KITTRELL NC 27544 TELEPHONE: COMMENT: 603-6949		OWNER: EATON WANDA JEAN 4529 GRAY ROCK RD KITTRELL NC 27544		
LOCATION / DIRECTIONS: 56 to Fric 7/4 Rd Mitchell Rd (past Barclayton Mills on L) T/R Allen Rd 7/4		DESCRIPTION: 5 YEAR ☒		LIFETIME: ☐
FEE: 125.00		SIGNATURE OR OWNER OR AUTHORIZED AGENT: off permit cut and on 12		

THE ABOVE SIGNATURE INDICATES THAT I HAVE READ, UNDERSTAND, AND AGREE WITH ALL PROVISIONS AND INFORMATION AS OUTLINED ON THE BACK SIDE OF THIS FORM

TOPO <u>PS</u>	TEXTURE <u>PS</u>	STRUCTURE <u>PS</u>	DEPTH <u>PS</u>
R. HOR <u>—</u>	SOIL. WET <u>—</u>	AVAIL. SP <u>—</u>	OTHER <u>—</u>
MINRL <u>Next</u>	OVERALL <u>PS</u>	LTAR <u>.49/d</u>	
#BEDRMS <u>4</u>	GPD <u>48096</u>	DISPOSAL <u>—</u>	TYPE. SYS <u>C</u>
SZ. TANK <u>1000</u>	SZ. CHAMB <u>—</u>	NITRIFI <u>3x400</u>	TYPE. WAT <u>pub</u>
SITE. LOC <u>—</u>	MAX TRENCH DEP <u>30"</u>	TYP. FAC <u>SFD</u>	

REMARKS: 5' deep 10' from property line, 5' from back of house and 100' from wells.
 * Suggest use of in-ground system with 25% redaction/chamber, (88222 way) to maximize repair area

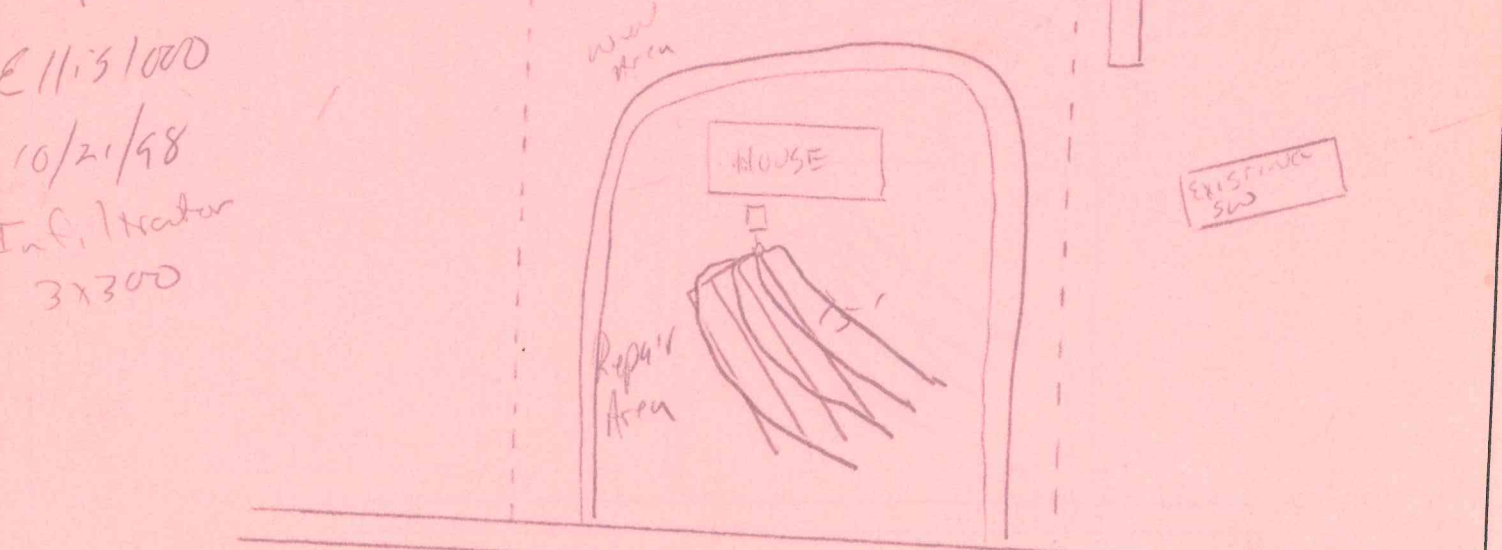

IMPROVEMENT PERMIT DATE: <u>10/14/98</u>	ENV HEALTH SPEC: <u>[Signature]</u>
INSTRUCTION AUTHORIZATION DATE: <u>10/14/98</u>	ENV HEALTH SPEC: <u>[Signature]</u>
ERATION PERMIT DATE: <u>12/1/98</u>	