

FRANKLIN COUNTY HEALTH DEPARTMENT


11:30

PERMIT NUMBER: 49451 IMPROVEMENTS PERMIT	DATE: 06.18.93	4469-110	SIZE: .69A
APPLICANT: POPE & POPE P O BOX 640 YOUNGSVILLE NC 27596 TELEPHONE: 556-6152		OWNER: FARMLAND ASSOCIATES LTD	
COMMENT: SFD		CONTRACTOR: Joel Power	
LOCATION / DIRECTIONS: MILL CREEK IV LOT 110			
FEE: 50.00 7073		SIGNATURE OF OWNER OR AUTHORIZED AGENT:	

THE ABOVE SIGNATURE INDICATES THAT I HAVE READ, UNDERSTAND, AND AGREE WITH ALL PROVISIONS AND INFORMATION AS OUTLINED ON THE BACK SIDE OF THIS FORM

6-6-94 mill 900

#BEDRMS <u>3</u>	DISPOSAL <u>No</u>	OTHER <u>-</u>	TYPE.SYS <u>C</u>
SZ.TANK <u>900</u>	SZ.CHAMB <u>-</u>	NITRIFI <u>3'x35'</u>	OPER.REQ <u>No</u>
SITE.LOC <u>-</u>			
REMARKS: <u>Shallow - 22" max! Follow contour. 100' from wells & 10' from prop lines</u>			

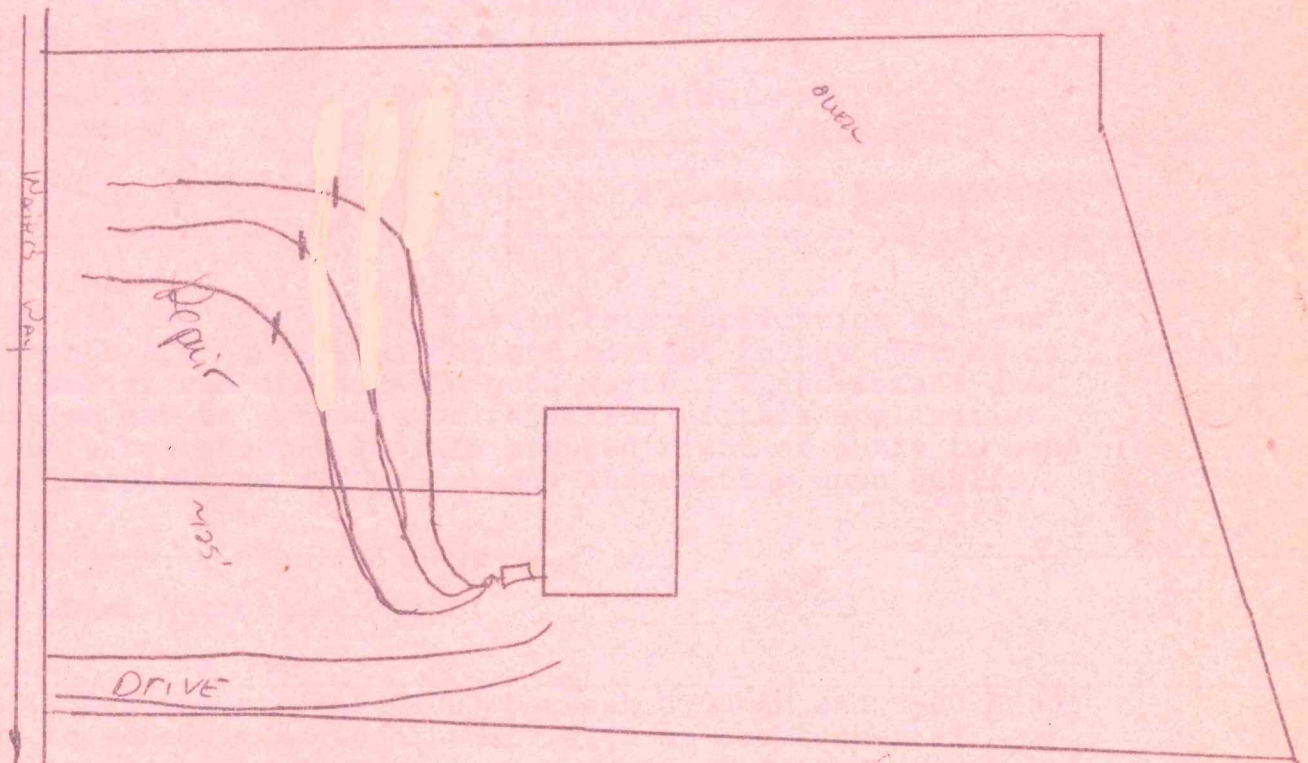

DATE ISSUED 7-7-93

EH SPECIALIST Chris Hedrick

DATE APPROVED 8/2/94

EH SPECIALIST E. L. Lohm