

GRANVILLE-VANCE HEALTH DEPARTMENT—Sewage Disposal Record

1656 Owner or Contractor Pearlie E. Parrish Date Feb 1, 90 S.R. No. 1622
 Location/Address Route # 1 Franklin Twp N.C.
 Subdivision/Mobile Home Park Name Sandy Creek Lot Size 3.30 acres
 Lot No. 32

New System ☒ Repair _____
 House ☒ Mobile Home _____ Business _____
 No. Bedrooms 3 No. People 1 No. Toilets 2
 Water Supply: Private ☒ Approved _____
 Semi-Public _____ Unapproved _____
 Public _____ None _____

Nitrification System:


Tank Size 900 gal.
 Distribution Box yes No. Lines 3
 Nitrification Field 320' x 960' Sq. Ft.
 Lines: 1 2 3 4 5 6
 Width 36" 36" 36" _____
 Length 120' 160' 40' _____
 Grade 2" 3" 0" _____
 Stone Depth 12" 12" 12" _____

Layout to be followed by installer:

Improvements Permit By Bobby E. Greene Installer Robert T Blackley
 Certificate of Completion By Bobby E. Greene Date of Inspection April 16, 1990

* Construction must comply with all other applicable state and local regulations, but the permit is not a guarantee that the system will not malfunction and the Granville-Vance Health District will not be held responsible for a malfunctioning system.

NOTE: Make sketch of installation showing location of house, septic tanks, privies, water supplies on adjacent property, etc. Write in measurements in order that installations may be located at later date.

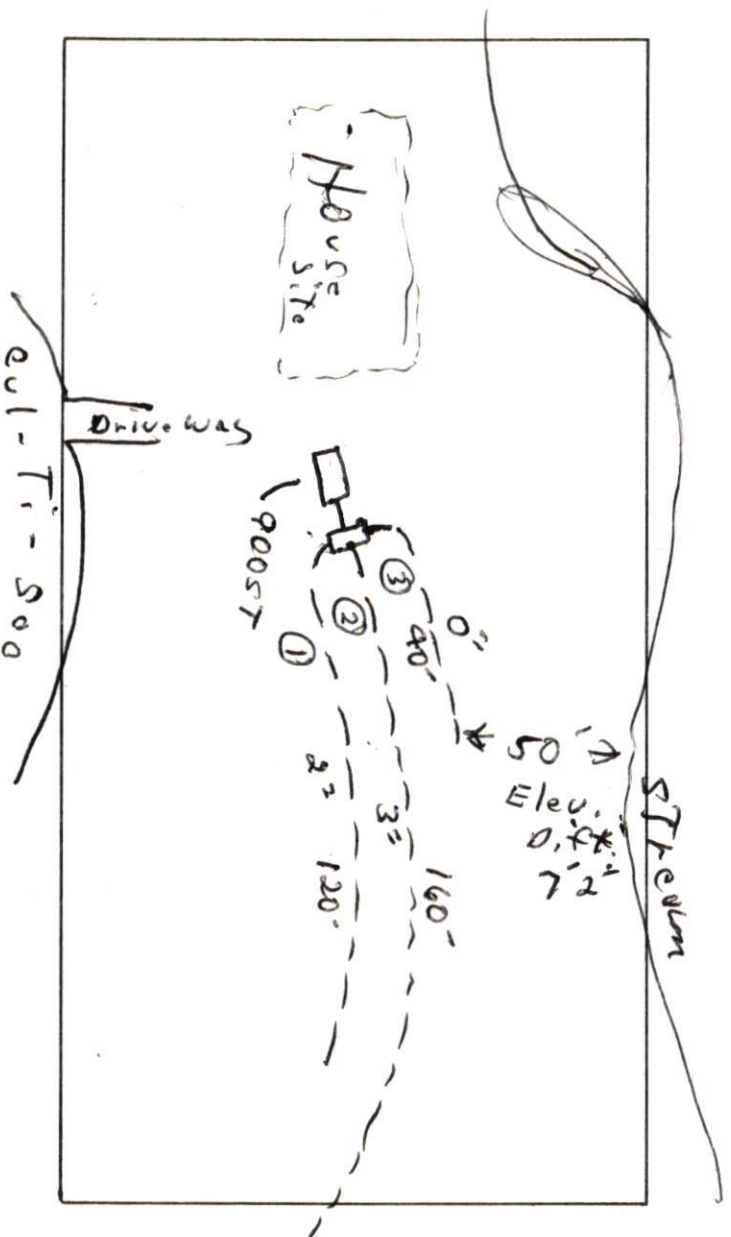

Environmental Health

Well Construction Permit


Owner/Applicant: Kevin Bockelman Date: 9-11-12
 Address or Location of Property: Cannedy Mill Rd → Sandy Creek Dr. → go to
end and house is in center of cul-de-sac
 Subdivision & Lot #: Sandy Creek lot # 32 Septic Permit #: 1656
 Zoning Permit #: - Environmental Health Specialist: Casey Champion

This well permit is to locate and site the area that a private groundwater well may be established on the property listed above by the Environmental Health Specialists of Granville County. If one does not locate the well in the approved area and complete the well as specified by the 15A NCAC .02C rules, then permits may be revoked. At completion of drilling of the well, grout must be witnessed by EHS and a well log turned into Environmental Health.

Minimum Setbacks: (these are the main setbacks, but not all required setbacks)

Setback from property lines – 10 ft Setback from septic tank and drain field, including repair area – 100 ft
 Setback from structural foundations – 25 ft Setback from ponds, lakes or other bodies of water – 50 ft

Site Sketch:

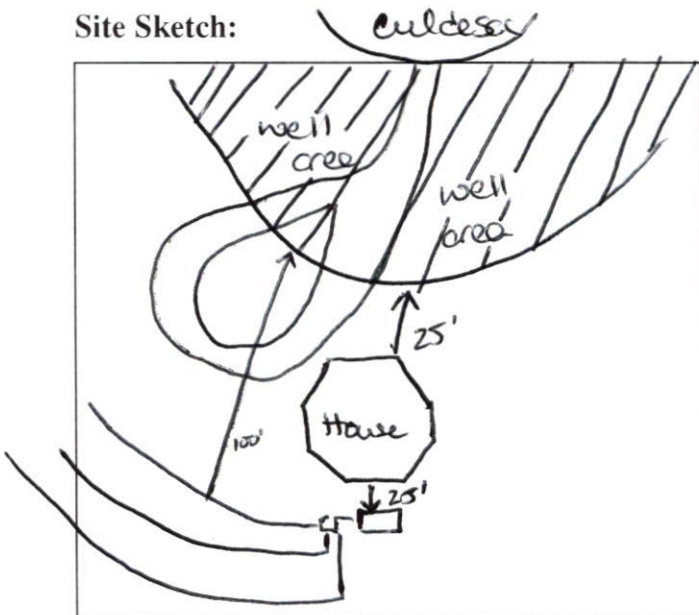

Conditions:

Authorized Agent: Casey Champion REHS
 Date: 9-11-12

1 Well Grout: (Circle or write in)

Witnessed: Yes or No EHS Agent: _____
 Date: _____ Annular Space Open: Yes or No
 Over reamed: Yes or No Depth Grouted: _____
 Method: _____ Pump _____ Poured _____ Pressure
 Well Log received: Yes or No (EHS to Attach to Permit)
 Driller Name: _____ Cert. # _____
 Depth: _____ Casing Depth: _____ GPM: _____

2 Well Final: (Place a check mark when finalized)

Seal Present and Intact: _____ Air Vent: _____
 Hose Spigot: _____ Electrical Box: _____
 Pump Installer Tag: _____ Well Installer Tag: _____
 All holes sealed: _____ 12" above grade: _____
Comments: _____

3 Well Completion Permit: _____ EHS
Date Completed: _____

4 Water Samples Taken: Date: _____
 EHS: _____ Results: _____
 Retest: _____ Results: _____

As Built Drawing:

