

Franklin County Health Department
Division of Environmental Health
107 Industrial Drive-Suite C
Louisburg, North Carolina 27549

Phone: 919-496-8100

SEPTIC PERMIT

Fax: 919-496-8136

Permit Number: 8042 Type: I PIN: 1881-52-0716 Date: 4/15/2015

Applicant: CAMBRIDGE CLASSIC HOMES LL Owner: XR LLC
2519 VILLAGE MANOR WAY
RALEIGH, NC 27614

Telephone: (919) 730-6277

Telephone:

Subdivision: WYNDEN PLACE

Lot Number: 51

Size: 1.280

Physical Address/ Location /Directions 105 CARRIDEN DR.

Description: LifeTime _____ 5 Year XTYPE FACIL SFD # EMPLOY 1 # BEDRMS 4 GPD 480 LTAR 39/dTYPE WAT Com TYPE SYS A TYPE REP P10A BSMT N BST FX N/ASIZE TANK 1000 SIZE CHB 1 SIZE NITR 3'x4'x0' MTD 23"COMMENTS: 400' Auger drill drainline

Septic Contractors are responsible for notifying the health department for final inspections, between 8:00-9:00 AM on the day of completion, Monday - Friday. Any request for final inspections received afterwards will be scheduled the same day, if possible, or the next workday. Have permit number and owner/applicant's name ready when making the call.

Actions of representatives of state or local agencies engaged in the evaluation and determination of measures required to effect the compliance with the provisions of this permit shall in no way be taken as a guarantee that wastewater disposal systems permitted and approved will function in a satisfactory manner for any given period of time, or that such employees assume any liability for damages, consequential or direct which are caused, or may be caused, by a malfunction of this wastewater treatment and disposal system.

Proper precautions must be taken to assure the proper functioning of the system after it has been covered. Do not run any heavy equipment over the system, as soft earth will allow damage to the tank and lines. Pipe all roof drains away from the septic system site to prevent flooding of the lines from surface water. Terrace the ground to prevent excessive drainage from higher areas adjacent to the system. Do not construct driveways over any part of the septic system unless proper provisions were made when the septic system was constructed. Only grass, not trees or shrubbery, should be cultivated over the lines. All plumbing fixtures should be carefully inspected periodically and any problems repaired immediately. All septic tanks should be pumped off by a permitted pump operator on a regular schedule, not to exceed every five years.

The improvement permit and construction authorization is a site approval, for the future installation of a wastewater treatment and disposal system. Changes in ownership of the site do not affect the validity of this permit. However, any alteration of the site or soil conditions, changes in the location of the proposed facility, changes to the wastewater flow and/or characteristics, or submittal of false information with the application or misrepresentation of the property lines may subject this permit to suspension or revocation.

FOR THIS TO BE A VALID CONSTRUCTION AUTHORIZATION, A LAYOUT SHEET MUST BE ATTACHEDIMPROVEMENT PERMIT DATE 5/10/15 EHS [Signature]CONSTRUCTION AUTHORIZATION DATE 5/10/15 EHS [Signature]Vist www.franklincountyenvironmentalhealth.com for permit information and tracking.

Franklin County Health Department


Name: CAMBRIDGE CLASS

Permit Number

8042

CONTRACTOR Quality TANK MANU mills 1000s MANU DATE 6-9-15
 WELL INSTALLED YES _____ NO X SYSTEM CODE EZ1203-W-6

SEPTIC SYSTEM LAYOUT (SKETCH SYSTEM LAYOUT HERE)

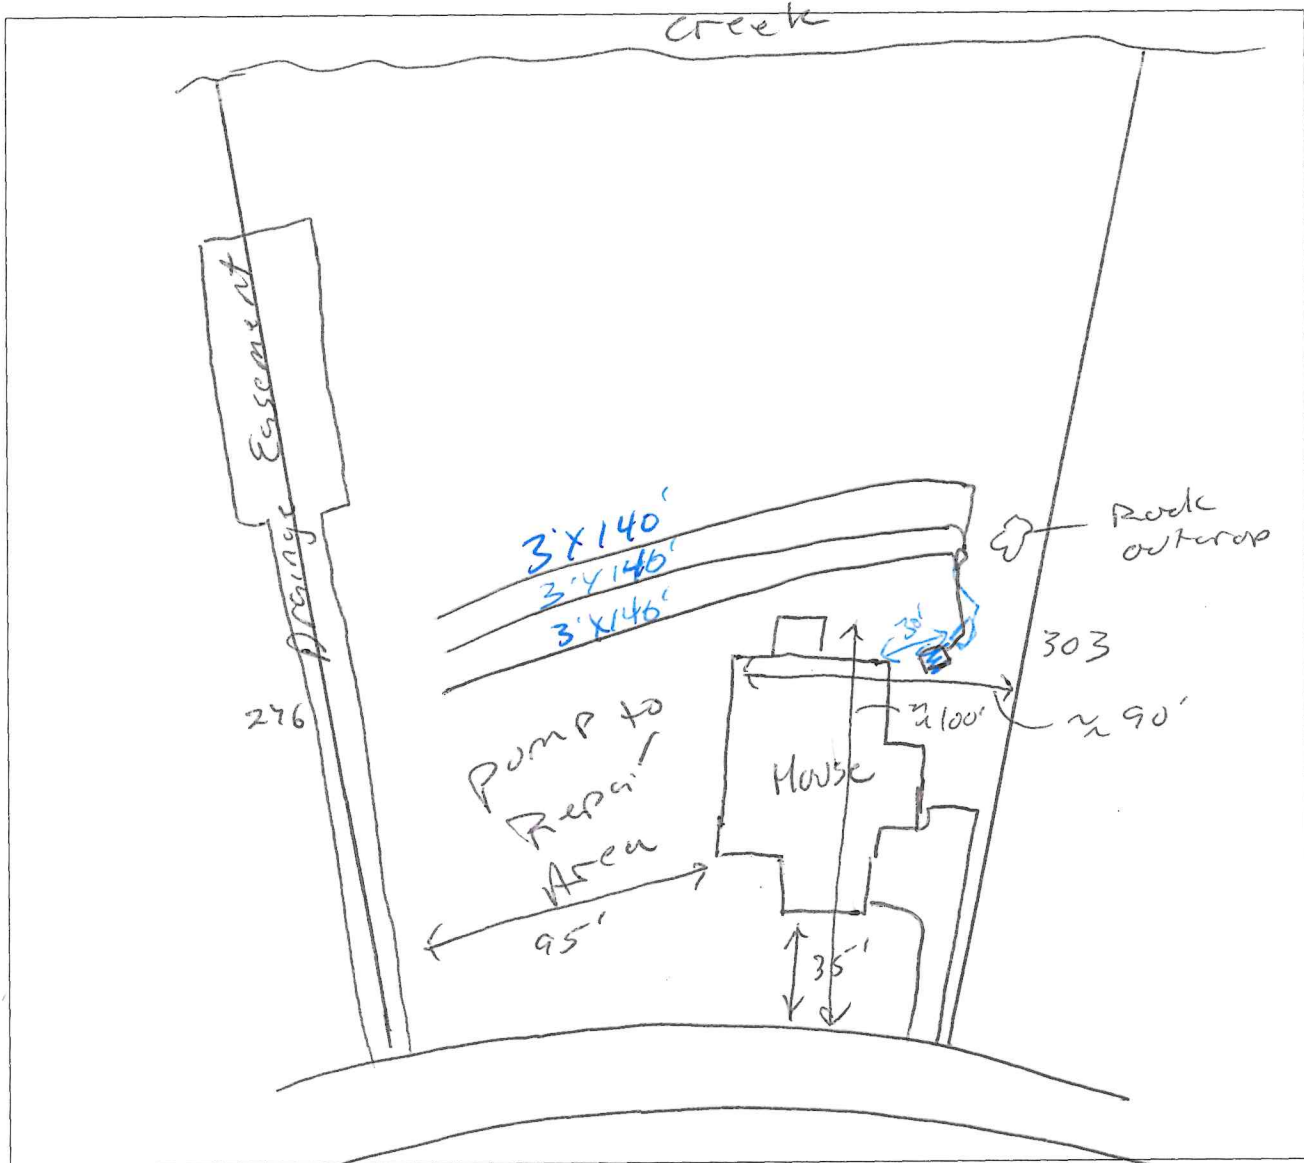

SEPTIC SYSTEM AS-BUILT (IF DIFFERENT FROM INITIAL LAYOUT) ON REVERSE

OPERATIONS PERMIT

DATE

9-2-15

EHS

COUNTY OF FRANKLIN

ENVIRONMENT HEALTH APPLICATION (496-8100)

Permit #: 38628

Permit Type: SEPTIC PERMIT

Date Issued: 04/15/2015

Project Address: 105 CARRIDENT DR., YOUNGSVILLE, NC 27596

Location: 105 CARRIDENT DR.

Size #: 1.280

Subdivision: WYNDEN PLACE

Lot #: 51

Applicant: CAMBRIDGE CLASSIC HOMES LLC
2519 VILLAGE MANOR WAY
RALEIGH NC 27614

Phone: 919.730.6277

Owner Name: XR LLC

Phone:

Owners Address:

Tax record: 42378

Pin #: 1881-52-0716

Parcel #: F09J00 051

Zoned: R-15

Setbacks Front: 30

Rear: 25

Side: 10

Proposed Use: SFD

of bedrooms: 3

of people: 3

Township: HARRIS

Public Water/Sewer: COUNTY

ST Road #:

Desc:

Fees Due: \$400.00

Date Paid: 04/15/2015

* Please complete all sections below*

☐ Yes ☐ No Does this site contain any previously identified jurisdictional wetlands?
☐ Yes ☐ No Is any wastewater, other than domestic, going to be generated?
☐ Yes ☐ No Is the site subject to approval by any other public agency?

*If the answer to any of the above is "yes", applicant must submit supporting documentation.

Please indicate desired system type(s). Systems can be ranked in order of preference.

☐ Conventional ☐ Accepted ☐ Modified Conventional ☐ Alternative
☐ Other ☐ No Preference


Call Environmental Health (919.496.8100) between 8:00 - 9:00 am Monday - Friday in order to schedule an appointment with an environmental health specialist for your lot evaluation. This application for an improvement permit/construction authorization and well permit does not constitute approval for zoning, septic or building permits. It will be necessary to meet all guidelines for zoning, septic and building permits prior to construction. The permit is valid for either 60 months or without expiration, depending upon documentation submitted. (complete site plan=60 months---complete surveyed plat=without expiration.)

Please contact the Environmental Health Department at 919.496.8100 or visit their website at www.franklincountyenvironmentalhealth.com to determine the status of your application prior to visiting the Planning & Inspections Department to obtain a building permit.

I hereby certify that I am the owner, or authorized by the owner to act as his/her legal representation. Furthermore, as legal representative (if applicable) I have advised the owner of my intention to apply for this wastewater treatment and disposal system and drinking water and well system permit.

I also certify that all of the statements made in this application and any attached documents are true, complete, and correct, to the best of my knowledge and belief, and are made in good faith. If information in this application for these improvements is falsified, changed or site is altered, then improvement permits and authorization to construct these improvements shall become invalid. Authorized county representatives are granted right of entry to make these evaluations or inspections, and to release information upon public request.

X D. KEITH WOOD

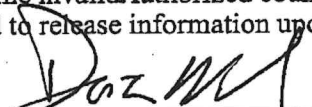

04/15/2015

Print & Signature of Owner or Owner's Legal Representative

