


NOTE: Make sketch of installation showing location of house, septic tanks, privies, water supplies on adjacent property, etc. Write in measurements in order that installations may be located at later date.

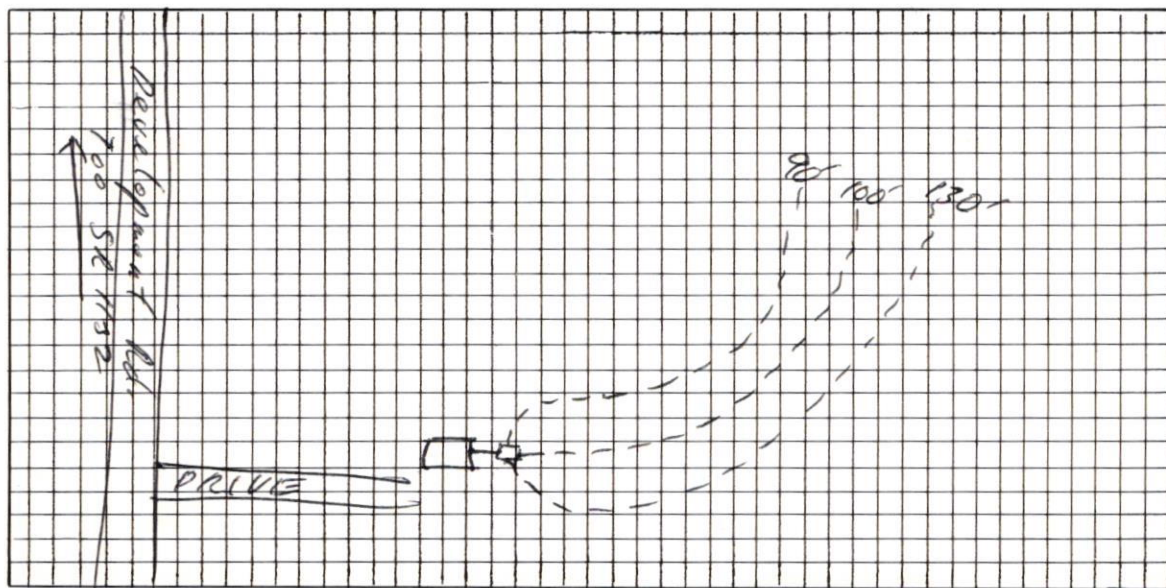

NO. 3693 SEWAGE DISPOSAL RECORD — GRANVILLE COUNTY

Owner ☒ Mr. James B. Willette

RPD-Street Rt. 1, Stem, N.C.

Tenant ☐ _____

SR No. 1132

Subdivision Name Deerfield I

Lot No. 32 Section or Block No. _____

New System ☒ Repairs ☐ Privy ☐

Nitrification System:

House ☐ Trailer ☒ Business ☐

Tank Size 900 Gal.

No. Bedrooms For Garbage Disposal ☐ Yes ☒ No

Distribution Box yes

No. Bathrooms Port Auto. Dishwasher ☐ Yes ☒ No

Nitrification Field 960 Sq. Ft.

No. in Family _____ Auto. Washing Machine ☒ Yes ☐ No

Nitrification Lines 320' Length

Nitrification Line 36" Width

Water Supply: Individual ☒ Public ☐

No. Nitrification Lines 3

Lot Area 1.31 ac.

Stone Depth 12"

*Remarks _____

Grade Boards Yes ☐ No ☒

Improvements Permit By Bobby E. Greene Date May 14, 84

Certificate of Completion By James C. Parrott Date 6-15-84

Installed By Wm. Biggs