

919-882-0822

PAGE 1 OF 2

**Franklin County Health Department  
Environmental Health Section  
107 Industrial Drive-Suite C  
Louisburg, North Carolina 27549**

Phone: 919-496-8100

Fax: 919-496-8136

Permit Number: 66      Type: I      PIN: 2811-57-8636      Date: 12/2/03

Applicant: DICKERSON BUILDERS  
PO BOX 326  
LOUISBURG, NC 27549

Owner: RIDGECO LLC  
112 STRATFORD  
LOUISBURG, NC 27549

Telephone: (919) 496-1527

Telephone: (919) 340-1166

Subdivision: RIDGE HAVEN

Lot Number: 47

Size: .7

Physical Address/ Location /Directions TWIN CREEK DR

Description: LifeTime \_\_\_\_\_ 5 Year X

TYPE FACIL SFD # EMPLOY ✓ # BEDRMS 3 GPD 360 LTAR 35 1/2  
TYPE WAT Com TYPE SYS Com TYPE REP Com BSMT ✓ BST FX ✓  
SIZE TANK 900 SIZE CHB ✓ SIZE NTR 3x350 MTD 30"

COMMENTS → Tank/ Septic System placement may be determined by Rock

Septic Contractors are responsible for notifying the health department for final inspections, between 8:00-9:00 AM on the day of completion, Monday - Friday. Any request for final inspections received afterwards will be scheduled the same day, if possible, or the next workday. Have permit number and owner/applicant's name ready when making the call.

Actions of representatives of state or local agencies engaged in the evaluation and determination of measures required to effect the compliance with the provisions of this permit shall in no way be taken as a guarantee that wastewater disposal systems permitted and approved will function in a satisfactory manner for any given period of time, or that such employees assume any liability for damages, consequential or direct which are caused, or may be caused, by a malfunction of this wastewater treatment and disposal system.

Proper precautions must be taken to assure the proper functioning of the system after it has been covered. Do not run any heavy equipment over the system, as soft earth will allow damage to the tank and lines. Pipe all roof drains away from the septic system site to prevent flooding of the lines from surface water. Terrace the ground to prevent excessive drainage from higher areas adjacent to the system. Do not construct driveways over any part of the septic system unless proper provisions were made when the septic system was constructed. Only grass, not trees or shrubbery, should be cultivated over the lines. All plumbing fixtures should be carefully inspected periodically and any problems repaired immediately. All septic tanks should be pumped off by a permitted pump operator on a regular schedule, not to exceed every five years.

The improvement permit and construction authorization is a site approval, for the future installation of a wastewater treatment and disposal system. Changes in ownership of the site do not affect the validity of this permit. However, any alteration of the site or soil conditions, changes in the location of the proposed facility, changes to the wastewater flow and/or characteristics, or submittal of false information with the application or misrepresentation of the property lines may subject this permit to suspension or revocation.

**FOR THIS TO BE A VALID CONSTRUCTION AUTHORIZATION, A LAYOUT SHEET MUST BE ATTACHED**

IMPROVEMENT PERMIT

DATE 1/16/04 EHS [Signature]

CONSTRUCTION AUTHORIZATION

DATE 1/16/04 EHS [Signature]

# Franklin County Health Department

Name: DICKERSON BUILD

Permit Number


66

CONTRACTOR David Brantley TANK MANU 3/12/04 MANU DATE DOB 1000


WELL INSTALLED AT TIME OF INSPECTION YES NO

STD 409  
"Short 1000"

## SEPTIC SYSTEM LAYOUT (SKETCH SYSTEM LAYOUT HERE)

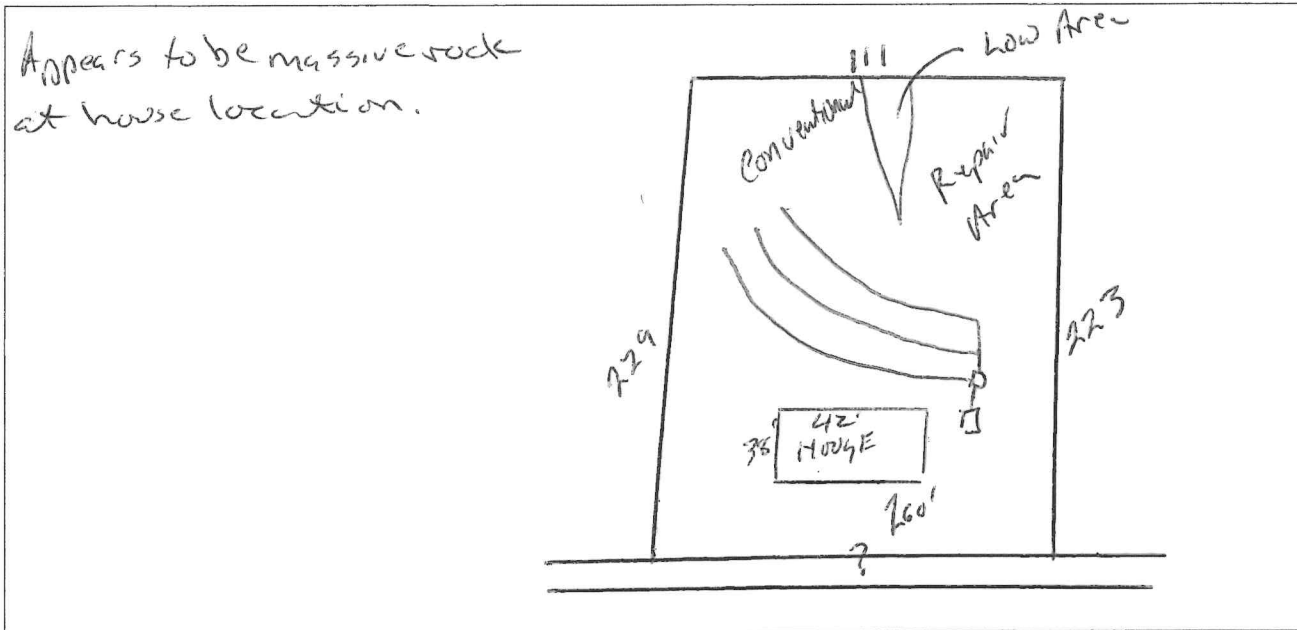

## SEPTIC SYSTEM AS-BUILT (IF DIFFERENT FROM INITIAL LAYOUT)

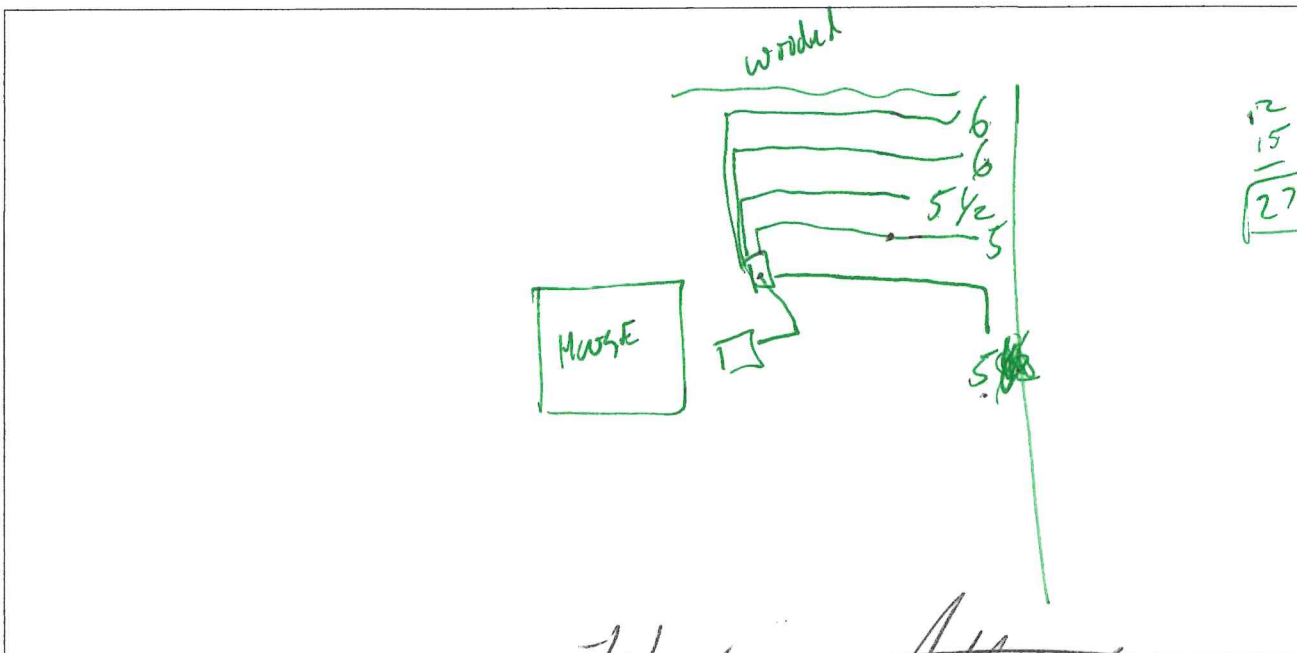

OPERATIONS PERMIT

DATE

3/4/04

EHS

*[Signature]*

## ENVIRONMENT HEALTH APPLICATION (496-8100)

Permit #: 10803

Permit Type: SEPTIC PERMIT

Date Issued: 11/25/2003

Project Address: RIDGE HAVEN DRIVE, LOUISBURG, NC 27549

Location: RIDGE HAVEN DRIVE

Size #: 0.700

Subdivision: RIDGE HAVEN (WATER)

Lot #: 47

Applicant: DICKERSON BUILDERS

Phone: 919-496-1527

Post Office Box 326

Louisburg

Owner: RIDGECO LLC

Phone: 340-1166

112 STRATTFORD DR

LOUISBURG NC 27549

Tax record: 35189

Pin #: 2811-57-8636

Parcel #: I10B00 047

Zoned: R-30

Setbacks Front: 30

Rear: 25

Side: 10

Proposed Use: SFD

# of bedrooms: 3

# of people: 3

Type Wastewater -

Sewage: \_\_\_\_\_

Industrial Process Wastewater: \_\_\_\_\_

Type Water Supply -

Private: \_\_\_\_\_

Community: \_\_\_\_\_

Previously Identified Jurisdictional Wetland -

Yes: \_\_\_\_\_

No: \_\_\_\_\_

Township: HARRIS

Public Water/Sewer: COUNTY

ST Road #:

Desc:

Fees Due: \$225.00

Date Paid: 11/25/2003

Special Conditions:

Call Environment Health (496-8100) between 8:00 AM and 9:00 AM Monday thru Friday to schedule an appointment with the environment health specialist to evaluate your lot. He/She will show you where to locate the well and septic system, in relation to the desired dwelling location and any property lines. If approved, an improvements permit will be issued. After the septic tank has been installed and approved, the Sanitarian will issue a certification of completion.

I certify that all the statements made in this application and any attached documents are true, complete and correct to the best of my knowledge and belief and are made in good faith. I understand that false information may be grounds for rejection of this application. Authorized county representatives are granted right of entry to make evaluations or inspections and to release information upon public request.

K. Scott Ure  
(Signature of Contractor, Authorized Agent or Owner)

11/25/03  
Date