

IMPROVEMENT PERMIT

Granville County Health Dept
Environmental Health
101 Hunt Drive
Oxford, NC 27565
Phone: (252) 492-5263 Fax: (252) 492-2361

For Office Use Only

*CDP File Number 367707 - 1
County ID Number: 192500384171
Evaluated For: NEW

PERMIT VALID UNTIL: 03/29/2027

***NOTE TO INSPECTIONS DIVISION:** Building Permits cannot be issued with this Improvement Permit.

Applicant: Clayton Homes
Address: 1582 US HWY1
City: Youngsville
State/Zip: NC 27596
Phone #: home: (919) 422-9311

Property Owner: Jeanmarie Rowena
Address: 6667 Brame Drive
City: Oxford
State/Zip: NC. 27565
Phone #:

Property Location & Site Information

Address/Road #: Brame Drive Oxford, NC 27565 Subdivision: Penny Hill Phase: NEW Lot: 9

Directions

Structure: SINGLE FAMILY
of Bedrooms: 3
of People: 6
*Water Supply: NEW WELL

System Specifications

Initial System

*Site Classification: Provisionally Suitable
Design Flow: 360
Soil Application Rate: 0.2500
*System Classification/Description:
TYPE III B. SYSTEM W/SINGLE EFFLUENT PUMP
*Proposed System:
25% REDUCTION

Minimum Trench Depth: 13 Inches
Maximum Trench Depth: 15 Inches
Septic Tank: 1000 Gallons
Pump Required ☒ Yes ☐ No ☐ May Be Required
Pump Tank: 1000 Gallons

Repair System Required: ☒ Yes ☐ No ☐ No, but has Available Space

Repair System

*Site Classification: PS w/Fill
Soil Application Rate: 0.300
*System Classification/Description:
TYPE III B. SYSTEM W/SINGLE EFFLUENT PUMP
*Proposed System:
FILL/MOUND

Minimum Trench Depth: _____ Inches
Maximum Trench Depth: _____ Inches
Pump Required: ☒ Yes ☐ No ☐ May Be Required
Pump Tank: 1000 Gallons

No grading or construction activity is allowed in areas designated for system and repair without approval of Health Department

***Site Modifications**

All property lines must be marked prior to the septic system being installed.

system is flagged onsite

The issuance of this permit by the Health Department in no way guarantees the issuance of other permits. The permit holder is responsible for checking with appropriate governing bodies in meeting their requirements.

***Permit Conditions**

Do not install when soil is wet. Septic contractor is responsible for establishing and following contour in the designated soil area (follow site sketch). Septic contractor is responsible for maintaining all setbacks. Call the Health Department with any

The Department and Local Health Department may impose conditions on the issuance and may revoke the permits for failure of the system to satisfy the conditions, the rules, or this article. This permit is subject to revocation if the site plan, plat, or intended use changes (NCGS 130A-335(f)). The person owning or controlling the system location, installing, operation, maintenance, monitoring, reporting, and repair (1938(b)).

Authorized State Agent:

Stiles, Bailey

Bailey Stiles

Date of Issue:

03/29/2022

Total Time: (HH:MM)

☒ Hand Drawing

☐ Import Drawing

****Site Plan/Drawing attached.****

Granville-Vance Dist. Health Department
Environmental Health

Pin 19250038 4171

P-367707

Permit Number S-258988

☒ Improvement Permit

☒ Construction Authorization W-264552

SITE SKETCH
ON-SITE / WELL

CMH Homes / Jeanmarie Rowena
Applicants Name

Brame Dr
Address

Penny Hill - #9
Subdivision - Section - Lot


Bailey Stiles
Authorized State Agent

06-07-2022
Date

System components represent approximate contours only. The contractor must flag the system prior to beginning the installation to ensure that proper grade is maintained.

* pre installation meeting advised.

* contractor to install on contour.

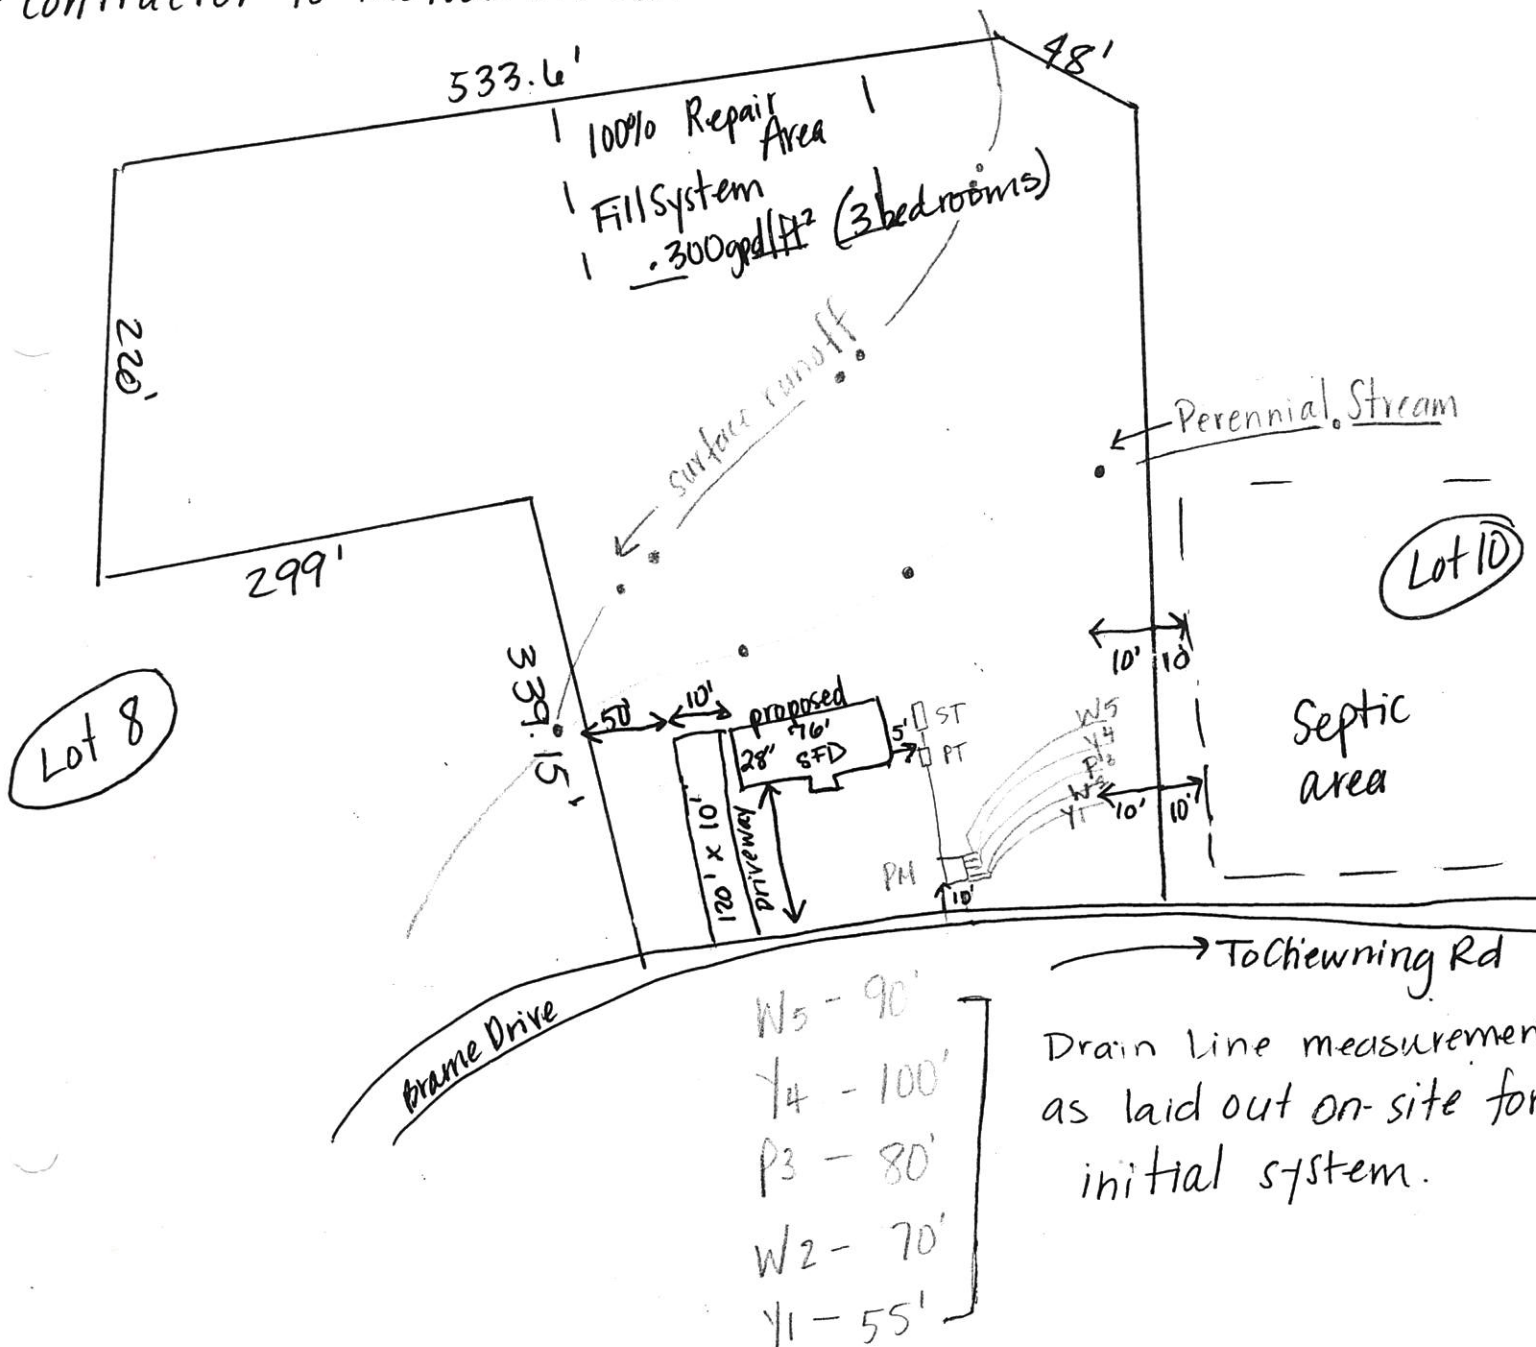

Well Construction Permit

Granville County Health Dept
Environmental Health
101 Hunt Drive
Oxford NC, 27565
Phone: (252) 492-5263 Fax: (252) 492-2361

For Office Use Only

*CDP File Number 367707

PIN Number: 192500384171

Tax Lot #: 9

Tax Block #:

Evaluated For:

SINGLE FAMILY \ WELL

Property Owner: Jeanmarie Rowena

Address: 6667 Brame Dr

City: Oxford

State/Zip: NC / 27565

Phone #: H: (919) 570-3366

Applicant: CMH Homes, Inc.

Address: 1582 US 1

City: Youngsville

State/Zip: NC / 27596

Phone #: H: (919) 570-3366

Property Location & Site Information

Address/Road #:

Subdivision: Penny HillPhase: _____ Lot: 9

Brame Drive

Oxford NC, 27565

*Proposed use of Well: SINGLE FAMILY

If Other:

Applicant Email:

Owner Email:

Directions:

Well Contractor Information

Drilling Contractor:

Driller Registration:

Permit Conditions

***Permit Conditions**

This permit is issued to the applicant for the purpose of drilling a new well in the proposed area. Follow site sketch, well contractor is responsible for maintaining all setbacks.

Well location, construction and protection must meet all state and local regulations and must be inspected and approved by an authorized representative of the Local Health Department. The permit may be revoked at any time for failure to comply with existing regulations. The siting of approved well construction area(s) by the Health Department is to provide protection from the known possible sources of contamination. The approved well area(s) may not be changed without permission from an authorized representative of the Local Health Department. Issuance of this well permit does not guarantee water quality or adequate water production from the well once it is installed or repaired.

*Issued By: Stiles, Bailey

Authorized State Agent:

Owner/Applicant:

*Date of Issue: 03/29/2022



☒ Hand Drawing



☐ Import Drawing

****Site Plan/Drawing attached.****