


FRANKLIN COUNTY HEALTH DEPARTMENT

PERMIT NUMBER: CONST IMPROVE PERMIT		DATE: 11-98	29660	SIZE: 2.05A
APPLICANT: WIGGINS GUY 1097 FLAT ROCK CHURCH RD LOUISBURG NC 27549		OWNER: WINTERS MELVIN		
TELEPHONE: 556-1763				
COMMENT: SFD	DESCRIPTION: 5 YEAR ☒		LIFETIME: ☐	
LOCATION / DIRECTIONS: SR 1107 Winters Woods Lot #2				
FEE: 125.00		SIGNATURE OR OWNER OR AUTHORIZED AGENT:		
7571				

THE ABOVE SIGNATURE INDICATES THAT I HAVE READ, UNDERSTAND, AND AGREE WITH ALL PROVISIONS AND INFORMATION AS OUTLINED ON THE BACK SIDE OF THIS FORM

TOPO <u>PS</u>	TEXTURE <u>PS</u>	STRUCTURE <u>PS</u>	DEPTH <u>PS</u>
R. HOR <u>1</u>	SOIL. WET <u>1</u>	AVAIL. SP <u>1</u>	OTHER <u>1</u>
MINRL <u>NEXP</u>	OVERALL <u>PS</u>	LTAR <u>35' 1/4</u>	
#BEDRMS <u>3</u>	GPD <u>360%</u>	DISPOSAL <u>1</u>	TYPE. SYS <u>PROC</u>
SZ. TANK <u>900</u>	SZ. CHAMB <u>1000</u>	NITRIFI <u>3'x265'</u> <u>w/25% reduction</u>	TYPE. WAT <u>Pri</u>
SITE. LOC <u>1</u>	MAX TRENCH DEP <u>30"</u>	TYP. FAC <u>SFD</u>	

REMARKS: Stay 10' from property lines, 5' from building foundation and 100' from wells.

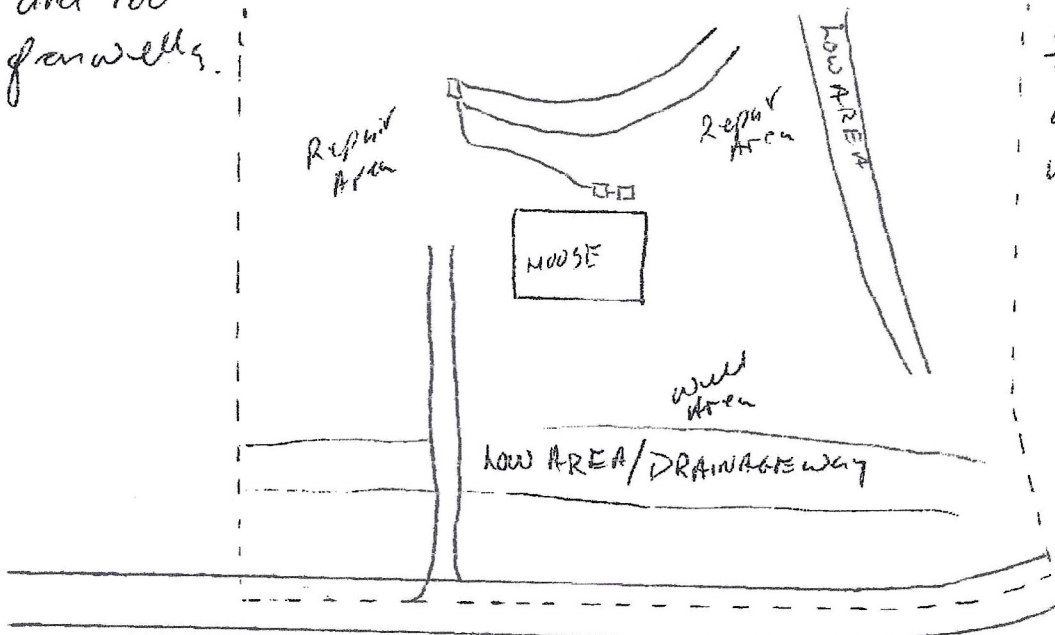

* Must use chamber & EZ lay system w/25% reduction

IMPROVEMENT PERMIT DATE: 11/9/98

ENV HEALTH SPEC: [Signature]

CONSTRUCTION AUTHORIZATION DATE: 11/9/98

ENV HEALTH SPEC: [Signature]

OPERATION PERMIT DATE: _____

ENV HEALTH SPEC: _____