

Retire
Franklin County Health Department
Division of Environmental Health
107 Industrial Drive-Suite C
Louisburg, North Carolina 27549

PAGE 1 OF 2

919-573-0443

ab4god81@yahoo.com

brantleyar@gmail.com
Fax: 919-496-8136

Phone: 919-496-8100

SEPTIC PERMIT

Permit Number: 8591 Type: I PIN: 2718-05-0120 Date: 2/19/2016

Applicant: ANTHONY BAKER Owner:
2104 KING MALCOLM LN
ZEBULON, NC 27597

Telephone: (919) 815-1066 Telephone:

Subdivision: Lot Number: 3 Size: 1.250

Physical Address/ Location /Directions WILLIAMS WHITE RD

Description: LifeTime _____ 5 Year X

TYPE FACIL Per # EMPLOY N/A # BEDRMS 3 ⁴ GPD 360 ⁴⁸⁰ LTAR .25
TYPE WAT Per TYPE SYS A TYPE REP A BSMT N/A BST FX N/A
SIZE TANK 500 ¹⁰⁰⁰ SIZE CHB N/A SIZE NITR 360 ^{3x 480} MTD 36 ⁴

COMMENTS:

480' Accepted drawing
\$150 Revision fee must be paid before 07

*Revision to
480R
10/18/16 JRW*

Septic Contractors are responsible for notifying the health department for final inspections, between 8:00-9:00 AM on the day of completion, Monday - Friday. Any request for final inspections received afterwards will be scheduled the same day, if possible, or the next workday. Have permit number and owner/applicant's name ready when making the call.

*Revision
fee 11-1-16*

Actions of representatives of state or local agencies engaged in the evaluation and determination of measures required to effect the compliance with the provisions of this permit shall in no way be taken as a guarantee that wastewater disposal systems permitted and approved will function in a satisfactory manner for any given period of time, or that such employees assume any liability for damages, consequential or direct which are caused, or may be caused, by a malfunction of this wastewater treatment and disposal system.

Proper precautions must be taken to assure the proper functioning of the system after it has been covered. Do not run any heavy equipment over the system, as soft earth will allow damage to the tank and lines. Pipe all roof drains away from the septic system site to prevent flooding of the lines from surface water. Terrace the ground to prevent excessive drainage from higher areas adjacent to the system. Do not construct driveways over any part of the septic system unless proper provisions were made when the septic system was constructed. Only grass, not trees or shrubbery, should be cultivated over the lines. All plumbing fixtures should be carefully inspected periodically and any problems repaired immediately. All septic tanks should be pumped off by a permitted pump operator on a regular schedule, not to exceed every five years.

The improvement permit and construction authorization is a site approval, for the future installation of a wastewater treatment and disposal system. Changes in ownership of the site do not affect the validity of this permit. However, any alteration of the site or soil conditions, changes in the location of the proposed facility, changes to the wastewater flow and/or characteristics, or submittal of false information with the application or misrepresentation of the property lines may subject this permit to suspension or revocation.

FOR THIS TO BE A VALID CONSTRUCTION AUTHORIZATION, A LAYOUT SHEET MUST BE ATTACHED

IMPROVEMENT PERMIT

DATE 2/29/16 EHS [Signature]

CONSTRUCTION AUTHORIZATION

DATE 2/29/16 EHS [Signature]

Visit www.franklincountyenvironmentalhealth.com for permit information and tracking.

Franklin County Health Department

PAGE:

Name: BAKER

Permit Number

8591


CONTRACTOR David Brown TANK MANU AD 131000

WELL INSTALLED YES _____ NO _____

SYSTEM CODE

MANU DATE 4/2/11
32,207

SEPTIC SYSTEM LAYOUT (SKETCH SYSTEM LAYOUT HERE)

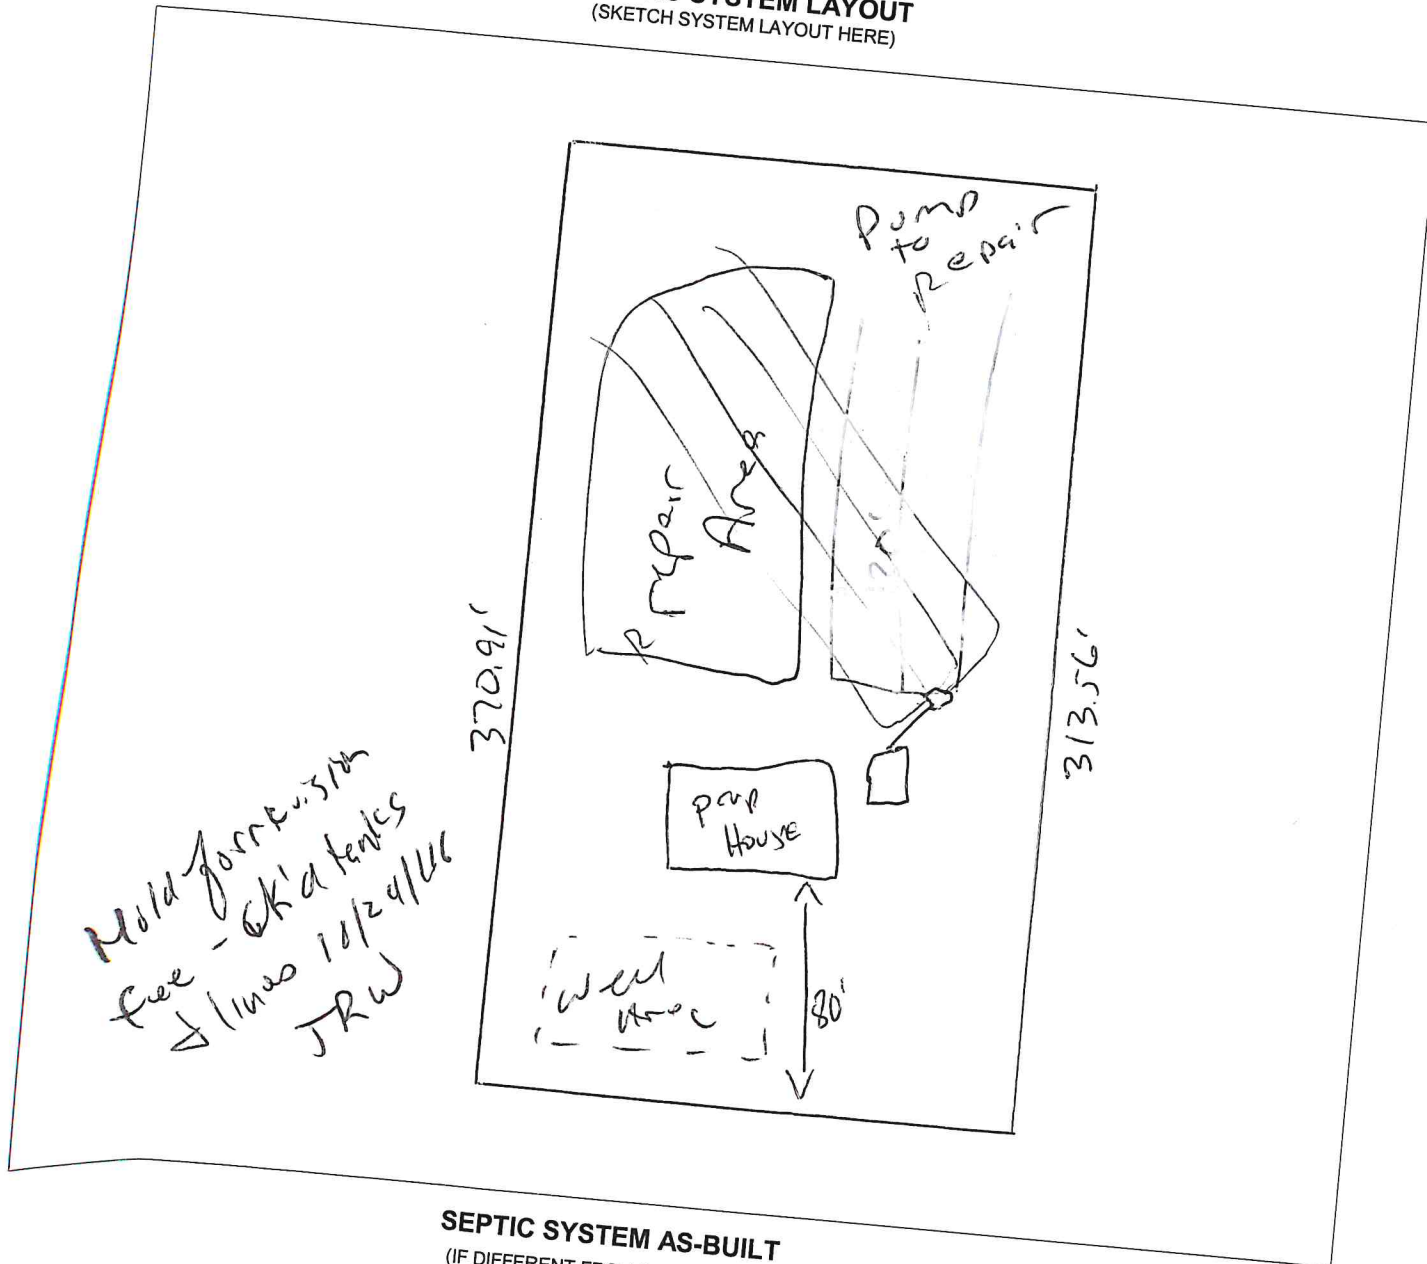

SEPTIC SYSTEM AS-BUILT (IF DIFFERENT FROM INITIAL LAYOUT)

ON REVERSE

OPERATIONS PERMIT

DATE

11/1/16

EHS

[Signature]