



OPERATION PERMIT

Franklin County Health Department
107 Industrial Drive
Louisburg, NC 27549
Phone:

For Office Use Only

*CDP File Number 336975 - 1
County ID Number: 1833-90-1069
Evaluated For: NEW

Property Owner: WHITEWATER HOMES INC

Address: PO BOX 1709

Road #:

City: WAKE FOREST

State/Zip: NC/ 27588

Phone #:

Township:

Subdivision: ADDYSON AT HOLDEN

Phase : NEW

Lot: 16

Structure: SINGLE FAMILY

of Bedrooms: 4

of People: 4

Water Supply: PUBLIC

Saprolite System?: ☐ Yes ☒ No

Pump Required?: ☐ Yes ☒ No

Design Flow: 480

System Classification/Description: TYPE II A. CONV SYSTEM
(SINGLE-FAMILY OR 480 GPD OR LESS)

Installer: DB & Sons

Certification #: 1036

Specific System EZFLOW EZ 1203H-GEO

Installed:

STB: 502

PT:

Comments:

Septic Tank Date: 02/23/2021

Pump Tank Date: _____

This system has been installed in compliance with applicable NC General Statutes, Rules for Sewage Treatment and Disposal, and all conditions of the Improvement Permit and Construction Authorization.

PERMIT CONDITIONS:

- I. Performance: System shall perform in accordance with Rule .1961.
- II. Monitoring: As required by Rule .1961.
- III. Maintenance: Ground absorption sewage treatment and disposal systems shall be checked, and the contents of the septic tank removed, periodically from all compartments, to ensure proper operation of the system. The contents shall be pumped whenever the solids level is found to be more than 1/3 of the liquid depth in any compartment.

Other:

Subsurface Operator Required: ☐ Yes ☒ No

If yes, see attached sheet for additional operation conditions, maintenance and reporting.


Operation:

Other:

Authorized State Agent: Ennis, Crystal

Date of Issue: 06/10/2021

Owner/Applicant: _____

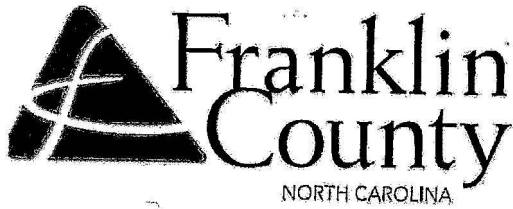

File # 336 975 PIN# 1833-90-1069

Property Address: 135 Anna Marie Way

Applicant or Owner Name: Allen Clark

Environmental Health Septic/Well Permit Diagram

Building permits cannot be issued nor should construction begin without Construction Authorization issuance.

☒ Septic Improvement Permit ☒ Septic Construction Authorization (CA) ☐ CA Reissue** ☐ As Built
☐ Well Construction Authorization ☒ Additional Diagram/Specifications Attached

Diagram Date**: 2-8-21 EHS: Cynthia Evers

**Any previously dated CA diagram is revoked and/or invalid. Confirm this is the valid diagram for the site before beginning any construction.

Installation/grouting inspections may be scheduled the day before, or, the day of installation until 9am by contacting the Environmental Health office at 919 496 8100. A revisit fee may apply if installation is not ready for inspection at the time requested. Septic Operations Permits will be issued after installation is approved, all permits conditions are met, and any outstanding fees are paid. Well Certificate of Completion will be issued after well head approval, all permit conditions are met, and any outstanding fees are paid.

Septic Tank 1000 Pump Tank 1 Drainfield 3' x 400' Type System Acc Max Trench Depth 30"

Septic Contractor DBB Sons Septic/Pump tank dates 2-23-21 ^{STB 502} DB 1006 Pump fee? ☒ NO ☐ YES pd


Well Contractor _____ Well Grout date: _____

See attached layout designed by CCSC #

vid tanks & pres 6/10/21

Cynthia Evers

*400' E21203
Installed*

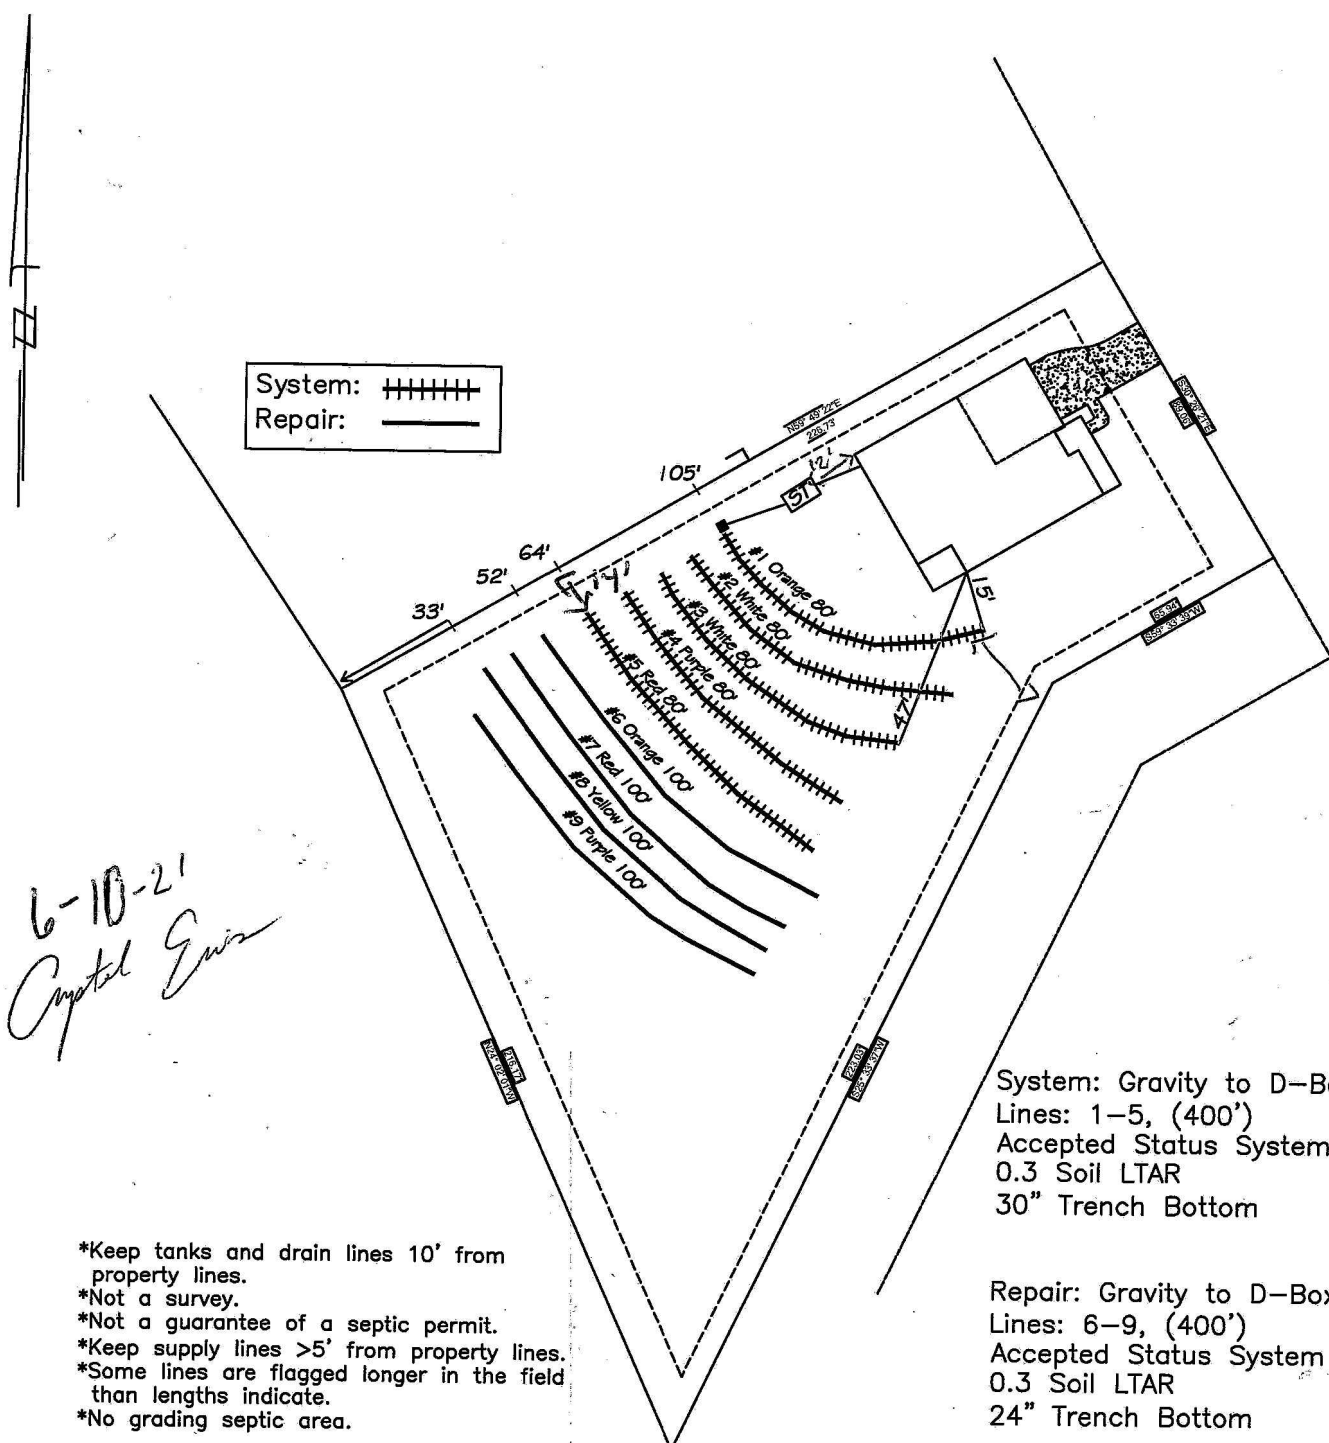

Central Carolina Soil Consulting, PLLC
1900 South Main Street, Suite 110
Wake Forest, North Carolina 27587
Phone (919)569-6704 Fax (919)569-6703

4-Bedroom Septic Layout
120 gal/day/bedroom
Lot 16, Addyson Subdivision
Franklin County, North Carolina

Job# : 3640
Drawn By : JH
Date : 2/3/2021
Revision: