

FRANKLIN COUNTY HEALTH DEPARTMENT

PERMIT NUMBER: 15073C CONST IMPROVE PERMIT	DATE: 20010321	1894-84-8146	SIZE: 0.690A
APPLICANT: HORTON HOMES 7324 CAPITAL BLVD RALEIGH NC 27616		OWNER: HORTON HOMES	
TELEPHONE: 830-9800			
COMMENT: MH		DESCRIPTION: 5 YEAR ☒	LIFETIME: ☐
LOCATION / DIRECTIONS: NORTH RIDGE ESTATES #12 - 125 NORTH RIDGE DR LRG			
FEE: 175.00		SIGNATURE OR OWNER OR AUTHORIZED AGENT:	


THE ABOVE SIGNATURE INDICATES THAT I HAVE READ, UNDERSTAND, AND AGREE WITH ALL PROVISIONS AND INFORMATION AS OUTLINED ON THE BACK SIDE OF THIS FORM

TOPO <u>PS</u>	TEXTURE <u>PS</u>	STRUCTURE <u>PS</u>	DEPTH <u>PS</u>
R. HOR <u>PS</u>	SOIL. WET <u>✓</u>	AVAIL. SP <u>✓</u>	OTHER <u>✓</u>
MINRL <u>5x8</u>	OVERALL <u>PS</u>	LTAR <u>34</u>	
#BEDRMS <u>3</u>	GPD <u>360</u>	DISPOSAL <u>✓</u>	TYPE. SYS <u>C</u>
SZ. TANK <u>500</u>	SZ. CHAMB <u>✓</u>	NITRIFI <u>34400</u>	TYPE. WAT <u>Cur</u>
SITE. LOC <u>✓</u>	MAX TRENCH DEP <u>24"</u>	TYP. FAC <u>500</u>	
REMARKS:			

CONTRACTOR: Charles Strickland
TANK MANUF: Ellis 900
MANUF DATE: 6/4/01

*Infiltrator System
48 panels*

** Place house
in 10' back from
R/W*

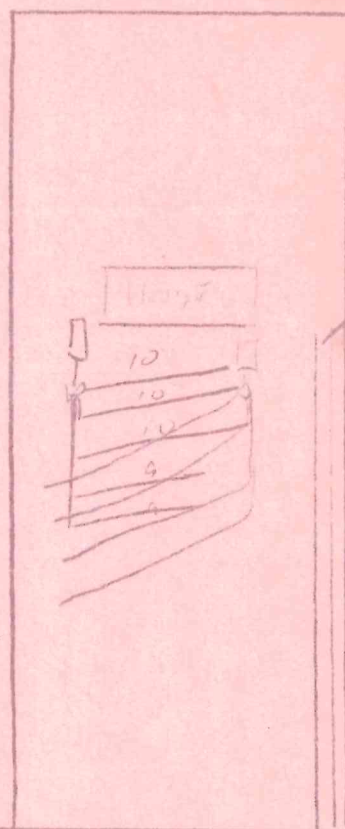

IMPROVEMENT PERMIT DATE: 3/26/2001
CONSTRUCTION AUTHORIZATION DATE: 3/26/2001
OPERATION PERMIT DATE: 9/7/01

ENV HEALTH SPEC: [Signature]
ENV HEALTH SPEC: [Signature]
ENV HEALTH SPEC: [Signature]

FRANKLIN COUNTY HEALTH DEPARTMENT

PERMIT NUMBER: 15073C CONST IMPROVE PERMIT 20010321	DATE: 1894-84-8146	SIZE: 0.690A
APPLICANT: HORTON HOMES 7324 CAPITAL BLVD RALEIGH NC 27616	OWNER: HORTON HOMES	
TELEPHONE: 830-9800		
COMMENT:	DESCRIPTION: 5 YEAR ☒	LIFETIME: ☐
LOCATION / DIRECTIONS: NORTH RIDGE ESTATES #12 - 125 NORTH RIDGE DR LRG		
FEE: 175.00	SIGNATURE OR OWNER OR AUTHORIZED AGENT:	


THE ABOVE SIGNATURE INDICATES THAT I HAVE READ, UNDERSTAND, AND AGREE WITH ALL PROVISIONS AND INFORMATION AS OUTLINED ON THE BACK SIDE OF THIS FORM

TOPO <u>PS</u>	TEXTURE <u>PS</u>	STRUCTURE <u>PS</u>	DEPTH <u>PS</u>
R. HOR <u>PS</u>	SOIL. WET <u>PS</u>	AVAIL. SP <u>PS</u>	OTHER <u>PS</u>
MINRL <u>368P</u>	OVERALL <u>PS</u>	LTAR <u>PS</u>	
#BEDRMS <u>3</u>	GPD <u>200</u>	DISPOSAL <u>PS</u>	TYPE. SYS <u>C</u>
SZ. TANK <u>600</u>	SZ. CHAM <u>1</u>	NITRIFI <u>3000</u>	TYPE. WAT <u>Com</u>
SITE. LOC <u>1</u>	MAX TRENCH DEP <u>20"</u>	TYP. FAC <u>500</u>	
REMARKS:			

CONTRACTOR: Charles Strickland
TANK MANUF: Ellis 900
MANUF DATE: 6/4/01

Infilt water system
44 panels

+ place house
5' to 6' from
R/W

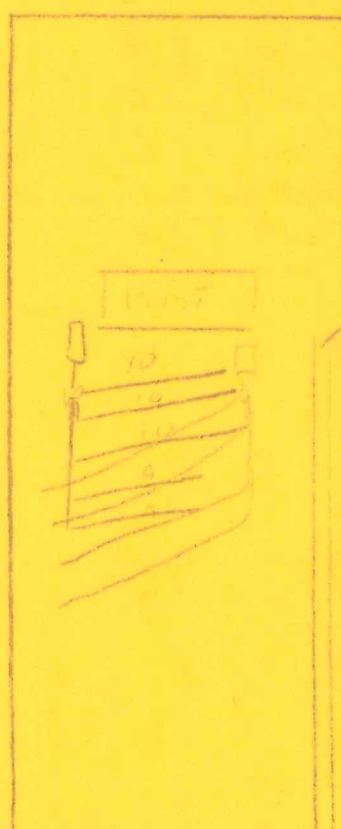

IMPROVEMENT PERMIT DATE: 3/26/2001
CONSTRUCTION AUTHORIZATION DATE: 3/26/2001
OPERATION PERMIT DATE: 9/7/01

ENV HEALTH SPEC: [Signature]
ENV HEALTH SPEC: [Signature]
ENV HEALTH SPEC: [Signature]

ENVIRONMENT HEALTH APPLICATION (496-8100)

Permit #: **2492**Permit Type: **SEPTIC PERMIT**Date Issued: **03/02/2001**Project Address: **NORTH RIDGE DR 125, YNGS**Location: **NORTH RIDGE DR 125**Lot #: **12**Subdivision: **NORTH RIDGE ESTATES**Size #: **0.690**Applicant: **HORTON HOMES
7324 CAPITAL BLVD.
RALEIGH, NC 27616**

Phone:

Contractor:

Phone:

Proposed Use: **DOUBLEWIDE**
Work:
Desc: **1894-84-8146**

Bldg Cost: \$0	Fees Due: \$175.00	Date Paid: 03/02/2001
Zoned: A R	Setbacks Front: 30	Rear 25 Side 10
Tax record: 34012	Pin #: 1894-84-8146	Parcel #: G07B00 012
Township: HARRIS	Public Water/Sewer: PRIVATE	ST Road #: 1110
Special Conditions/Property Owner: HORTON HOMES		
# of bedrooms: 3		
# of people: 3		
Approved for Issuance by:		
I certify that all the statements made in this application and any attached documents are true, complete and correct to the best of my knowledge and belief and are made in good faith. I understand that false information may be grounds for rejection of this application. Authorized county representatives are granted right of entry to make evaluations or inspections and to release information upon public request.		

Call Environment Health (496-8100) between 8:00 AM and 9:00 AM Monday thru Friday to schedule an appointment with the environment health specialist to evaluate your lot. He/She will show you where to locate the well and septic system, in relation to the desired dwelling location and any property lines. If approved, an improvements permit will be issued. After the septic tank has been installed and approved, the Sanitarian will issue a certification of completion.

Devon M. Magee
(Signature of Contractor, Authorized Agent or Owner)

03/02/01
Date

Franklin County Zoning Permit

FRANKLIN COUNTY

Franklin County, North Carolina

Planning Department

215 E Nash Street, Louisburg, North Carolina 27549

496-2909



Zoning Permit Number: 0307

ADDRESS: NORTH RIDGE DR 125

PARCEL NO.: 1894-84-8146

ZONING: A R

SUBDIVISION: NORTH RIDGE ESTATES LOT: 12

ISSUED TO: HORTON HOMES
7324 CAPITAL BLVD.
RALEIGH, NC 27616

PERMIT TYPE: ZONING PERMIT

DETAILS:

PERMIT DATE: 03/02/2001

WATERSHED NO

FEE: \$0.00

TOWNSHIP HAR

EXPIRE DATE: / /

It is hereby certified that the above use as shown on the plats and plans submitted with the application conforms with all applicable provisions of the Franklin County Zoning Ordinance. The issuance of this Permit does not allow the violation of Franklin County Zoning Ordinances or other governing Regulations.

The applicant is responsible for obtaining a building permit (if required) prior to commencing work on the proposed improvement. A final zoning inspection must be scheduled by the applicant.

APPROVED BY:

DATE:

03/02/2001


Zoning Inspector

for 1 d

UNIFIED DEVELOPMENT ORDINANCE (UDO) PERMIT

PROPERTY INFORMATION

Current Property Owner _____ Daytime Phone # 830-9800

Applicant 7324 Capital Blvd

Address Raleigh, NC 27616

Tax Parcel - (old) 0071300 012 (new) 1994-84-8146

Tax Record # 34012 Lot Size .69 State Road # 1110

Township Harris

Subdivision Name & Record Plat # North Ridge

ir "Lot of Record" Deed Ref (<Db. 850 Pg. 373) _____

E-911 Address _____ Census Tract # _____

UTILITY SERVICE

* — Water - Private Well # _____, or Utility Name _____
Sewer - Private Septic # _____, or Utility Name _____
Electric - _____ Premises Acct # _____

LAND USE and ORDINANCE REVIEW as follows:

Existing Land Use - Mobile 301/28th

Base Zoning - AR

Setbacks - Front 30 Back 25 Side 10

Floodplain _____ yes x no _____

Overlay Districts as Follows:

Watershed - NONE, or Compliance required per approved site plan

Airport - NONE, or Compliance required per approved site plan

Thoroughfare Plan - NONE, or Compliance per approved site plan

Conditional Use Permit Name and # - _____

Special Use Permit Name and # - _____

Sign Ordinance Compliance per attached signage construction drawing (Commercial)
(drawings must be approved prior to final certification)


Planning & Development Staff

3/2/01
Date

Lot 12

Review Officer of FRANKLIN County,
to which this certification is
requirements for recording.

11-14-00
DATE:

STATE OF NORTH CAROLINA Franklin COUNTY

Filed for Registration at 4:00 P M.

November 14 2000 in the

Register of Deeds Office

Recorded in Book 2000 Page 401

REGISTER OF DEEDS

BY

