



**Franklin County Health Department
Environmental Health Section
107 Industrial Drive-Suite C
Louisburg, North Carolina 27549**

PAGE 1 OF 2

Phone: 919-496-8100

Fax: 919-496-8136

Permit Number: 2824 Type: I PIN: 2821-30-8507 Date: 7/12/2006
 Applicant: MICHAEL ALFORD Owner: HOYT & ILA B MEDLIN
 105 BLACK CLOUD DR 614 ALFORD MILL RD
 LOUISBURG, NC 27549 BUNN, NC 27508
 Telephone: (252) 290-0181 Telephone:
 Subdivision: Lot Number: Size: 76,200

Physical Address/ Location /Directions 474 ALFORD MILL RD

Description: LifeTime _____ 5 Year ☒

TYPE FACIL Res # EMPLOY — # BEDRMS 3 GPD 360 LTAR .39pd/42
 TYPE WAT Priv TYPE SYS C TYPE REP P to A BSMT NO BST FX —
 SIZE TANK 1000 SIZE CHB — SIZE NITR 3'x400' MTD 12"

COMMENTS Install lines on contour and in dry conditions.
Do not park or drive over system. Do not
exceed MTD of 12". Must bring in 8-10" of cover ~
topsoil type material

Septic Contractors are responsible for notifying the health department for final inspections, between 8:00-9:00 AM on the day of completion, Monday - Friday. Any request for final inspections received afterwards will be scheduled the same day, if possible, or the next workday. Have permit number and owner/applicant's name ready when making the call.

Actions of representatives of state or local agencies engaged in the evaluation and determination of measures required to effect the compliance with the provisions of this permit shall in no way be taken as a guarantee that wastewater disposal systems permitted and approved will function in a satisfactory manner for any given period of time, or that such employees assume any liability for damages, consequential or direct which are caused, or may be caused, by a malfunction of this wastewater treatment and disposal system.

Proper precautions must be taken to assure the proper functioning of the system after it has been covered. Do not run any heavy equipment over the system, as soft earth will allow damage to the tank and lines. Pipe all roof drains away from the septic system site to prevent flooding of the lines from surface water. Terrace the ground to prevent excessive drainage from higher areas adjacent to the system. Do not construct driveways over any part of the septic system unless proper provisions were made when the septic system was constructed. Only grass, not trees or shrubbery, should be cultivated over the lines. All plumbing fixtures should be carefully inspected periodically and any problems repaired immediately. All septic tanks should be pumped off by a permitted pump operator on a regular schedule, not to exceed every five years.

The improvement permit and construction authorization is a site approval, for the future installation of a wastewater treatment and disposal system. Changes in ownership of the site do not affect the validity of this permit. However, any alteration of the site or soil conditions, changes in the location of the proposed facility, changes to the wastewater flow and/or characteristics, or submittal of false information with the application or misrepresentation of the property lines may subject this permit to suspension or revocation.

FOR THIS TO BE A VALID CONSTRUCTION AUTHORIZATION, A LAYOUT SHEET MUST BE ATTACHED

IMPROVEMENT PERMIT DATE 7-17-06 EHS Bence Shearin
 CONSTRUCTION AUTHORIZATION DATE 7-17-06 EHS Bence Shearin

PAGE 2 OF 2

Franklin County Health Department

Name: ALFORD

Permit Number 11/2/06 2824CONTRACTOR David Brantley TANK MANU ST 11/2/06 MANU DATE _____WELL INSTALLED YES _____ NO _____ SYSTEM CODE EZ1203

IMPROVEMENT PERMIT

DATE 7-17-06 EHS Renee Shearin

THORIZATION DATE 7-17-06 EHS Renee Shearin

2 of 3

PAGE 2 OF 2

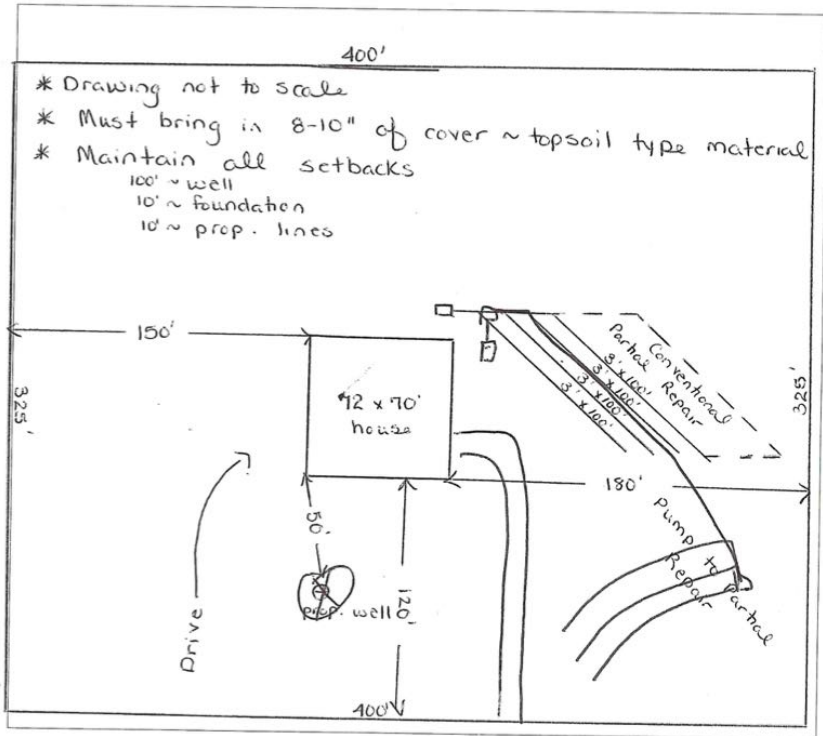
Franklin County Health Department

Name: ALFORD

Permit Number 2824

CONTRACTOR David Brandon TANK MANU ST 087100 MANU DATE 11/2/06

WELL INSTALLED YES NO SYSTEM CODE E21203

SEPTIC SYSTEM LAYOUT
(SKETCH SYSTEM LAYOUT HERE)SEPTIC SYSTEM AS-BUILT
(IF DIFFERENT FROM INITIAL LAYOUT)
ON REVERSE

OPERATIONS PERMIT

DATE 1/10/07 EHS Affly Wro

FRANKLIN COUNTY SOIL/SITE EVALUATION SHEET

APPLICANT Michael Alford
 WATER SUPPLY Private
 LOCATION/DIRECTIONS Alford Mill RdPROPERTY ID
 DATE 7-17-06

FACTORS

PROFILES

LANDSCAPE					5	6
SLOPE (%)						
HORIZON I						
TEXTURE						
CONSISTENCE						
STRUCTURE	1941(a)(2)	tr, ss, op, vtr, ns, np, vtr, ns, np, vtr, ns, np	cc/shk	gr	gr	gr
CLAY MINEROLOGY	1941(a)(3)	SEXP	SEXP	SEXP	SEXP	SEXP
HORIZON II DEPTH	1943		10-20	3-9	6-30	
TEXTURE	1941(a)(1)		SCL	SCL	C	
CONSISTENCE	1944					



Search this screen

