

encl

Franklin County Health Department
Division of Environmental Health
107 Industrial Drive-Suite C
Louisburg, North Carolina 27549

PAGE 1 OF 2

Phone: 919-496-8100

SEPTIC PERMIT

Fax: 919-496-8136

Permit Number: 9390

Type: R

PIN:

Date: 4/28/2017

Applicant: RONALD MIMNAUGH

Owner: RONALD MIMNAUGH

276 Sagamore Dr
LOUISBURG, NC 27549

LOUISBURG, NC 27549

Telephone:

Telephone:

Subdivision:

Lot Number:

Size:

Physical Address/ Location /Directions 276 SAGAMORE DR

Description: LifeTime

5 Year

X

TYPE FACIL SF-7 # EMPLOY - # BEDRMS 3 GPD 360 LTAR .359/a

TYPE WAT Com TYPE SYS A TYPE REP N/A BSMT N BST FX N/A

SIZE TANK Ex 350g SIZE CHB / SIZE NITR 3x270 MTD 36"

COMMENTS: Add Install New drain field for residence

Septic Contractors are responsible for notifying the health department for final inspections, between 8:00-9:00 AM on the day of completion, Monday - Friday. Any request for final inspections received afterwards will be scheduled the same day, if possible, or the next workday. Have permit number and owner/applicant's name ready when making the call.

Actions of representatives of state or local agencies engaged in the evaluation and determination of measures required to effect the compliance with the provisions of this permit shall in no way be taken as a guarantee that wastewater disposal systems permitted and approved will function in a satisfactory manner for any given period of time, or that such employees assume any liability for damages, consequential or direct which are caused, or may be caused, by a malfunction of this wastewater treatment and disposal system.

Proper precautions must be taken to assure the proper functioning of the system after it has been covered. Do not run any heavy equipment over the system, as soft earth will allow damage to the tank and lines. Pipe all roof drains away from the septic system site to prevent flooding of the lines from surface water. Terrace the ground to prevent excessive drainage from higher areas adjacent to the system. Do not construct driveways over any part of the septic system unless proper provisions were made when the septic system was constructed. Only grass, not trees or shrubbery, should be cultivated over the lines. All plumbing fixtures should be carefully inspected periodically and any problems repaired immediately. All septic tanks should be pumped off by a permitted pump operator on a regular schedule, not to exceed every five years.

The improvement permit and construction authorization is a site approval, for the future installation of a wastewater treatment and disposal system. Changes in ownership of the site do not affect the validity of this permit. However, any alteration of the site or soil conditions, changes in the location of the proposed facility, changes to the wastewater flow and/or characteristics, or submittal of false information with the application or misrepresentation of the property lines may subject this permit to suspension or revocation.

FOR THIS TO BE A VALID CONSTRUCTION AUTHORIZATION, A LAYOUT SHEET MUST BE ATTACHED

IMPROVEMENT PERMIT

DATE

EHS

CONSTRUCTION AUTHORIZATION

DATE

EHS

Visit www.franklincountyenvironmentalhealth.com for permit information and tracking.

Franklin County Health Department

Name: MIMNAUGH

Permit Number

9390


CONTRACTOR _____ TANK MANU _____ MANU DATE _____

WELL INSTALLED YES NO SYSTEM CODE _____

SEPTIC SYSTEM LAYOUT (SKETCH SYSTEM LAYOUT HERE)

- * Old drain field will be encountered during installation
- Install new drain lines slightly deeper than existing lines - make precautions to prevent connection between ~~existing~~ New lines

- * layout may need to be altered due to existing drain field.

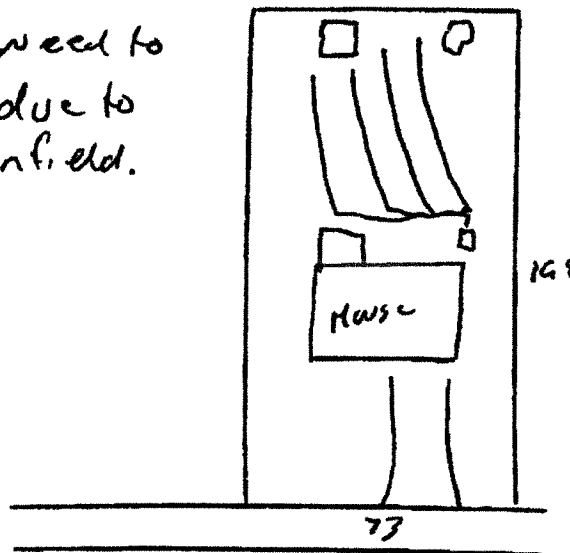

SEPTIC SYSTEM AS-BUILT (IF DIFFERENT FROM INITIAL LAYOUT) ON REVERSE

OPERATIONS PERMIT

DATE

EHS


FRANKLIN COUNTY HEALTH DEPARTMENT

PERMIT NUMBER: 12166C CONST IMPROVE PERMIT	DATE: 01.19.99	19827	SIZE:
APPLICANT: TRAVERS RUTH 1410 MANICLIN PLACE DRENNEN, MO 65001 TELEPHONE: COMMENT	OWNER: CRABTREE SCOTT & ANGELA		
LOCATION/DIRECTIONS:	DESCRIPTION: 5 YEAR	LIFETIME:	
SIGNATURE OF OWNER OR AUTHORIZED AGENT:			

THE ABOVE SIGNATURE INDICATES THAT I HAVE READ, UNDERSTAND, AND AGREE WITH ALL PROVISIONS AND INFORMATION AS OUTLINED ON THE BACK SIDE OF THIS FORM

TOPSOIL <u>PS</u>	TEXTURE <u>PS</u>	STRUCTURE <u>PS</u>	DEPTH <u>—</u>
R. HOR <u>PS</u>	SOIL WET <u>></u>	AVAIL. SP <u>PS</u>	OTHER <u>—</u>
MINREL <u>SE</u>	OVERALL <u>PS</u>	LTAR <u>.35</u>	
# PERMS <u>3</u>	GPD <u>360</u>	DISPOSAL <u>—</u>	TYPE. SYS <u>Cons.</u>
SZ. TANK <u>90 gal</u>	SZ. CHAMB <u>—</u>	NITRIFI <u>3x350'</u>	TYPE. WAT <u>C</u>
SITE. LOC <u>—</u>	MAX TRENCH DEP <u>30"</u>	TYP. FAC <u>—</u>	

REMARKS: Setbacks: 5' prop lines / foundation. Run lines w/ concrete.

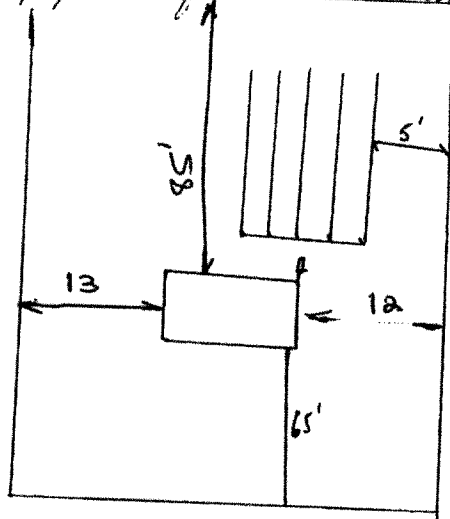

IMPROVEMENT PERMIT DATE: 1-20-99

CONSTRUCTION AUTHORIZATION DATE: 1-20-99

OPERATION PERMIT DATE: —

ENV HEALTH SPEC: [Signature]

ENV HEALTH SPEC: [Signature]

ENV HEALTH SPEC: [Signature]