

FRANKLIN COUNTY HEALTH DEPARTMENT

919 595 7263
435-7000


PERMIT NUMBER: 14941C CONST IMPROVE PERMIT	DATE: 20010130	31470	SIZE: 0.780A
APPLICANT: WYNN CONSTRUCTION 1684 HAYES RD CREEDMOOR NC 27522		OWNER: GEORGETOWN WOODS	
TELEPHONE: 730-4788			
COMMENT: SFD	DESCRIPTION: 5 YEAR ☒	LIFETIME: ☐	
LOCATION / DIRECTIONS: GEORGETOWN WOODS #6 - 65 GEORGETOWN WOODS YNG Off Sid Mitchell Rd			
FEE: 175.00		SIGNATURE OR OWNER OR AUTHORIZED AGENT:	

THE ABOVE SIGNATURE INDICATES THAT I HAVE READ, UNDERSTAND, AND AGREE WITH ALL PROVISIONS AND INFORMATION AS OUTLINED ON THE BACK SIDE OF THIS FORM

TOPO <u>5</u>	TEXTURE <u>PS</u>	STRUCTURE <u>PS</u>	DEPTH <u>PS</u>
R. HOR <u>5</u>	SOIL. WET <u>5</u>	AVAIL. SP <u>5</u>	OTHER <u>PS</u>
MINRL <u>5</u>	OVERALL <u>PS</u>	LTAR <u>35</u>	
#BEDRMS <u>3</u>	GPD <u>360</u>	DISPOSAL <u>3'x350'</u>	TYPE. SYS <u>Conv.</u>
SZ. TANK <u>900</u>	SZ. CHAMB <u>24"</u>	NITRIFI <u>SFD</u>	TYPE. WAT <u>Down</u>
SITE. LOC <u>24"</u>	MAX TRENCH DEP <u>24"</u>	TYP. FAC <u>SFD</u>	

REMARKS: stay 10' from water line, 5' from foundation, 10' from property lines
Run drain lines with contour.

CONTRACTOR: Blackly Bros.
TANK MANUF: Ellis 1000
MANUF DATE: 4-24-01

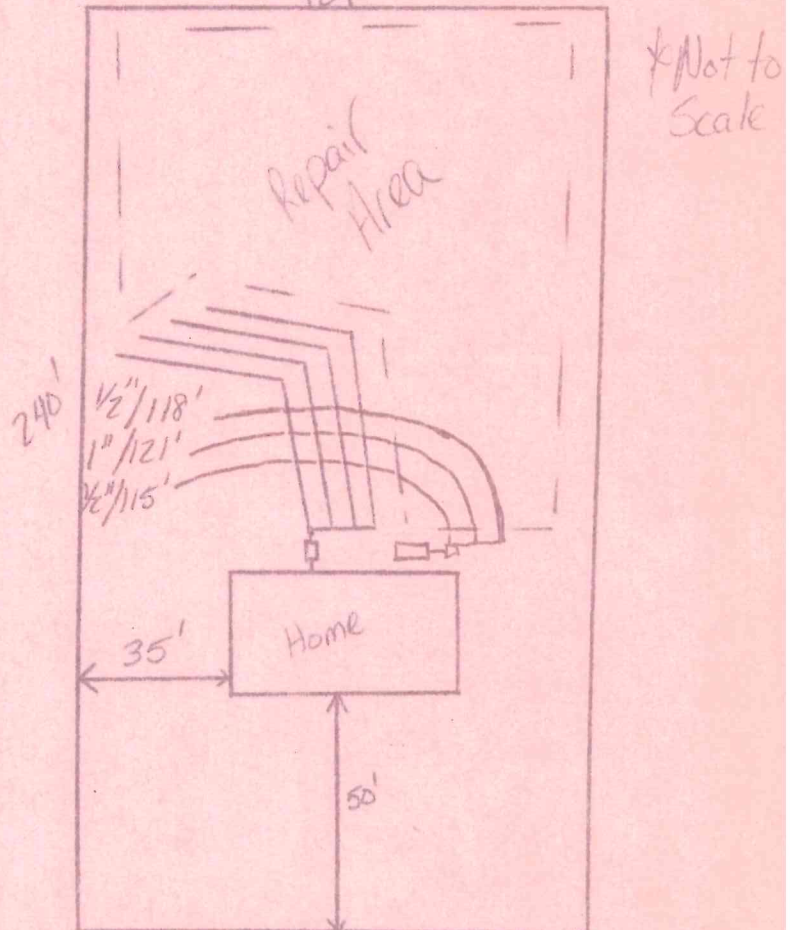

IMPROVEMENT PERMIT DATE: <u>1/30/01</u>	ENV HEALTH SPEC: <u>Drainage</u>
CONSTRUCTION AUTHORIZATION DATE: <u>1/30/01</u>	ENV HEALTH SPEC: <u>Drainage</u>
OPERATION PERMIT DATE: <u>7/1/01</u>	ENV HEALTH SPEC: <u>Drainage</u>

FRANKLIN COUNTY HEALTH DEPARTMENT

919-595-9263
435-7000


PERMIT NUMBER: 14941C CONST IMPROVE PERMIT	DATE: 20010130	31470	SIZE: 0.780A
APPLICANT: WYNN CONSTRUCTION 1684 HAYES RD CREEDMOOR NC 27522 TELEPHONE: 730-4788		OWNER: GEORGETOWN WOODS	
COMMENT: SFD		DESCRIPTION: 5 YEAR ☒	LIFETIME: ☐
LOCATION / DIRECTIONS: GEORGETOWN WOODS #6 - 65 GEORGETOWN WOODS YNG OFF Sid Mitchell Rd			
FEE: 175.00		SIGNATURE OR OWNER OR AUTHORIZED AGENT:	

THE ABOVE SIGNATURE INDICATES THAT I HAVE READ, UNDERSTAND, AND AGREE WITH ALL PROVISIONS AND INFORMATION AS OUTLINED ON THE BACK SIDE OF THIS FORM

TOPO <u>5</u>	TEXTURE <u>PS</u>	STRUCTURE <u>PS</u>	DEPTH <u>PS</u>
R. HOR <u>5</u>	SOIL. WET <u>5</u>	AVAIL. SP <u>5</u>	OTHER <u>5</u>
MINRL <u>5</u>	OVERALL <u>PS</u>	LTAR <u>35</u>	
#BEDRMS <u>3</u>	GPD <u>360</u>	DISPOSAL <u>5</u>	TYPE. SYS <u>Comm</u>
SZ. TANK <u>900</u>	SZ. CHAMB <u>5</u>	NITRIFI <u>3'x350'</u>	TYPE. WAT <u>Comm</u>
SITE. LOC <u>5</u>	MAX TRENCH DEP <u>24"</u>	TYP. FAC <u>SFD</u>	

REMARKS: Stay 10' from water line, 5' from foundation, 10' from property lines
Run drain lines with contour

CONTRACTOR: Blackly Bros.
TANK MANUF: Ellis 1000
MANUF DATE: 4-24-01

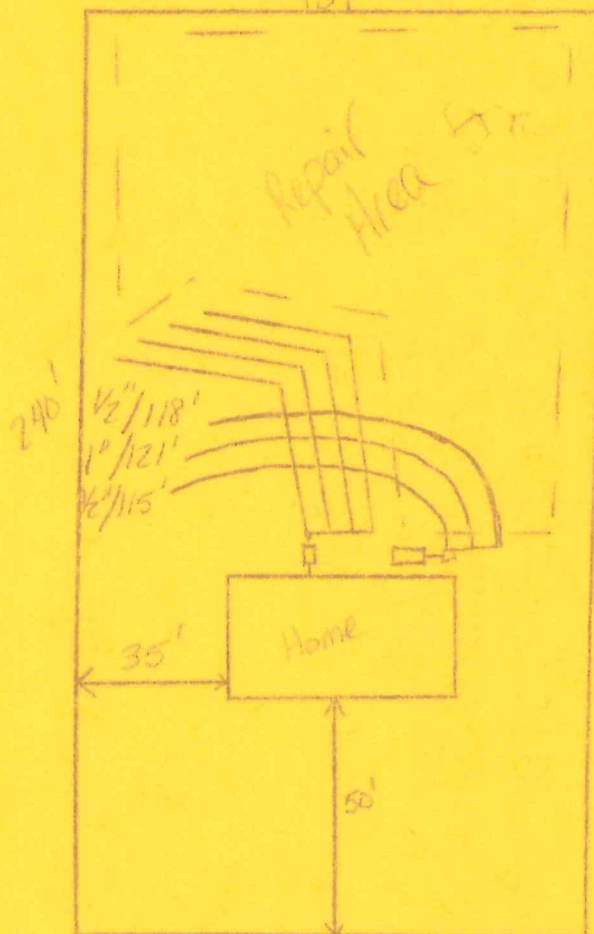

IMPROVEMENT PERMIT DATE: 1/30/01
CONSTRUCTION AUTHORIZATION DATE: 1/30/01
OPERATION PERMIT DATE: 7/1/01

ENV HEALTH SPEC: Permit
ENV HEALTH SPEC: Permit
ENV HEALTH SPEC: Permit

ENVIRONMENT HEALTH APPLICATION (496-8100)

Permit #: **2209**

Permit Type: **SEPTIC PERMIT**

Date Issued: **01/25/2001**

Project Address: **65 GEORGETOWN WOODS, YOUNGSVILLE, NC 27596**

Location: **65 GEORGETOWN WOODS**

Lot #: **6**

Subdivision: **GEORGETOWN WOODS**

Size #: **0.780**

14941C

Applicant: **WYNN CONSTRUCTION**
1684 HAYES ROAD
CREEDMOOR, NC 27522

Phone: **730-4788**

Contractor:

Phone:

Proposed Use: **SFD**

Work:

Desc: **1833-77-3113**

Bldg Cost: \$0	Fees Due: \$175.00	Date Paid: 01/25/2001
Zoned: R-40	Setbacks Front: 30	Rear 25 Side 10
Tax record: 31470	Pin #: 1833-77-3113	Parcel #: B05D00 006
Township: YOUNGSVILL	Public Water/Sewer:	ST Road #:
Special Conditions/Property Owner: GEORGETOWN WOODS		
# of bedrooms: 3	# of people: 4	Approved for Issuance by: EAD
I certify that all the statements made in this application and any attached documents are true, complete and correct to the best of my knowledge and belief and are made in good faith. I understand that false information may be grounds for rejection of this application. Authorized county representatives are granted right of entry to make evaluations or inspections and to release information upon public request.		


Call Environment Health (496-8100) between 8:00 AM and 9:00 AM Monday thru Friday to schedule an appointment with the environment health specialist to evaluate your lot. He/She will show you where to locate the well and septic system, in relation to the desired dwelling location and any property lines. If approved, an improvements permit will be issued. After the septic tank has been installed and approved, the Sanitarian will issue a certification of completion.

William N. Wynn
 (Signature of Contractor or Authorized Agent)

1/25/01
 Date

Wynn Construction, Inc.
Lot 5, Georgetown Woods

Scale: 1" = 40'

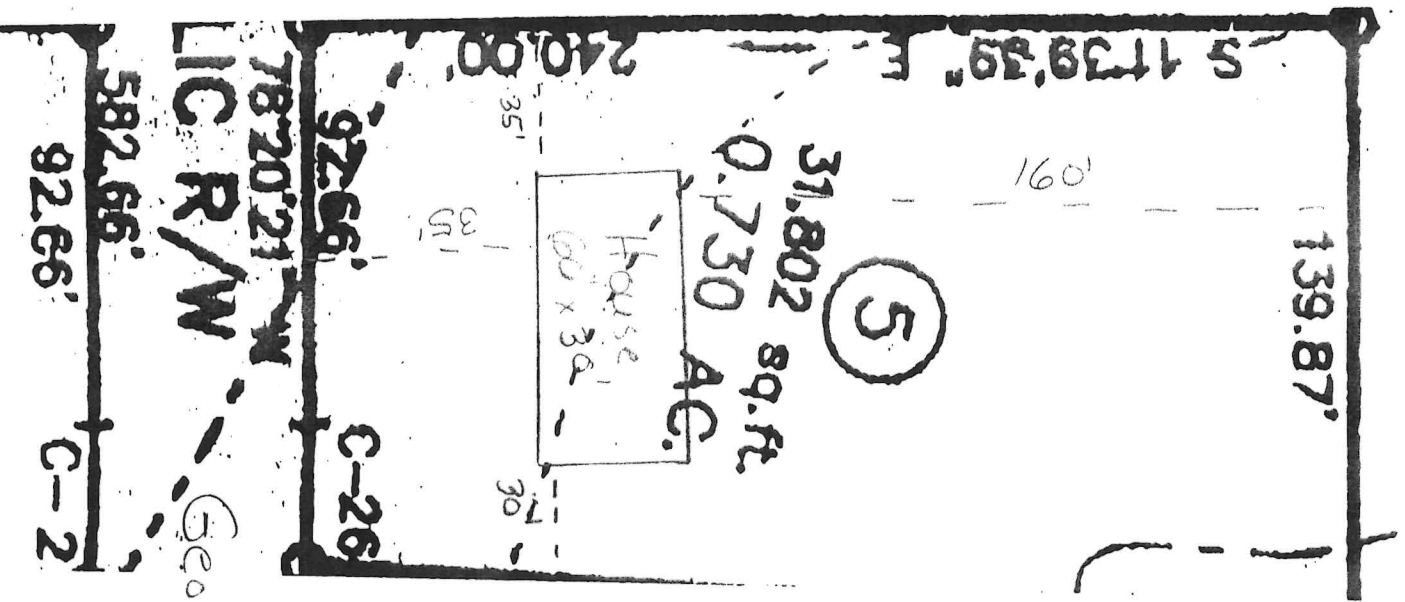

DEPARTMENT OF ENVIRONMENT,
HEALTH & NATURAL RESOURCES
DIVISION OF ENVIRONMENTAL HEALTH

COUNTY: _____ SHEET _____ OF _____
PROPERTY I.D. # _____
TAX #: _____
DATE: _____

OWNER: Wynn Const
WATER SUPPLY: _____
LOCATION: George town Woods #6

TORS		PROFILES									
LANDSCAPE POSITION	.1940	1	2	3	4	5	6	7	8	9	10
DOPE (%)	.1940	SS									
HORIZON 1 DEPTH	.1943	6 1/2									
TEXTURE	.1941 (a)(1)	2-4"									
CONSISTENCE	.1941	SCL									
STRUCTURE	.1941 (a)(2)	FR									
LAY MINERALOGY	.1941 (a)(3)	SBK									
HORIZON 2 DEPTH	.1943	SEXP									
TEXTURE	.1941 (a)(1)	4 1/2-36"									
CONSISTENCE	.1941	C									
STRUCTURE	.1941 (a)(2)	FR-FI									
LAY MINERALOGY	.1941 (a)(3)	SBK									
HORIZON 3 DEPTH	.1943	SEXP									
TEXTURE	.1941 (a)(1)										
CONSISTENCE	.1941										
STRUCTURE	.1941 (a)(2)										
LAY MINERALOGY	.1941 (a)(3)										
HORIZON 4 DEPTH	.1943										
TEXTURE	.1941 (a)(1)										
CONSISTENCE	.1941										
STRUCTURE	.1941 (a)(2)										
LAY MINERALOGY	.1941 (a)(3)										
WETNESS	.1942										
TRICTIVE HORIZON	.1944										
OLITE	.1943/.1956										
SSIFICATION	.1948	PS									
A. R. (gpd/ft2)	.1955	1.35									

ER FACTORS (.1946):	SITE LTAR (gpd/ft2):
ILABLE SPACE (.1945):	
CLASSIFICATION (.1948):	SYSTEM TYPE:
UATED BY:	OTHERS PRESENT:
MENTS:	