

COUNTY OF FRANKLIN
ENVIRONMENT HEALTH APPLICATION (496-8100)

Permit #: **5517**

Permit Type: **SEPTIC PERMIT**

Date Issued: **10/19/2001**

Project Address: ,

Location:

Subdivision:

15885C

Lot #:

Size #: **1.000**

Applicant: **GOTTO JOHN C III**
273 LAKE ROYALE
LOUISBURG NC 27549

Phone:

Contractor:

Phone:


Proposed Use: **SFD**

Work:

Desc: **2840-07-8757**

Bldg Cost: \$0	Fees Due: \$175.00	Date Paid: 10/19/2001
Zoned: A R	Setbacks Front: 30	Rear 25 Side 10
Tax record: 21337	Pin #: 2840-07-8757	Parcel #: LR1202 2977
Township: CYPRESS	Public Water/Sewer: COUNTY	ST Road #:
Special Conditions/Property Owner: GOTTO JOHN C III		
# of bedrooms: 3	# of people: 3	Approved for Issuance by:
I certify that all the statements made in this application and any attached documents are true, complete and correct to the best of my knowledge and belief and are made in good faith. I understand that false information may be grounds for rejection of this application. Authorized county representatives are granted right of entry to make evaluations or inspections and to release information upon public request.		

Call Environment Health (496-8100) between 8:00 AM and 9:00 AM Monday thru Friday to schedule an appointment with the environment health specialist to evaluate your lot. He/She will show you where to locate the well and septic system, in relation to the desired dwelling location and any property lines. If approved, an improvements permit will be issued. After the septic tank has been installed and approved, the Sanitarian will issue a certification of completion.

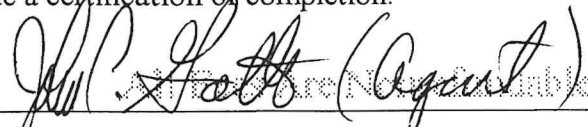
(Signature of Contractor, Authorized Agent or Owner)

10, 19, 01
Date

Franklin County Zoning Permit



FRANKLIN COUNTY

Franklin County, North Carolina

Planning Department

215 E Nash Street, Louisburg, North Carolina 27549

496-2909

Zoning Permit Number: 1198

ADDRESS:

PARCEL NO.: 2840-07-8757

ZONING: A R

SUBDIVISION:

ISSUED TO: **GOTTO JOHN C III**
273 LAKE ROYALE
LOUISBURG NC 27549

SETBACK: FRONT: 30 RIGHT: 10 LEFT: 10 REAR: 25

COUNTY WATER: COUNTY FLOODPLAIN: NO

PERMIT TYPE: ZONING PERMIT

DETAILS: SINGLE FAMILY DWELLING

PERMIT DATE: 10/19/2001 WATERSHED NO

FEE: \$0.00 TOWNSHIP *La 2* EXPIRE DATE: 04/19/2002

It is hereby certified that the above use as shown on the plats and plans submitted with the application conforms with all applicable provisions of the Franklin County Zoning Ordinance. The issuance of this Permit does not allow the violation of Franklin County Zoning Ordinances or other governing Regulations.

The applicant is responsible for obtaining a building permit (if required) prior to commencing work on the proposed improvement. A final zoning inspection must be scheduled by the applicant.

APPROVED BY:

Zoning Inspector

DATE:

10/19/2001


NOV-26-2001 05:18 PM ACCULINE SURVEYING

919 528 7979

P.03

Septic System Design by John R. Davis, Jr. RS LSS


December 8, 2001

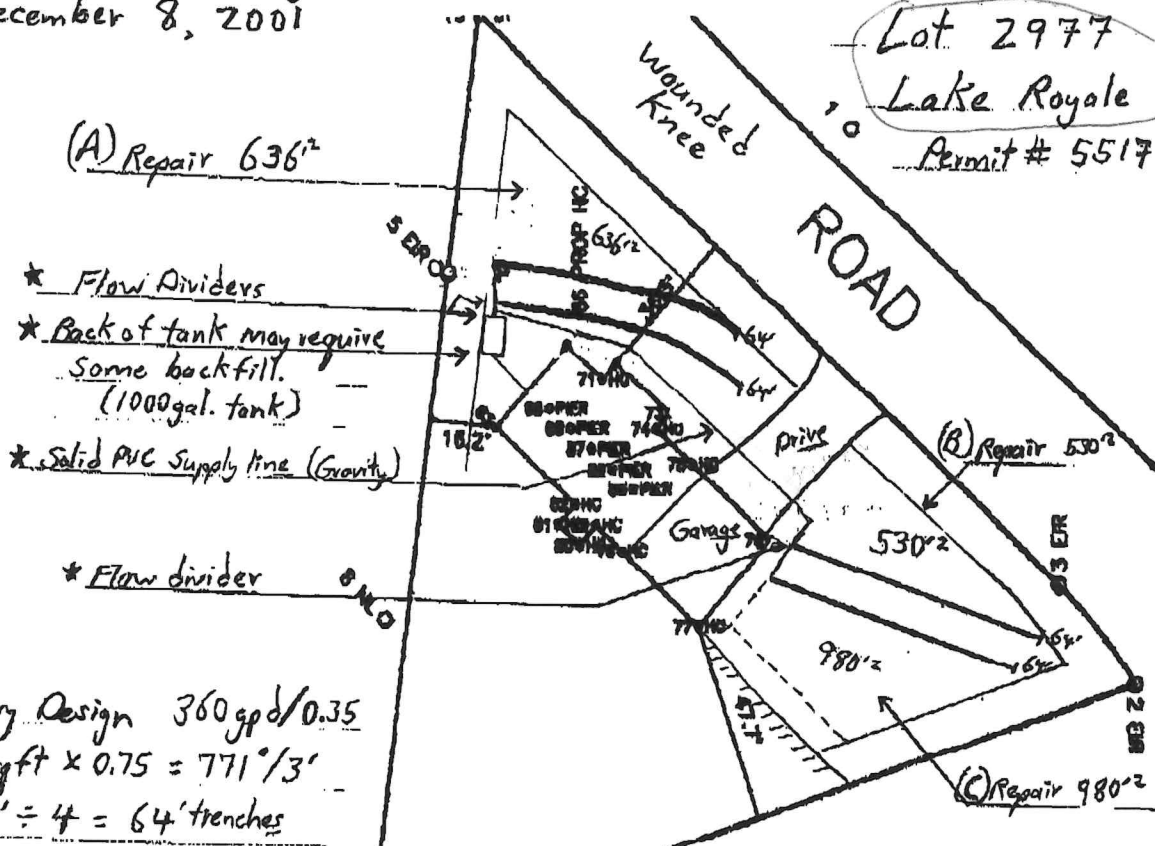


"PRELIMINARY PLAT"
 NOT FOR SALES, CONVEYANCE
 OR RECORDATION.

Note:

Contours measured onsite
 + trenches drawn along
 contours. No pin flags
 on ground.

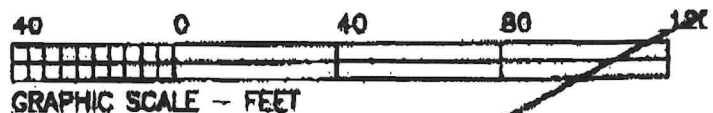

Record Owner
John C. Gatto

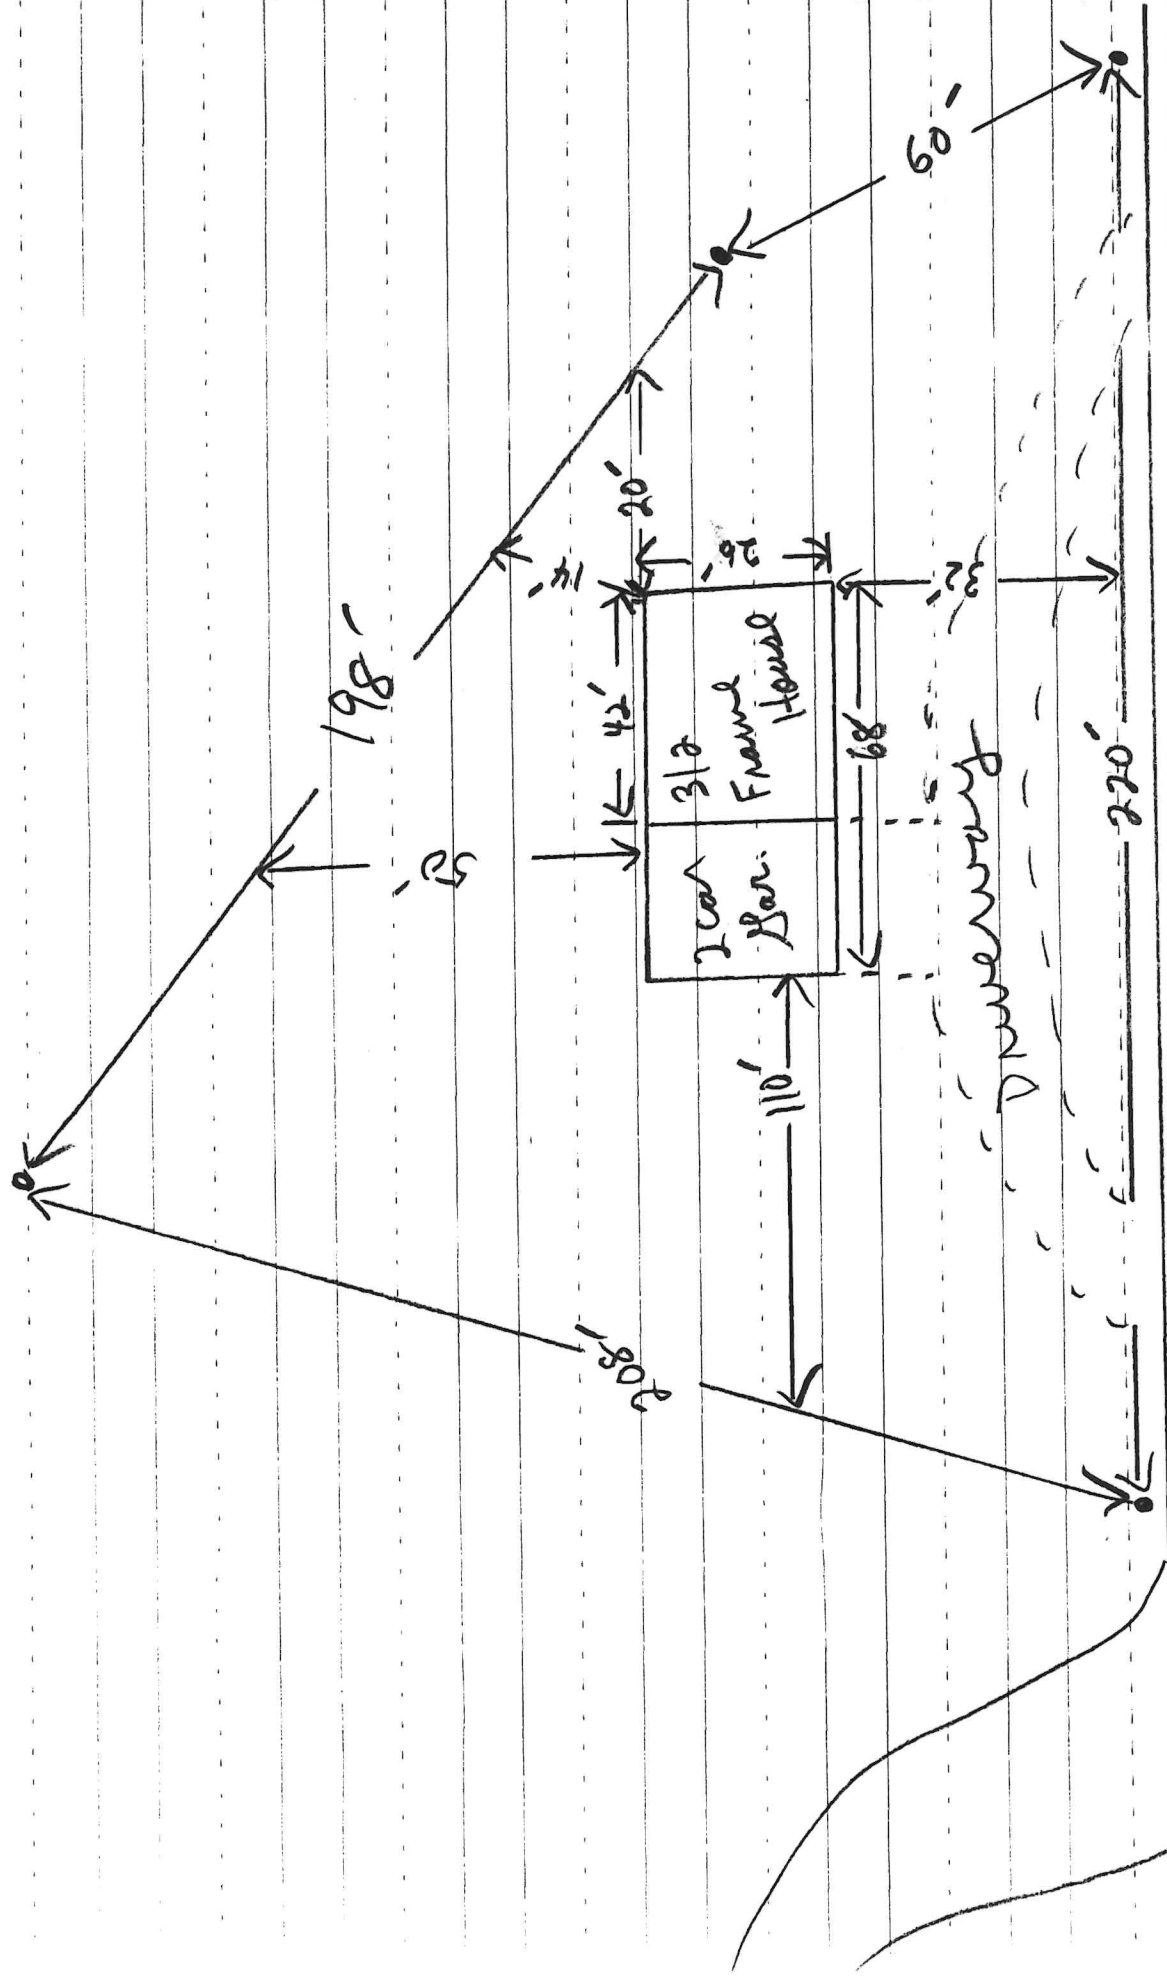

Wounded Knee Dr.