



Granville-Vance District Health Department

Lisa M. Harrison, MPH, Health Director
Post Office Box 367
Oxford, North Carolina 27565



Granville County Health Dept.
101 Hunt Drive
Oxford, NC 27565
Phone: (919) 693-2688
Fax: 919-690-0106

Vance County Health Dept.
115 Charles Rollins Road
Henderson, NC 27536
Phone: (252) 492-7915
Fax: (252) 492-4219

Recertification of an Existing On-Site System and Well

Owner Name / Applicant Name: Gray & Barbara Ware Date: 12-9-13
Physical Address: 8095 Crawford Cumin Rd Contact Number: _____
Subdivision: Saddleback Crossing Lot # 2 Zoning Permit # 18080
Septic Permit #: 6429 Date Installed: 7-9-1-23-09

Recertification Of:

Pool: _____ - Size: _____
Septic Redesign/Upgrade: _____
Permit # _____

Existing House Replacement: Size: _____

Addition to House: 1 - Size: _____
Bedroom Addition _____ Septic Upgrade: _____
Permit # _____ New Well: _____

Outbuilding Addition: ☒ - Size: 20x26

Other Additions to Property: _____

☒ All setbacks have been met accordingly at this time.

☒ Onsite Wastewater System is functioning properly at this time.

_____ Onsite Wastewater System is functioning properly at this time, but system upgrade is required.

Permit #: _____

*** System Upgrade must be completed prior to Certification of Occupancy.

_____ Onsite Wastewater System is **NOT** functioning properly at this time.

Repair Permit #: _____

*** System repair must be completed prior to Certification of Occupancy.

_____ Recertification denied, due to: _____

_____ Cannot determine due to: _____

Special Instructions: Stay 25' From well and 50' From septic

[Signature]

12-9-13

Granville - Vance District Health Department

00771

Environmental Health

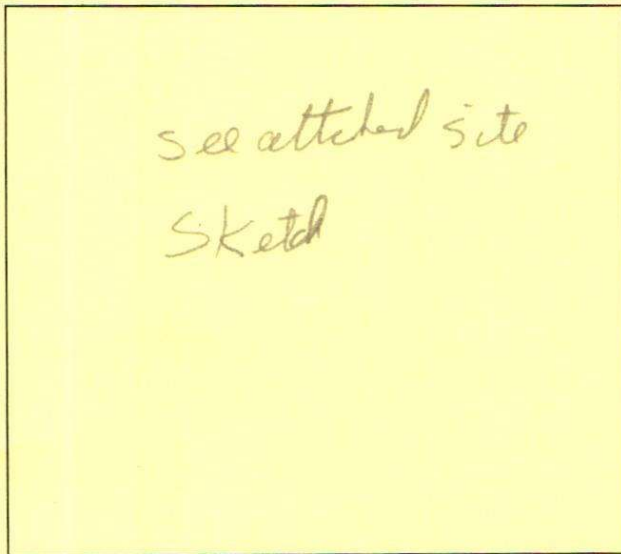
Well Construction Permit

Owner/Applicant: Tarheel Woodcraft Inc
Address or Location of Property: 8095 Sanford AvenueDate: 5-22-12Subdivision & Lot #: Saddleback census Lot #2 Septic Permit #: 6429Zoning Permit #: 17472Environmental Health Specialist: Jerry R. Clayton

This well permit is to locate and site the area that a private groundwater well may be established on the property listed above by the Environmental Health Specialists of Granville County. If one does not locate the well in the approved area and complete the well as specified by the 15A NCAC .02C rules, then permits may be revoked. At completion of drilling of the well, grout must be witnessed by EHS and a well log turned into Environmental Health.

Minimum Setbacks: (these are the main setbacks, but not all required setbacks)

Setback from property lines – 10 ft Setback from septic tank and drain field, including repair area – 100 ft
Setback from structural foundations – 25 ft Setback from ponds, lakes or other bodies of water – 50 ft

Site Sketch:**Conditions:**

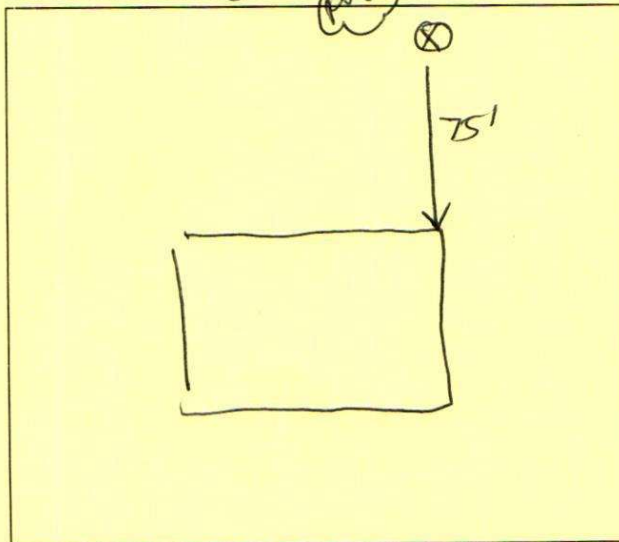
see attached drawing

Authorized Agent:

Date: 5-22-12

1 Well Grout: (Circle or write in)

Witnessed: Yes or No EHS Agent: Champion
Date: 7-20-12 Annular Space Open: Yes or No
Over reamed: Yes or No Depth Grouted: 20'
Method: Pump Poured Pressure
Well Log received: Yes or No (EHS to Attach to Permit)
Driller Name: Jerry Ball Cert. #
Depth: 200 Casing Depth: 39' GPM: 50

As Built Drawing:**# 2 Well Final: (Place a check mark when finalized)**

Seal Present and Intact: ✓ Air Vent: ✓
Hose Spigot: ✓ Electrical Box: ✓
Pump Installer Tag: ✓ Well Installer Tag: ✓
All holes sealed: ✓ 12" above grade: ✓

Comments:

3 Well Completion Permit: Champion EHS
Date Completed: 11-19-12

4 Water Samples Taken: Date: 11-19-12
EHS: CC Results:
Retest: Results:

Granville - Vance District Health Department
Environmental Health

Pin 1918 00647837

Permit Number 6429

☒ Improvement Permit

☒ Construction Authorization

Final Sketch

Greg & Barbara Ware
Applicants Name

Saddleback Crossing - 1st + 2
Subdivision - Section - Lot

Physical Address: Crawford - Cornish Rd

Norman Clifford
System Installer

1-23-09
Date

System design and details as installed.

Septic Tank Information:

Date: 6-9-08
Manufacture: Ellis - 1000
ID #: 573-789

Pump Tank Information:

Date: /
Manufacturer: /
ID #: /

Distribution Box ☒

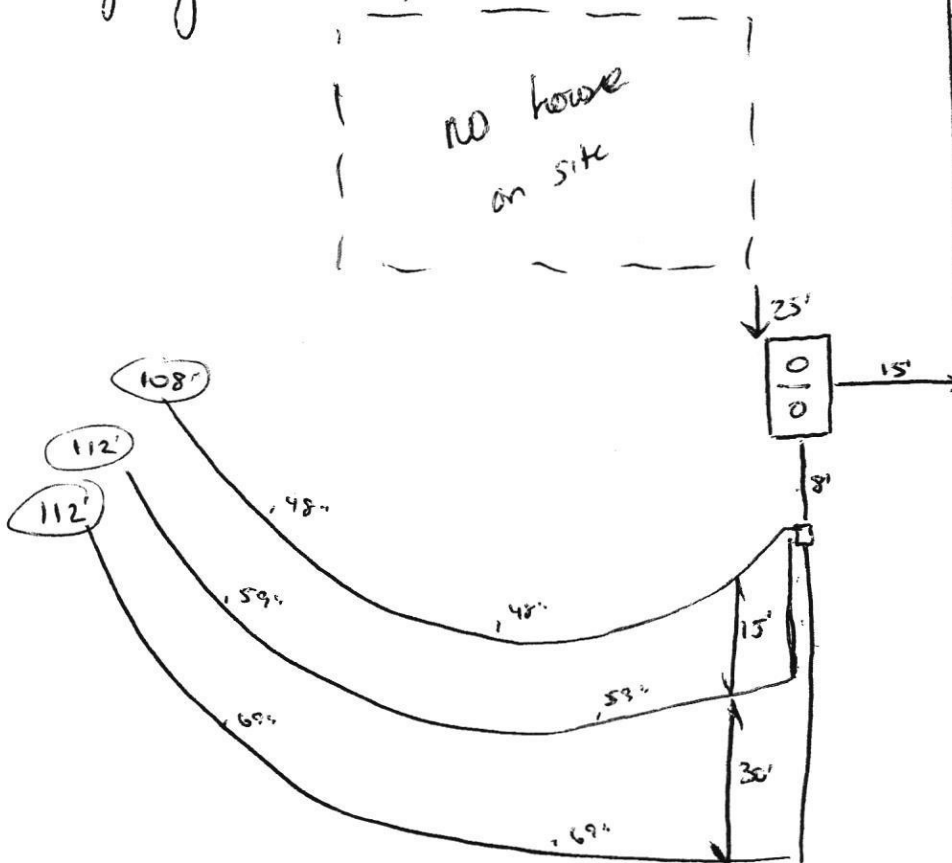
Pressure Manifold

Serial Distribution

Type of Facility: Residence

Number of Bedrooms: 3

Type of System: gravity - Infiltrator panels



Norman Clifford
Authorized Signature

1-23-09
Date

2P # 15302

PERMIT NUMBER 06429

GRANVILLE-VANCE DISTRICT HEALTH DEPARTMENT IMPROVEMENT AND OPERATION PERMITS

COUNTY: Granville	TAX NO. 1918006478 37	TYPE OF ESTABLISHMENTS			*THIS PERMIT SHALL BE ACCOMPANIED BY A LAYOUT SHOWN ON A PLAT, INCLUDING SYSTEM REQUIREMENTS. *THIS IMPROVEMENT PERMIT IS SUBJECT TO REVOCATION IF THE INTENDED USES CHANGE FROM THOSE SHOWN ON THE IMPROVEMENT PERMIT. CHANGES SHALL REQUIRE HEALTH DEPARTMENT APPROVAL.
	SR. NO. 1432	RESIDENCE ☒ BUSINESS ☐ OTHER ☐	NUMBER OF BEDROOMS: 3	NUMBER OF OCCUPANTS: max 6	
OWNER: Gary & Barbara Ware	WATER SUPPLY Private	WELL ☒ PUBLIC ☐	OTHER ☐		
APPLICANT'S ADDRESS: 220114 Bowman Rd Homeworth, OH 44634	TYPE OF WASTEWATER SYSTEM	INITIAL INSTALLATION IIa	REPAIR IIa & IIg		
PROPERTY ADDRESS/LOCATION: Crawford Amin Rd	DESIGN FLOW:	360	360		
SUBDIVISION: Saddlebrook Crossing	LTAR:	.275			
LOT NUMBER: 2	ABSORPTION AREA:	1309			
REFERENCE SKETCH (SEE PLAT FOR DETAILS)	TRENCH WIDTH:	36"			
	TRENCH DEPTH:	24"			
	TRENCH SPACING:	9' on center			
	TOTAL TRENCH LENGTH:	440 330'			
	NUMBER OF TRENCHES:	4-110 Ft			
	GRAVEL DEPTH:	12" accepted			
	TANK SIZE:	1000			
	PUMP TANK SIZE:	—			
	DISTRIBUTION DEVICE:	Distribution Box		PERMIT VALID FOR: 5 YEARS YES ☒ NO ☐ NO EXPIRATION YES ☐ NO ☒	

Maintain contour and install as layout.

Maintain all setbacks

Up to plumbing (building) inspector to determine pipe from garage toilet to septic tank.

***** IMPROVEMENT PERMIT DATE: 7-9-07 *****

FOR: Gary & Barbara Ware
ISSUED BY: Cassel D. Chapman - Casey

CONSTRUCTION AUTHORIZATION FOR IMPROVEMENT PERMIT# 06429

Unless otherwise indicated, the same conditions above apply regarding system type, layout, location and installation requirements.
(The wastewater system cannot be installed until authorization is signed)

Comments: Pre-construction Meeting - take sidewalls of trenches.

Date: 7-9-07 Environmental Health Specialist: Cassel D. Chapman, PE Construction Authorization Addendum ☐ Yes ☒ No

OPERATION PERMIT DATE: 1-23-09

SYSTEM INSTALLED BY: Norman Clifford
ISSUED BY: Cassel D. Chapman, PE

PERFORMANCE, MONITORING, MAINTENANCE AND OPERATION
AS REQUIRED BY RULE .1961