

Environmental Services - Water Quality
Onsite Wastewater Scan Data Entry Form

PERMIT #: D 0 2 0 1 8 5

PIN #: 1 8 2 2 4 5 4 4 1 8

OP DATE: 0 1 1 1 1 2 0 0 2

SYSTEM USE:

- ☒ House
☐ Mobile Home
☐ Business
☐ Other

SEWAGE TYPE:

- ☒ Domestic
☐ Industrial

PUMP/SIPHON?:

- ☐ Yes
☒ No

PRESSURE MANIFOLD:

- ☐ Yes
☒ No

SYSTEM TYPE:

- ☐ I
☐ II
☒ III
☐ IV
☐ V
☐ VI
☐ Other

SUB TYPE:

- ☐ A
☐ B
☐ C
☐ D
☐ E
☐ F
☒ G

NBR BEDROOMS:

- ☐ 1
☐ 2
☒ 3
☐ 4
☐ 5
☐ 6
☐ Other

MAINT. SCHEDULE:

- ☐ Yes
☒ No

CERT. OPERATOR

- ☐ Yes
☒ No

GT ST PT SIZE

- | | | | |
|-------------------------------------|-------------------------------------|-------------------------------------|------------------|
| ☐ | ☐ | ☐ | 750 |
| ☐ | ☐ | ☐ | 900 |
| ☐ | ☒ | ☐ | 1,000 |
| ☐ | ☐ | ☐ | 1,200 |
| ☐ | ☐ | ☐ | 1,500 |
| ☐ | ☐ | ☐ | 1,800 |
| ☐ | ☐ | ☐ | 2,100 |
| ☐ | ☐ | ☐ | 2,500 |
| ☐ | ☐ | ☐ | 3,000 |
| ☐ | ☐ | ☐ | 4,000 |
| ☐ | ☐ | ☐ | 5,000 |
| ☐ | ☐ | ☐ | 8,000 |
| ☐ | ☐ | ☐ | 10,000 |
| ☐ | ☐ | ☐ | Other |
| ☒ | | ☒ | None/NA GT or PT |

DRAINFIELD SIZE(SQ. FT.)

0 1 2 0 0

DRAIN TYPE:

- ☐ Stone
☒ EZ Flow
☐ Infiltrator
☐ Biodiffuser
☐ Cultec
☐ Drip
☐ Hancor
☐ Large Dia. Pipe
☐ Multi-Pipe
☐ Other

MAX DEPTH (IN.):

- ☐ 12 in. or less
☐ 18 in. or less
☒ 24 in. or less
☐ 26 in. or less
☐ 28 in. or less
☐ 30 in. or less
☐ 32 in. or less
☐ 36 in. or less
☐ Other

STONE DEPTH (IN.):

- ☐ 8 in. or less
☒ 12 in. or less
☐ 18 in. or less
☐ 24 in. or less
☐ Other

TRENCHES:

- ☒ Individual
☐ Bed

TRENCH WIDTH (IN.):

- ☐ 12 in. or less
☐ 18 in.
☐ 24 in.
☒ 36 in.
☐ 6 ft. or less
☐ 9 ft. or less
☐ Other

hiv

WAKE COUNTY DEPARTMENT OF ENVIRONMENTAL SERVICES WELL AND SEWAGE SITE LOCATION PERMIT
NO PERMIT(S) FOR CONSTRUCTION, LOCATION OR RELOCATION ACTIVITY SHALL BE ISSUED
UNTIL AN AUTHORIZATION FOR WASTEWATER SYSTEM CONSTRUCTION HAS BEEN ISSUED

PERMIT VOID IF NOT IN COMPLIANCE WITH ZONING REGULATIONS AND/ OR IF SITE IS ALTERED OR INTENDED USE CHANGED

PERMIT#: D020185 STATUS: A APP. DATE: 12/01/2000 BLDG. PERMIT#: 0011875
PIN: ~~1822-01-45-5406-0001~~ 222 45 4418 TAX MAP: 0173 RECORDED: Y ORIG. PERMIT#:
TOWNSHIP: 14 NEW LIGHT JURISDICTION: WC ZONING: R40W
APPLICANT: A FRAME PROPERTIES INC
1313 N WHITE ST
WAKE FOREST, NC 27587
(919) 422 - 5180
USE: HD USE: 101 ONE-FAMILY HOUSE
EXIST USE:
DISPOSAL: N BEDROOMS: 3 BASEMENT: N #EMPLOYEES: 0
SITE: ADDRESS: 12705 SHEPARDS LANDING DR
SUBDIVISION: CARPENTERS CRK LOT: 2 ACRES: 0.91
DIRECTION: GO CAPITAL BLVD NORTH-LEFT PURNELL RD-SUB DIV
ON RIGHT--LOT #

Well System: WATER: INDIVIDUAL - TYPE: NEW

WELL LOG INFORMATION: DEPTH: 205 CASING DEPTH: 72 YIELD: 15 STATIC LEVEL: 25
WELL CONTRACTOR: Goldston REG.# 272 PUMP CONTRACTOR: Jenks REG.#
Construction Compliance GROUT APPROVED ☐ DATE 5-31-01 EHS Ad. R. J. O.
WELLHEAD APPROVED ☒ DATE 6-14-01 EHS AKC
SYSTEM FINALIZED ☒ DATE 6/15/12 EHS NITV

COMMENTS: Permit closed without approved water samples. nitv

Operation Permit

DESIGN FLOW: _____ gal./min. ACTUAL FLOW: _____ INNOVATIVE LETTER: _____

INSTALLED BY: Quilley Landry INSTALLATION APPROVED BY: Todd Tyl
PROPRIETARY SYSTEM: _____ FILTER NO: 2049
COMMENTS: _____

OPERATIONS PERMIT ISSUED? Y OP DATE: 1/11/02 BY: Todd Tyl

This permit is based in part on information provided by the homeowner or his/her representative in the application submitted for this permit. The Environmental Health Specialist is not responsible for false or misleading information contained in the application. The Environmental Health Specialist is also not responsible for concealed conditions on the property or for statements in this report that may have resulted from false or misleading statements provided to him in the application. Neither Wake County nor the Environmental Health Specialist warrants that the septic tank system will continue to function satisfactorily in the future or that the water supply will remain potable.

WAKE COUNTY DEPARTMENT OF ENVIRONMENTAL SERVICES WELL AND SEWAGE SITE LOCATION PERMIT
NO PERMIT(S) FOR CONSTRUCTION, LOCATION OR RELOCATION ACTIVITY SHALL BE ISSUED
UNTIL AN AUTHORIZATION FOR WASTEWATER SYSTEM CONSTRUCTION HAS BEEN ISSUED

PERMIT VOID IF NOT IN COMPLIANCE WITH ZONING REGULATIONS AND/ OR IF SITE IS ALTERED OR INTENDED USE CHANGED

PERMIT#: D020185 STATUS: A APP. DATE: 12/01/2000 BLDG. PERMIT#: 0011875
PIN: ~~1822-04-45-5406-000~~ 022 454418 TAX MAP: 0173 0038 RECORDED: Y ORIG. PERMIT#:
TOWNSHIP: 14 NEW LIGHT JURISDICTION: WC ZONING: R40W
APPLICANT: A FRAME PROPERTIES INC
1313 N WHITE ST
WAKE FOREST, NC 27587
(919) 422 - 5180
USE: HD USE: 101 ONE-FAMILY HOUSE
EXIST USE:
DISPOSAL: N BEDROOMS: 3 BASEMENT: N #EMPLOYEES: 0
SITE: ADDRESS: 12705 SHEPHARDS LANDING DR
SUBDIVISION: CARPENTERS CRK LOT: 2 ACRES: 0.91
DIRECTION: GO CAPITAL BLVD NORTH-LEFT PURNELL RD-SUB DIV
ON RIGHT--LOT #

IMPROVEMENT PERMIT

TANK SIZE: 1000 gal. PUMP Tank: ____ gal. SQ FT: 1200 STONE DEPTH: 12 in. MAX DEPTH LINE: 24 in.
WASTEWATER: INDIVIDUAL SEWAGE: DOMESTIC TYPE SYSTEM: II PUMP: N P/M: N
DAILY FLOW: 00360 gal/day WATER: INDIVIDUAL

COMMENTS:

IP ISSUED? Y DATE: 02/12/2001 BY: (EGJ) Glenn Johns PHONE#: 856-7413

AUTHORIZATION FOR WASTEWATER/WATER SYSTEM CONSTRUCTION

VOID SIXTY (60) MONTHS FROM DATE OF ISSUANCE

AUTHORIZATION CONDITIONS:

Contractors shall install system on contours, see attached site plan for wastewater system design and well location. No underground utilities, water lines or sprinkler systems may be located in the original system or repair areas. A septic tank filter with a riser for access is required. The wastewater system shall not be covered or placed into use until inspected by the Wake County Department of Environmental Services and an Operation Permit issued. **OTHER CONDITIONS:**
STAY 100' FROM WELL AND 10' FROM PROPERTY LINES. SMOOTH OUT HIGH SPOTS ON LANDSCAPE BEFORE INSTALLING.
**** NO POOLS,PAVING, GRADING, STRUCTURES, SPRINKLER/IRRIGATION SYSTEMS OR OTHER DISTURBANCE TO DESIGNATED SEPTIC AND SEPTIC REPAIR AREAS.

TANK SIZE: 1000 gal. PUMP TANK: ____ gal. SQ FT: 1200 STONE DEPTH: 12 in. MAX DEPTH LINE: 24 in.
MAINT: N OPER: N L/O: Y TRENCH#: 4 LENGTH: 100 ft. WIDTH: 3 in.
SUBFIELDS: ____ DESIGN HEAD PRESSURE: ____ DESIGN FLOW: ____ gal/min DOSE VOLUME: ____ gal.

CA ISSUED? Y DATE: 02/12/2001 BY: (EGJ) Glenn Johns PHONE#: 856-7413

A-FRAME PROPERTIES

LOT 2. CARPENTERS CREEK SUBDIVISION

REF: D.B. 8457, PG. 2421

NEW LIGHT TOWNSHIP

WAKE COUNTY, NORTH CAROLINA

NOVEMBER 30, 2000

ZONED R-40W

0011875
D-20185

Zoning R 40W By CG
 Approve ✓ Date 2-6-01
 Revise ✓ Use 10/11
 Reject MBL
 Front 30 Rear 30
 Side 15 Corner

Comments: REVISED

Site plan

AS BUILT

REMOVED

SI mill
1000 gal
858
8-3-00
N/F 3 lines 100 ft
25% Reduc
DEW. HAROLD P.
& BETTIE P.

vised
Site Plan

Pin # 0011875

D # 20185

I hereby certify that the location of planned or existing structure(s) are accurately shown. I understand and agree to locate structures in accordance with this plot plan may require the relocation of structure(s) regardless degree of completion. I hereby grant permission for Municipal/County Representatives the right of entry to make evaluations or inspections upon this property.

Fax-528-7767


Phone - 528-7767


2-6-01

TOTAL AREA - 0.995 AC.
 LESS R/W - 0.032 AC.
 NET AREA - 0.918 AC.

(Pin # 1822.01455406)

Scale 1" = 60'

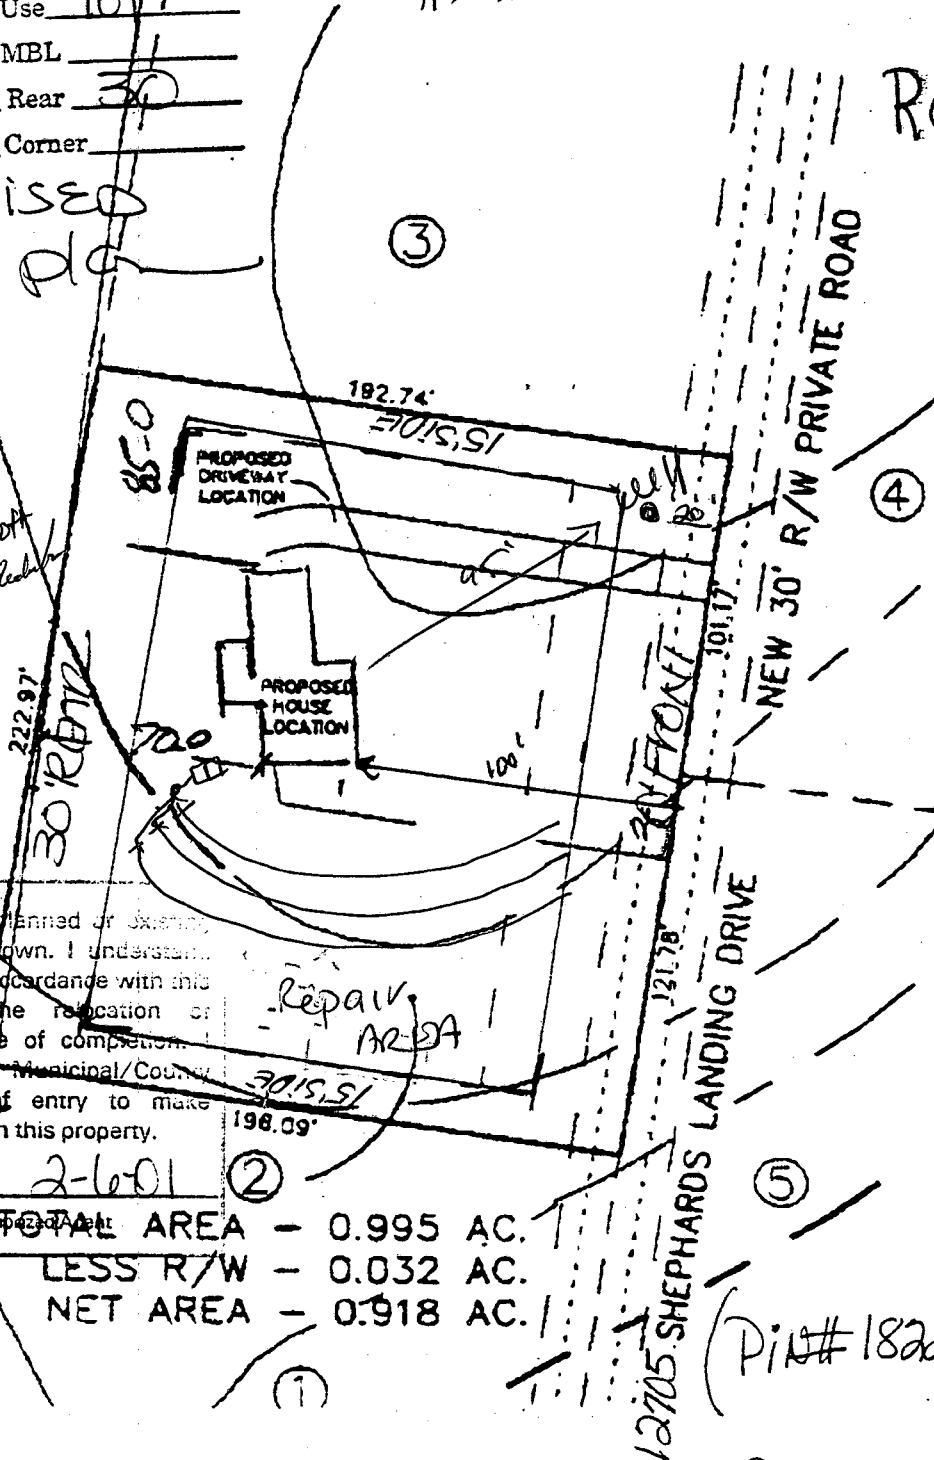

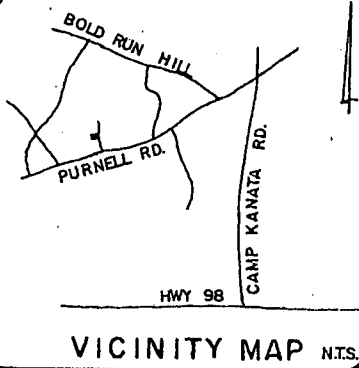

LEGEND
 ——— LINES SURVEYED
 - - - LINES NOT SURVEYED
 E.I.P. EXISTING IRON PIPE
 I.P.S. IRON PIPE SET



B.O.M 2000, 2096

House 1610
 Driveway 2023
 Shed 256
 Garage 480
 Pool 1080
 TOTAL 5449 N/F DEW
 7.9%

I certify that the location of planned or existing structure(s) are accurately shown. I understand failure to locate structures in accordance with this plot plan may require the relocation of structure(s) regardless degree of completion. I hereby grant permission to Municipal/County Representatives the right of entry to make evaluations or inspections upon this property.

Larry Powell
 Signature of Owner or Authorized Agent

Site plan approved as shown for Shed. Any changes to site plan voids approval. All setbacks apply for septic systems and wells, regarding any pools, decks, additions and/or accessory structures. Applicant is responsible for protecting all portions of the septic system, repair area and wells from damage during construction. Adhere to all Local and State Rules.

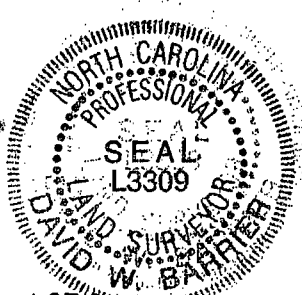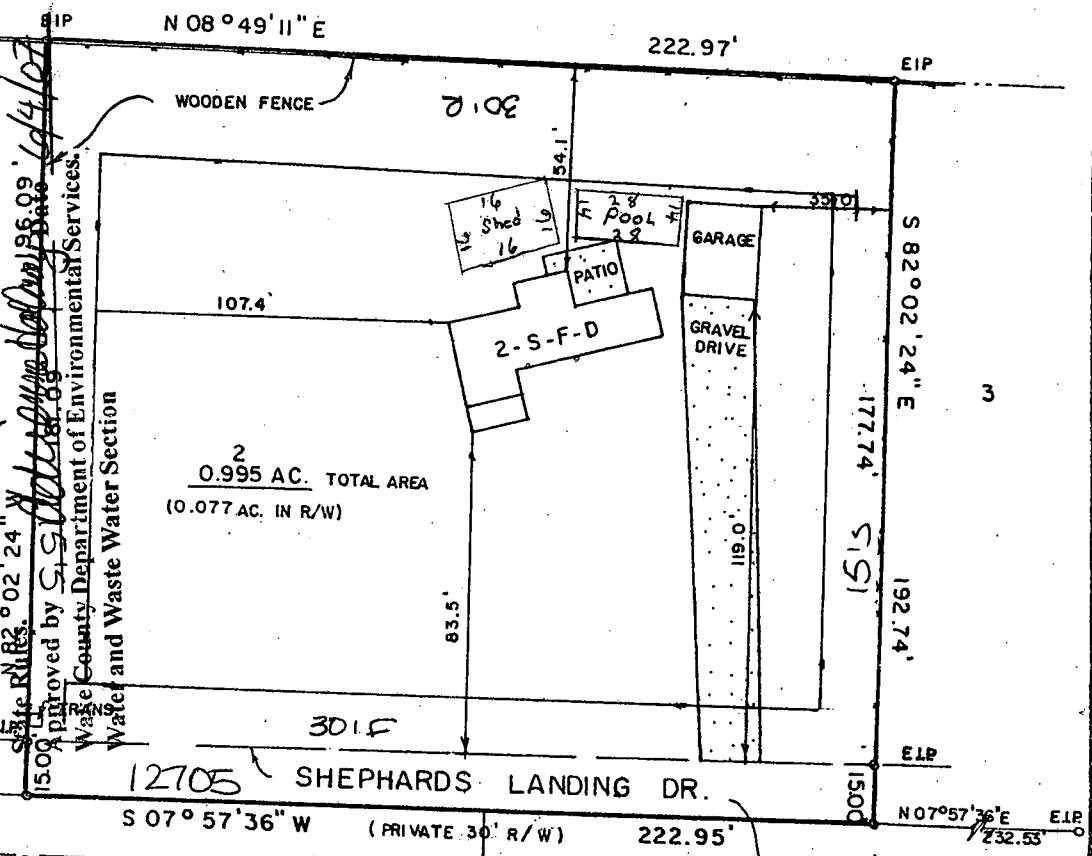

Pin#
 182201454418
 Permit#
 0074190

Zoning R40W By DLG
 Approve ☒ Date 6-1-07
 Revise _____ Use 434
 Reject _____ MBL
 Front 30 Rear 30
 Side 15 Corner _____
 Comments:

LOT 2, CARPENTERS CREEK SUBD., RECORDED IN B.O.M 2000, PG. 2096, WAKE CO.


I, David W. Barrier, certify that this plat was drawn under my supervision from an actual survey made under my supervision; that the boundaries not surveyed are clearly indicated; that any encroachments are shown.

David W. Barrier
 Licensed Surveyor

PROPERTY OF
LARRY POWELL & FRANCES POWELL

12705 SHEPARDS LANDING DR. WAKE FOREST NC
 SCALE: 1" = 50'
 DATE: 11/20/02
 BOOK: M-119-49

DAVID W. BARRIER
 LICENSED SURVEYOR
 421 S. HARRISON AVE.
 CARY, N.C.
 (919) 469-2834

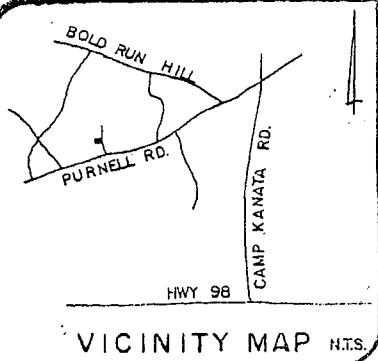

- LEGEND**
- LINES SURVEYED
 - - - LINES NOT SURVEYED
 - E.I.P. EXISTING IRON PIPE
 - I.P.S. IRON PIPE SET



Pool size's location

Site plan approved as shown on *2000, 2096*

Any changes to site plan voids approval. All setbacks apply for septic systems and wells, including any pools, decks, additions and/or accessory structures. Applicant is responsible for protecting all portions of the septic system, septic tank and wells from damage during construction. Adhere to all Local and State Rules.

Approved by *Brianna Roberts* *7/14/03*
 Wake County Department of Environmental Services
 Water and Waste Water Section

N/F
DEW

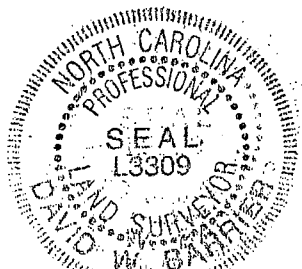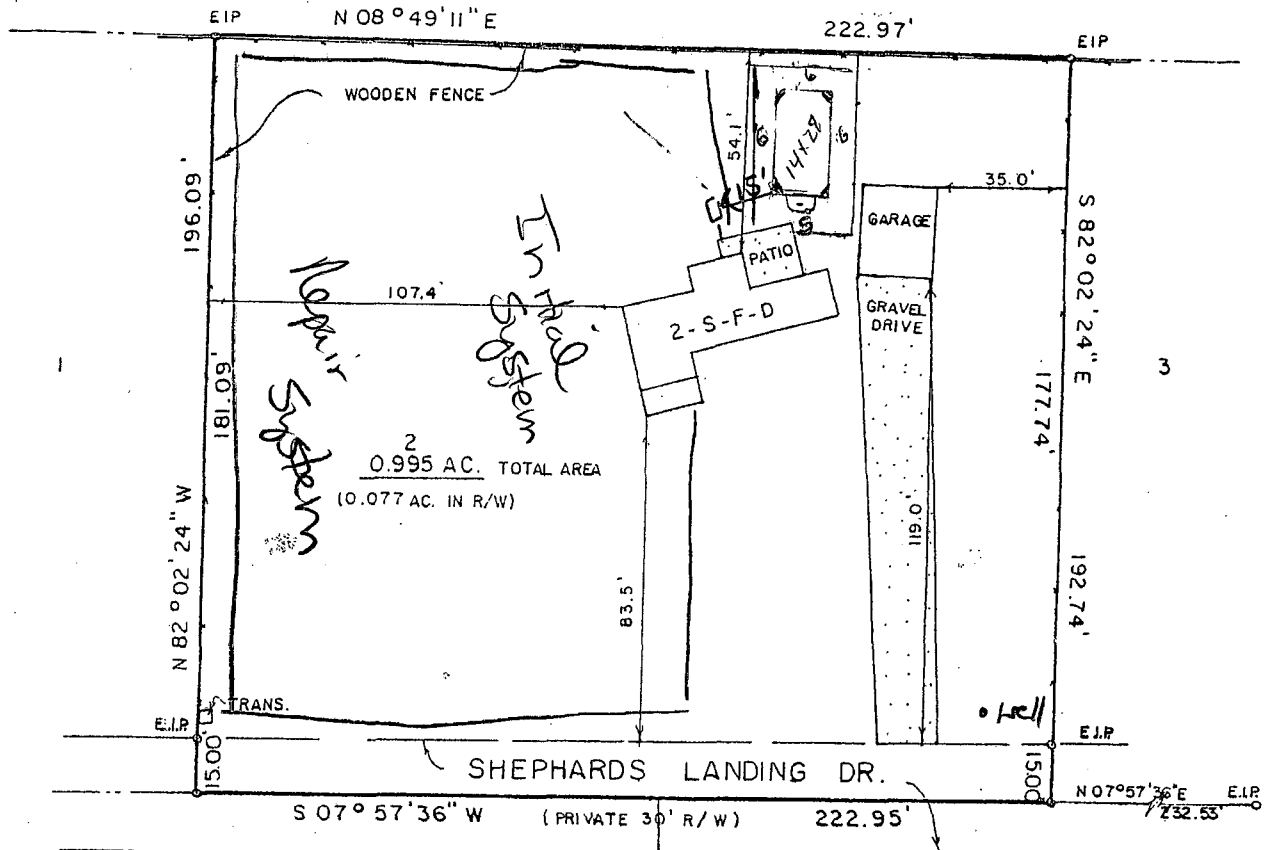

LOT 2, CARPENTERS CREEK SUBD., RECORDED IN B.O.M 2000, PG. 2096, WAKE CO.

I, David W. Barrier, certify that this plat was drawn under my supervision from an actual survey made under my supervision; that the boundaries not surveyed are clearly indicated; that any encroachments are shown.

David W. Barrier
 Licensed Surveyor

PROPERTY OF
**LARRY POWELL &
 FRANCES POWELL**

12705 SHEPARD'S LANDING DR. WAKE FOREST, NC

SCALE: 1" = 50'

DATE: 11/20/02

BOOK: M-119-49

DAVID W. BARRIER
 LICENSED SURVEYOR

421 S. HARRISON AVE.
 CARY, N.C.
 (919) 469-2834