

Environmental Services - Water Quality
Onsite Wastewater Scan Data Entry Form

PERMIT #: 0001360

PIN #: 1820981336

OP DATE: 0110511998

SYSTEM USE:

- ☒ House
☐ Mobile Home
☐ Business
☐ Other

SEWAGE TYPE:

- ☒ Domestic
☐ Industrial

PUMP/SIPHON?:

- ☐ Yes
☒ No

PRESSURE MANIFOLD:

- ☐ Yes
☒ No

SYSTEM TYPE:

- ☐ I
☒ II
☐ III
☐ IV
☐ V
☐ VI
☐ Other

SUB TYPE:

- ☒ A
☐ B
☐ C
☐ D
☐ E
☐ F
☐ G

NBR BEDROOMS:

- ☐ 1
☐ 2
☐ 3
☒ 4
☐ 5
☐ 6
☐ Other

MAINT. SCHEDULE:

- ☐ Yes
☒ No

CERT. OPERATOR

- ☐ Yes
☒ No

GT ST PT SIZE

- | | | | |
|-------------------------------------|-------------------------------------|-------------------------------------|------------------|
| ☐ | ☐ | ☐ | 750 |
| ☐ | ☐ | ☐ | 900 |
| ☐ | ☐ | ☐ | 1,000 |
| ☐ | ☒ | ☐ | 1,200 |
| ☐ | ☐ | ☐ | 1,500 |
| ☐ | ☐ | ☐ | 1,800 |
| ☐ | ☐ | ☐ | 2,100 |
| ☐ | ☐ | ☐ | 2,500 |
| ☐ | ☐ | ☐ | 3,000 |
| ☐ | ☐ | ☐ | 4,000 |
| ☐ | ☐ | ☐ | 5,000 |
| ☐ | ☐ | ☐ | 8,000 |
| ☐ | ☐ | ☐ | 10,000 |
| ☐ | ☐ | ☐ | Other |
| ☒ | | ☒ | None/NA GT or PT |

DRAINFIELD SIZE(SQ. FT.)

01350

DRAIN TYPE:

- ☒ Stone
☐ EZ Flow
☐ Infiltrator
☐ Biodiffuser
☐ Cultec
☐ Drip
☐ Hancor
☐ Large Dia. Pipe
☐ Multi-Pipe
☐ Other

MAX DEPTH (IN.):

- ☐ 12 in. or less
☐ 18 in. or less
☒ 24 in. or less
☐ 26 in. or less
☐ 28 in. or less
☐ 30 in. or less
☐ 32 in. or less
☐ 36 in. or less
☐ Other

STONE DEPTH (IN.):

- ☐ 8 in. or less
☒ 12 in. or less
☐ 18 in. or less
☐ 24 in. or less
☐ Other

TRENCHES:

- ☒ Individual
☐ Bed

TRENCH WIDTH (IN.):

- ☐ 12 in. or less
☐ 18 in.
☐ 24 in.
☐ 36 in.
☐ 6 ft. or less
☐ 9 ft. or less
☒ Other

Bw 1/28/14

WAKE COUNTY HEALTH DEPARTMENT WELL AND SEWAGE SITE, LOCATION PERMIT

NO PERMIT(S) FOR CONSTRUCTION, LOCATION OR RELOCATION ACTIVITY SHALL BE ISSUED
UNTIL AN AUTHORIZATION FOR WASTEWATER SYSTEM CONSTRUCTION HAS BEEN ISSUED

Pin # 1820.02886807 Project # 0962813

Tax Map No. _____ Parcel No. _____

Zoning Wake Township HWLT

Owner/Contractor: JB Hill Jr

Location/Address: 2401 Worthing Ct (Falls of Neuse Tr Old

A 98W TR Moreham on rt first intersection)

Subdivision Name: Chartwell

Lot No. (32)

Section or Block No. _____

Improvement Permit D1360

Well Permit No. _____

Operation Permit X

Date: 4-18-96


S.R. # 1267

Preliminary Layout

* See CA for wastewater system design specs.
* See Site Plan for wastewater system siting.

Final Layout

Mills-1200
STB-857
8-B-97

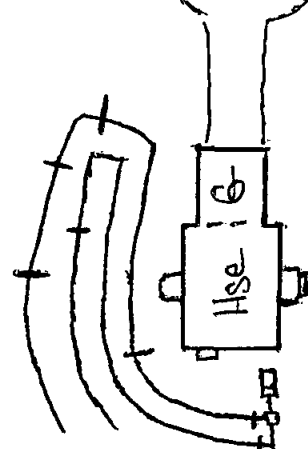

Sewage System Specifications

Repair [] Original Permit No. _____

Garbage Disposal Unit Yes [] No X

House X Mobile Home [] Business []

No. of Bedrooms 4 Lot Area 1.53 AC.

Size of Tank _____ gal. 1200

Wastewater: Sewage X Industrial [] Comments: _____

Date: 10-1-97 Installed By: Quality Landscaping

Approved By: (Ed Faison) C. W. Kuen, R.S.

Nitrification Line _____ 1350 sq. ft.

Depth of Stone: 12" [X] Max Depth of Trenches: 22 in.

Riser and Baffle Required X Pump Required []

Permit void if not in compliance with zoning regulations

Permits may be voided if site is altered or intended use changed

Layout by: DR Parrill Jr

Well System
Individual X Semi-Public [] Public []
New X Replacement [] Repair []
Fee Paid: Yes X No []

Construction Compliance Yes No
Site Approved [X] []
Well Head Approved [X] []
Grouting Approved [X] []

Date Inspected 6-14-96 Sanitarian Ralph McDonald

Bacteriological Results

Initial Sample: absent Date: 12-29-97

* Re-Sample #1 _____ Date: _____

* Re-Sample #2 _____ Date: _____

* Re-chlorination as required [] Yes [] No

* Fees for all resamples

All checks payable to: Wake County Health Department

Final Inspection Yes No

Required Slab [X] []

Chlorinated [X] []

Required Certificate [] []

Variance (Explain) [] []

WCHD I.D. Affixed 7/98 [X] []

Sample Collected [] []

Comments: See Site Plan for

Well site location

Well Installed By: Joel Bonnell

Date System Finalized 01-05-98

Sanitarian Martha Tyndall

75 gpm

This report is based in part on information provided by the homeowner or his/her representative in the application submitted for this permit. The sanitarian is not responsible for false or misleading information contained in the application. The sanitarian is also not responsible for concealed conditions on the property or for statements in this report that may have resulted from false or misleading statements provided to him in the application. Neither Wake County nor the sanitarian warrants that the septic tank system will continue to function satisfactorily in the future or that the water supply will remain potable.

CA

0962813

AUTHORIZATION FOR WASTEWATER SYSTEM CONSTRUCTION
VOID SIXTY(60) MONTHS FROM DATE OF ISSUANCE

DATE: <u>4/18/96</u>	IMPROVEMENT PERMIT NO.: <u>D 1360</u>	
TAX MAP NO.: _____	PARCEL NO.: _____	PIN NO.: <u>1820, 0288 6807</u>
OWNER/CONTRACTOR: <u>JB Hill Jr.</u>		
LOCATION/ADDRESS: <u>2401 Worthing Ct. (Falls of Reuse</u> <u>TL old # 98 W TR Moreham, lot on rt at</u> <u>intersection)</u>		
SUBDIVISION NAME: <u>Chartwell</u>		
LOT NO.: <u>(32)</u>	SECTION OR BLOCK NO.: _____	
AUTHORIZATION ISSUED BY: <u>DR Farnell Jr</u>		

PIN #:

AUTHORIZATION CONDITIONS

- 1 WASTEWATER SYSTEM CONSTRUCTION AND INSTALLATION MUST MEET ALL CONDITIONS AND SPECIFICATIONS AS SET FORTH IN IMPROVEMENT PERMIT NO. D 1360 AND THE ATTACHED SITE PLAN WITH SYSTEM DETAILS. CONSTRUCTION AND INSTALLATION MUST ALSO MEET ALL REQUIREMENTS SET FORTH IN THE "REGULATIONS GOVERNING SANITARY SEWAGE COLLECTION, TREATMENT, AND DISPOSAL IN WAKE COUNTY" AND ANY OTHER APPLICABLE RULES AND LAWS.
- 2 THE WASTEWATER SYSTEM SHALL NOT BE COVERED OR PLACED INTO USE UNTIL INSPECTED BY THE WAKE COUNTY DEPARTMENT OF HEALTH AND AN OPERATION PERMIT ISSUED.
- 3 ANY ALTERATION IN SITE OR SOIL CONDITIONS (INCLUDING LOCATION OF STRUCTURES AND APPURTENANCES) OR MODIFICATION IN USE, DESIGN WASTEWATER FLOW, OR WASTEWATER CHARACTERISTICS AS SPECIFIED IN THE ASSOCIATED IMPROVEMENT PERMIT AND APPLICATION, MAY VOID THIS AUTHORIZATION AND ASSOCIATED PERMITS.
- 4 OTHER CONDITIONS: Conventional trenches: 2 trenches
3' wide, 225' long, 22" deep. Contractor: establish
and follow contour. Utilize 1200 gallon
septic tank - divert Cul-de-Sac water from
drainfield with Swale