

Environmental Services - Water Quality
Onsite Wastewater Scan Data Entry Form

PERMIT #: 0028968

PIN #: 1617165176

OP DATE: 0511412004

SYSTEM USE:

- ☒ House
☐ Mobile Home
☐ Business
☐ Other

SEWAGE TYPE:

- ☒ Domestic
☐ Industrial

PUMP/SIPHON?:

- ☐ Yes
☒ No

PRESSURE MANIFOLD:

- ☐ Yes
☒ No

SYSTEM TYPE:

- ☐ I
☐ II
☒ III
☐ IV
☐ V
☐ VI
☐ Other

SUB TYPE:

- ☐ A
☐ B
☐ C
☐ D
☐ E
☐ F
☒ G

NBR BEDROOMS:

- ☐ 1
☐ 2
☒ 3
☐ 4
☐ 5
☐ 6
☐ Other

MAINT. SCHEDULE:

- ☐ Yes
☒ No

CERT. OPERATOR

- ☐ Yes
☒ No

GT ST PT SIZE

- | | | | |
|-------------------------------------|-------------------------------------|-------------------------------------|------------------|
| ☐ | ☐ | ☐ | 750 |
| ☐ | ☐ | ☐ | 900 |
| ☐ | ☒ | ☐ | 1,000 |
| ☐ | ☐ | ☐ | 1,200 |
| ☐ | ☐ | ☐ | 1,500 |
| ☐ | ☐ | ☐ | 1,800 |
| ☐ | ☐ | ☐ | 2,100 |
| ☐ | ☐ | ☐ | 2,500 |
| ☐ | ☐ | ☐ | 3,000 |
| ☐ | ☐ | ☐ | 4,000 |
| ☐ | ☐ | ☐ | 5,000 |
| ☐ | ☐ | ☐ | 8,000 |
| ☐ | ☐ | ☐ | 10,000 |
| ☒ | ☐ | ☒ | Other |
| | | | None/NA GT or PT |

DRAINFIELD SIZE(SQ. FT.)

00900

DRAIN TYPE:

- ☐ Stone
☒ EZ Flow
☐ Infiltrator
☐ Biodiffuser
☐ Cultec
☐ Drip
☐ Hancor
☐ Large Dia. Pipe
☐ Multi-Pipe
☐ Other

MAX DEPTH (IN.):

- ☐ 12 in. or less
☐ 18 in. or less
☒ 24 in. or less
☐ 26 in. or less
☐ 28 in. or less
☐ 30 in. or less
☐ 32 in. or less
☐ 36 in. or less
☐ Other

STONE DEPTH (IN.):

- ☐ 8 in. or less
☒ 12 in. or less
☐ 18 in. or less
☐ 24 in. or less
☐ Other

TRENCHES:

- ☒ Individual
☐ Bed

TRENCH WIDTH (IN.):

- ☐ 12 in. or less
☐ 18 in.
☐ 24 in.
☒ 36 in.
☐ 6 ft. or less
☐ 9 ft. or less
☐ Other

BW 4/30/14

WAKE COUNTY DEPARTMENT OF ENVIRONMENTAL SERVICES WELL AND SEWAGE SITE LOCATION PERMIT
NO PERMIT(S) FOR CONSTRUCTION, LOCATION OR RELOCATION ACTIVITY SHALL BE ISSUED
UNTIL AN AUTHORIZATION FOR WASTEWATER SYSTEM CONSTRUCTION HAS BEEN ISSUED

PERMIT VOID IF NOT IN COMPLIANCE WITH ZONING REGULATIONS AND/ OR IF SITE IS ALTERED OR INTENDED USE CHANGED

PERMIT#: D028968 STATUS: A APP. DATE: 12/10/2003 BLDG. PERMIT#: 0041655
PIN: 1617.01 16 5176 000 TAX MAP: 0827 0000 RECORDED: Y ORIG. PERMIT#:
TOWNSHIP: 15 PANTHER BRANCH JURISDICTION: WC ZONING: R30
APPLICANT: SCOTT LEE HOMES INC
106 S. LOMBARD ST
CLAYTON, NC 27520
(919) 553 - 2085
USE: HD USE: 101 ONE-FAMILY HOUSE
EXIST USE:
DISPOSAL: BEDROOMS: 3 BASEMENT: N #EMPLOYEES: 0
SITE: ADDRESS: 1024 SANDEL LA
SUBDIVISION: JEFFERSON HILL LOT: 20 ACRES: 0.64
DIRECTION: 401S, TL OLD STAGE RD, TL TEN TEN, TR JORDAN RD
SUBD. ON RT

Well System: WATER: COMMUNITY TYPE: EXISTING

WELL LOG INFORMATION: DEPTH: _____ CASING DEPTH: _____ YIELD: _____ STATIC LEVEL: _____
WELL CONTRACTOR: _____ REG.# _____ PUMP CONTRACTOR: _____ REG.# _____
Construction Compliance GROUT APPROVED ☐ DATE _____ EHS _____
WELLHEAD APPROVED ☐ DATE _____ EHS _____
SYSTEM FINALIZED ☐ DATE _____ EHS _____

COMMENTS:

Operation Permit

DESIGN FLOW: _____ gal./min. ACTUAL FLOW: _____ INNOVATIVE LETTER: _____

INSTALLED BY: Randy Batten INSTALLATION APPROVED BY: Scott Lee
PROPRIETARY SYSTEM: _____ FILTER NO: _____

COMMENTS:

OPERATIONS PERMIT ISSUED? ☒ OP DATE: 5/14/04 BY: Scott Lee

This permit is based in part on information provided by the homeowner or his/her representative in the application submitted for this permit. The Environmental Health Specialist is not responsible for false or misleading information contained in the application. The Environmental Health Specialist is also not responsible for concealed conditions on the property or for statements in this report that may have resulted from false or misleading statements provided to him in the application. Neither Wake County nor the Environmental Health Specialist warrants that the septic tank system will continue to function satisfactorily in the future or that the water supply will remain potable.

As Built Information:

Date: 5/14/04 Benchmark: S.T. Rizer Rod reading: 2'2" Distance to Structure: _____
ST: 1000 gals ID#: MC-P-814 D.O.M.: 3-23-04 Elev.: 3'2" Distance to Well: _____
PT: _____ gals ID#: _____ D.O.M.: _____ Elev.: _____
D-box/FD/PM elev.: 3'10 1/2" Supply Line: _____ ft. Pump/Control Panel: _____
Line 1: 5'3 1/4" _____ Date: _____
Line 2: 6'0" _____ Date: _____
Line 3: 6'7" _____ Date: _____
Line 4: _____ Date: _____
Line 5: _____ Date: _____
Distance to P/L: _____ Notes: _____

WAKE COUNTY DEPARTMENT OF ENVIRONMENTAL SERVICES WELL AND SEWAGE SITE LOCATION PERMIT

NO PERMIT(S) FOR CONSTRUCTION, LOCATION OR RELOCATION ACTIVITY SHALL BE ISSUED

UNTIL AN AUTHORIZATION FOR WASTEWATER SYSTEM CONSTRUCTION HAS BEEN ISSUED

PERMIT VOID IF NOT IN COMPLIANCE WITH ZONING REGULATIONS AND/ OR IF SITE IS ALTERED OR INTENDED USE CHANGED

PERMIT#: D028968 STATUS: A APP. DATE: 12/10/2003 BLDG. PERMIT#: 0041655
PIN: 1617.01 16 5176 000 TAX MAP: 0827 0000 RECORDED: Y ORIG. PERMIT#:
TOWNSHIP: 15 PANTHER BRANCH JURISDICTION: WC ZONING: R30
APPLICANT: SCOTT LEE HOMES INC
106 S. LOMBARD ST
CLAYTON, NC 27520
(919) 553 - 2085
USE: HD USE: 101 ONE-FAMILY HOUSE
EXIST USE:
DISPOSAL: BEDROOMS: 3 BASEMENT: N #EMPLOYEES: 0 FOUND DRAIN:
SITE: ADDRESS: 1024 SANDEL LA
SUBDIVISION: JEFFERSON HILL LOT: 20 ACRES: 0.64
DIRECTION: 401S, TL OLD STAGE RD, TL TEN TEN, TR JORDAN RD
SUBD. ON RT

IMPROVEMENT PERMIT

TANK SIZE: 1000 gal. PUMP Tank: _____ gal. SQ FT: 900 INNOVATIVE MAX DEPTH LINE: 20 in.
WASTEWATER: INDIVIDUAL SEWAGE: DOMESTIC TYPE SYSTEM: III G PUMP: N P/M: N
DAILY FLOW: 360 gal/day DESIGN FEE REQ?: PAID?: WATER: COMMUNITY

COMMENTS:

IP ISSUED? Y DATE: 01/15/2004 BY: (KGR)  PHONE#: 856-7341


AUTHORIZATION FOR WASTEWATER/WATER SYSTEM CONSTRUCTION

VOID SIXTY (60) MONTHS FROM DATE OF ISSUANCE

AUTHORIZATION CONDITIONS:

Contractors shall install system on contours, see attached site plan for wastewater system design and well location. No underground utilities, water lines or sprinkler systems may be located in the original system or repair areas. A septic tank filter with a riser for access is required. The wastewater system shall not be covered or placed into use until inspected by the Wake County Department of Environmental Services and an Operation Permit issued. **OTHER CONDITIONS:**
INSTALLER TO FOLLOW FLAGS IN FIELD AND CONTOUR. 3 X 100' X 3' INNOVATIVE AT 20" MAXIMUM TRENCH DEPTH. USE 1000 GALLON SEPTIC TANK. KEEP REPAIR FLAGS UP FOR CONSTRUCTION INSPECTION. REPAIR IS III G. PLEASE CALL PRIOR TO INSTALLATION WITH ANY CHANGES, PROBLEMS, OR QUESTIONS. 25% REDUCTION ALREADY TAKEN.

TANK SIZE: 1000 gal. PUMP TANK: _____ gal. SQ FT: 900 INNOVATIVE MAX DEPTH LINE: 20 in.
MAINT: N OPER: N L/O: P TRENCH#: 3 LENGTH: 100 ft. WIDTH: 36 in. DESIGNER: _____
SUBFIELDS: _____ DESIGN HEAD PRESSURE: _____ DESIGN FLOW: _____ gal/min DOSE VOLUME: _____ gal.

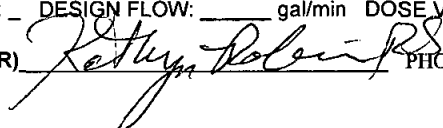
CA ISSUED? Y DATE: 01/15/2004 BY: (KGR)  PHONE#: 856-7341

revised Attn: Kathryn Robinson

As Built

30' Perimeter


103.32'

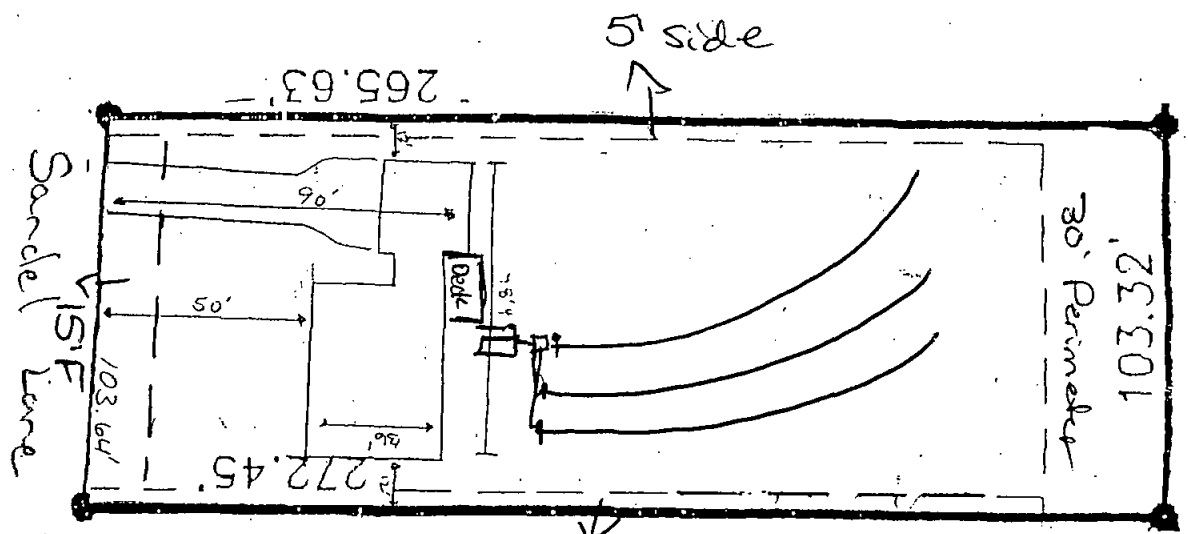

265.63'

House 1661
Driveway 1026
Walk 100

Total 2787
20 + 27795
9.97%

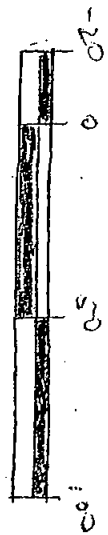

50 - Scale

0041655
D88968

Pin# 161701165176

I certify that the location of planned or existing structure(s) are accurately shown. I understand failure to locate structures in accordance with this plot plan may require the relocation of structure(s) regardless degree of completion. I hereby grant permission to Municipal/County Representatives the right of entry to make evaluations or inspections upon this property.

Signature of Owner or Authorized Agent

Zoning	R30	By	CHL
Approve	✓	Date	1-12-04
Revise	✓	Use	101
Reject		MBL	
Front	15	Rear	30
Side	5	Other	

Comments

Scott Lee Hones

Lot# 20


Jefferson Hill

revised 4th, Kathryn Johnson

CASite Plan

3X100'X3'
20" max depth
1000 gallon ST
Innovative drainlines
Repair III GS

House 1661
Drive 1026
Walk 100
Total 2787
20 + 27795
9.97%

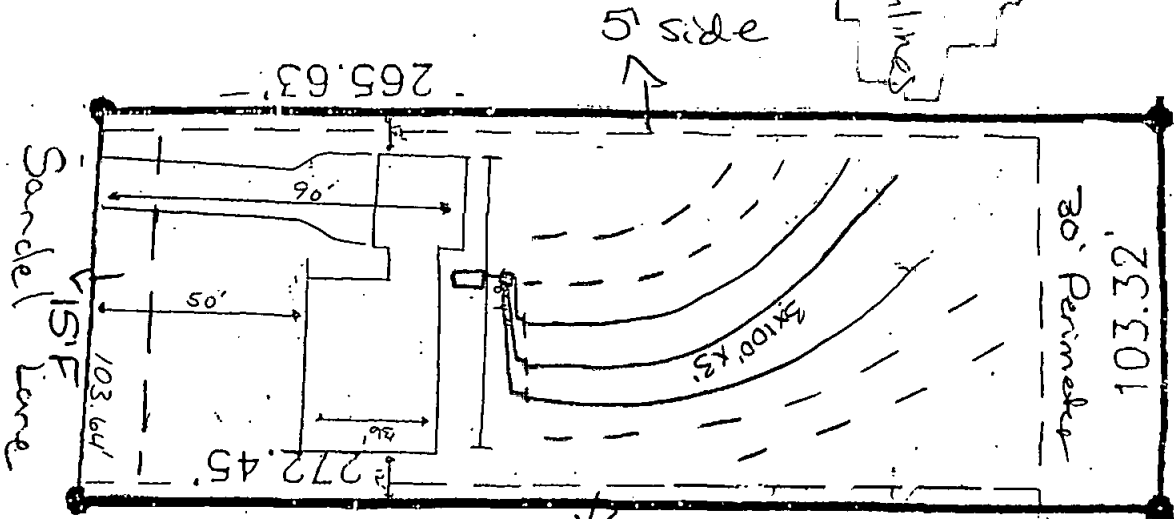

Pin# 161701165176


I certify that the location of planned or existing structure(s) are accurately shown. I understand failure to locate structures in accordance with this plot plan may require the relocation of structure(s) regardless degree of completion. I hereby grant permission to Municipal/County Representatives the right of entry to make evaluations or inspections upon this property.

Signature of Owner or Authorized Agent

Zoning	R30	By	CHL
Approve	✓	Date	1-12-04
Revise	✓	Use	101
Reject		MBL	
Front	15	Rear	30
Side	5	Corner	

Comments:

50 - Scale

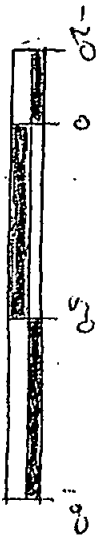

0041655
ID88968

Scott Lee Hones
Lot# 20
Safferson Hill