

# **WAKE COUNTY DEPARTMENT OF ENVIRONMENTAL SERVICES WASTEWATER PERMIT**

NO PERMIT(S) FOR CONSTRUCTION, LOCATION OR RELOCATION ACTIVITY SHALL BE ISSUED UNTIL AN AUTHORIZATION FOR WASTEWATER SYSTEM CONSTRUCTION AUTHORIZATION HAS BEEN ISSUED

**\*PERMIT VOID IF NOT IN COMPLIANCE WITH ZONING REGULATIONS AND/OR IF SITE IS ALTERED OR INTENDED USE CHANGED\***

## **OPERATIONS PERMIT**

**PERMIT #** WREP-067559-2021

**APPLICATION DATE:** 09/20/2021

**BLDG. PERMIT#:**

**PIN:** 1822921506

**RECORDED:** Yes

**TOWNSHIP:** 14 - New Light

**JURISDICTION:** Wake County

**ZONING:** R-40W

**APPLICANT:** Danny Sapphire  
1932 PLEASANT FOREST WAY

**BUSINESS PHONE:**

**HOME PHONE:**

**MOBILE PHONE:** (818) 269-5676

**HD USE:** 0001 REPAIR/EXISTING SYSTEM

**EXISTING USE:** 101A CONVENTIONAL ONE-FAMILY HOUSE

**SITE ADDRESS:** 1932 PLEASANT FOREST WAY

**SUBDIVISION:** GALLOWAY SUB PH2

**LOT:** 20

**ACRES:** 1.30

**DIRECTIONS:** TAKE US 1 NORTH TO WAKE FOREST. TAKE HWY 98 WEST. TURN LEFT ONTO KAMP KANATA RD. TURN RIGHT ONTO PLEASANT FOREST. HOUSE ON LEF.T

Systems defined as either type III-b, III-g with a pump, IV, V or VI, in accordance with the North Carolina administrative code 15A NCAC 18a .1961, table V as adopted by reference in the "Regulations Governing Wastewater Treatment Dispersal Systems in Wake County", requires Wake County Environmental Services to conduct periodic inspections of the system type pursuant to 15A NCAC 18a. 1961 (j). Fees for these inspections will be charged as per the approved Fee Schedule. In addition, all systems are to be operated and maintained as specified in 15A NCAC 18A .1961. This permit is based in part on information provided by the homeowner and/or his/her representative in the application submitted for this permit. The Environmental Health Specialist is not responsible for false or misleading information contained in the application. The environmental health specialist is also not responsible for concealed conditions on the property or for statements in this report that may have resulted from false or misleading statements provided to him/her in the application. Neither Wake County nor the Environmental Health Specialist warrants that the septic tank system will continue to function satisfactorily in the future or that the water supply will remain potable.

**OPERATION PERMIT VALID FOR:** No Expiration

**INSTALLED BY:** OTHER

**PROPRIETARY SYSTEM:** EZ1203HG - EZFlow EZ 1203H Geo **PRETREATMENT SYSTEM:**

**SYSTEM TYPE INSTALLED:** III B

**OPERATION PERMIT: STATUS:** Issued

**ISSUED BY:** Tim Warren

**ISSUED DATE:** 03/07/2022

**SEPTIC TANK:**

**DATE OF MANUFACTURE:**

**FILTER:**

**GREASE TRAP:**

**DATE OF MANUFACTURE:**

**FILTER:**

**DOSING PUMP TANK:** Brantley - PT-463 - 1200

**DATE OF MANUFACTURE:**

**FILTER:**

gal - 20.45 gal/in

**CC1:**

**ETM1:**

**CC2:**

**ETM2:**

**RECIRCULATION TANK:**

**DATE OF MANUFACTURE:**

**CC1:**

**ETM1:**

**CC2:**

**ETM2:**

**SEPTIC TANK ELEVATION:**

**GREASE TRAP ELEVATION:**

**DOSING PUMP TANK ELEVATION:**

RECIRCULATION TANK ELEVATION:

DISTRIBUTION DEVICE ELEVATION: 1

| INSTALLED TRENCH DEPTH | INSTALLED AGGREGATE DEPTH | INSTALLED TRENCH LENGTH | INSTALLED TRENCH<br>BOTTOM ELEVATION |
|------------------------|---------------------------|-------------------------|--------------------------------------|
| 24                     | 12                        | 100                     | 9.16                                 |

ACTUAL PRESSURE HEAD: 2

ACTUAL FLOW RATE: 26

ACTUAL DOSE VOLUME: 164


SPECIFIC OPERATION REQUIREMENTS:

**OPERATION PERMIT ISSUED FOR A 4 BR HOME WITH A FLOW RATE OF 480 GPD.**

ISSUED BY:



DATE: 03/07/2022

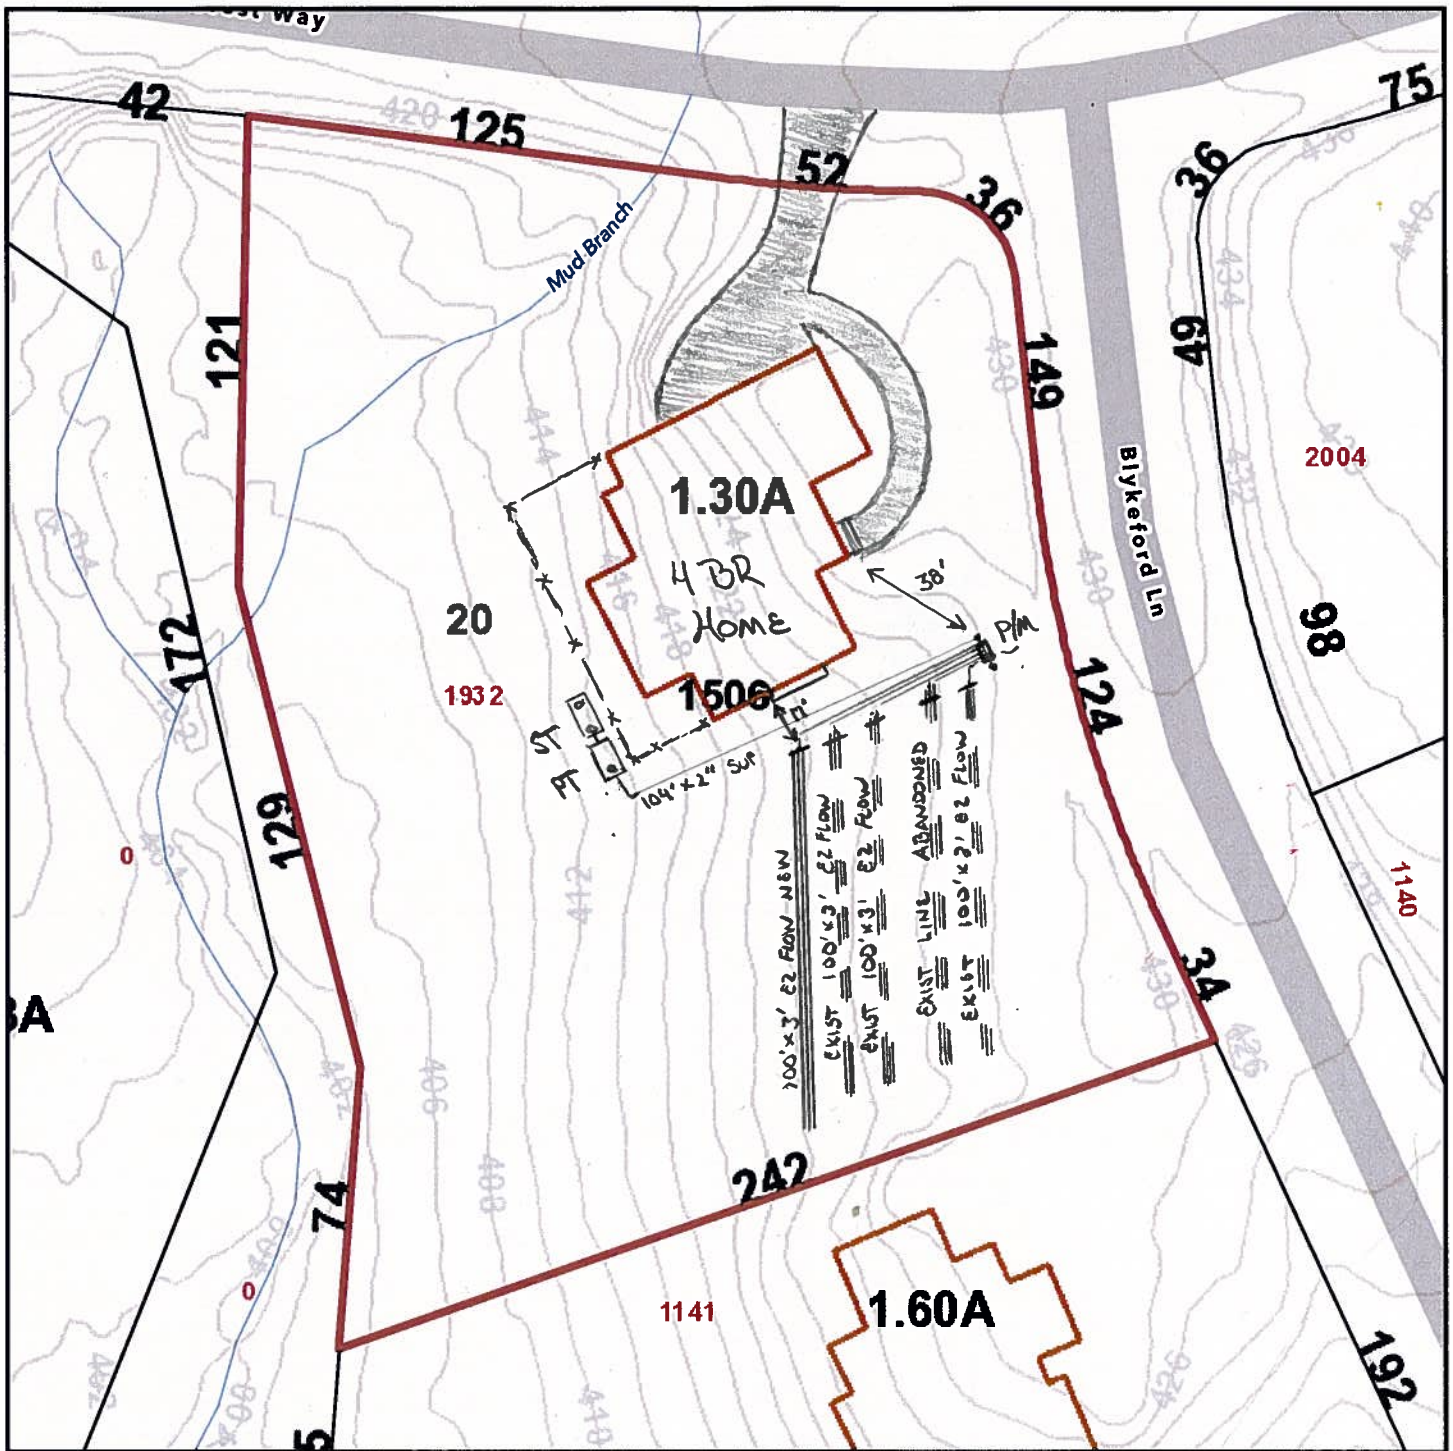

1932 PLEASANT FOREST WAY


OPERATION PERMIT

AS BUILT

REPAIR

WREP-0067559-2021

03/07/2022  
JTW

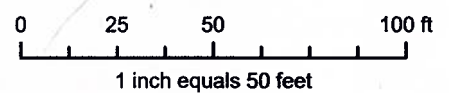

**Disclaimer**  
iMaps makes every effort to produce and publish the most current and accurate information possible. However, the maps are produced for information purposes, and are NOT surveys. No warranties, expressed or implied, are provided for the data therein, its use, or its interpretation.