

*25% Reduction Accepted System.

PERMIT NUMBER

07430

GRANVILLE-VANCE DISTRICT HEALTH DEPARTMENT
IMPROVEMENT AND OPERATION PERMITS

COUNTY:	TAX NO.	TYPE OF ESTABLISHMENTS			*THIS PERMIT SHALL BE ACCOMPANIED BY A LAYOUT SHOWN ON A PLAT, INCLUDING SYSTEM REQUIREMENTS.
Vance	SR. NO.	RESIDENCE ☒ BUSINESS ☐ OTHER ☐	NUMBER OF BEDROOMS: 3	NUMBER OF OCCUPANTS: 4	
OWNER: Antonio Gutierrez		WATER SUPPLY	WELL ☒ PUBLIC ☐	OTHER ☐	
APPLICANT'S ADDRESS:		TYPE OF WASTEWATER SYSTEM	INITIAL Type II INSTALLATION Accepted	REPAIR Same	
PROPERTY ADDRESS/LOCATION: Hoyle Ln. (off Vicksboro)		DESIGN FLOW:	360 g/day		*THIS IMPROVEMENT PERMIT IS SUBJECT TO REVOCATION IF THE INTENDED USES CHANGE FROM THOSE SHOWN ON THE IMPROVEMENT PERMIT. CHANGES SHALL REQUIRE HEALTH DEPARTMENT APPROVAL.
SUBDIVISION:		LTAR:	.3		
LOT NUMBER:		ABSORPTION AREA:	900 ft ²		
		TRENCH WIDTH:	3'		
REFERENCE SKETCH (SEE PLAT FOR DETAILS)		TRENCH DEPTH:	24"		PERMIT VALID FOR: 5 YEARS ☒ YES ☐ NO
* See attached site plan. -soil reevaluated some can install at 36" cuts 4/2/14		TRENCH SPACING:	9' centers		
		TOTAL TRENCH LENGTH:	300'		
		NUMBER OF TRENCHES:	3		
		GRAVEL DEPTH:	NA		NO EXPIRATION YES ☐ NO ☒
		TANK SIZE:	1,000g		
		PUMP TANK SIZE:	NA		
		DISTRIBUTION DEVICE:	D-box		

IMPROVEMENT PERMIT

DATE:

FOR:

ISSUED BY:

Mac Shugliter, REHS 9-7-12

CONSTRUCTION AUTHORIZATION FOR IMPROVEMENT PERMIT# 07430

Unless otherwise indicated, the same conditions above apply regarding system type, layout, location and installation requirements.
(The wastewater system cannot be installed until authorization is signed)

Comments:

Date:

9-7-12

Environmental Health Specialist:

Mac Shugliter, REHS

Construction Authorization Addendum

☐ Yes ☒ No

OPERATION PERMIT


DATE: 4/3/14

SYSTEM INSTALLED BY:

ISSUED BY:

KJP Moore
Chris Hill

PERFORMANCE, MONITORING, MAINTENANCE AND OPERATION
AS REQUIRED BY RULE .1961

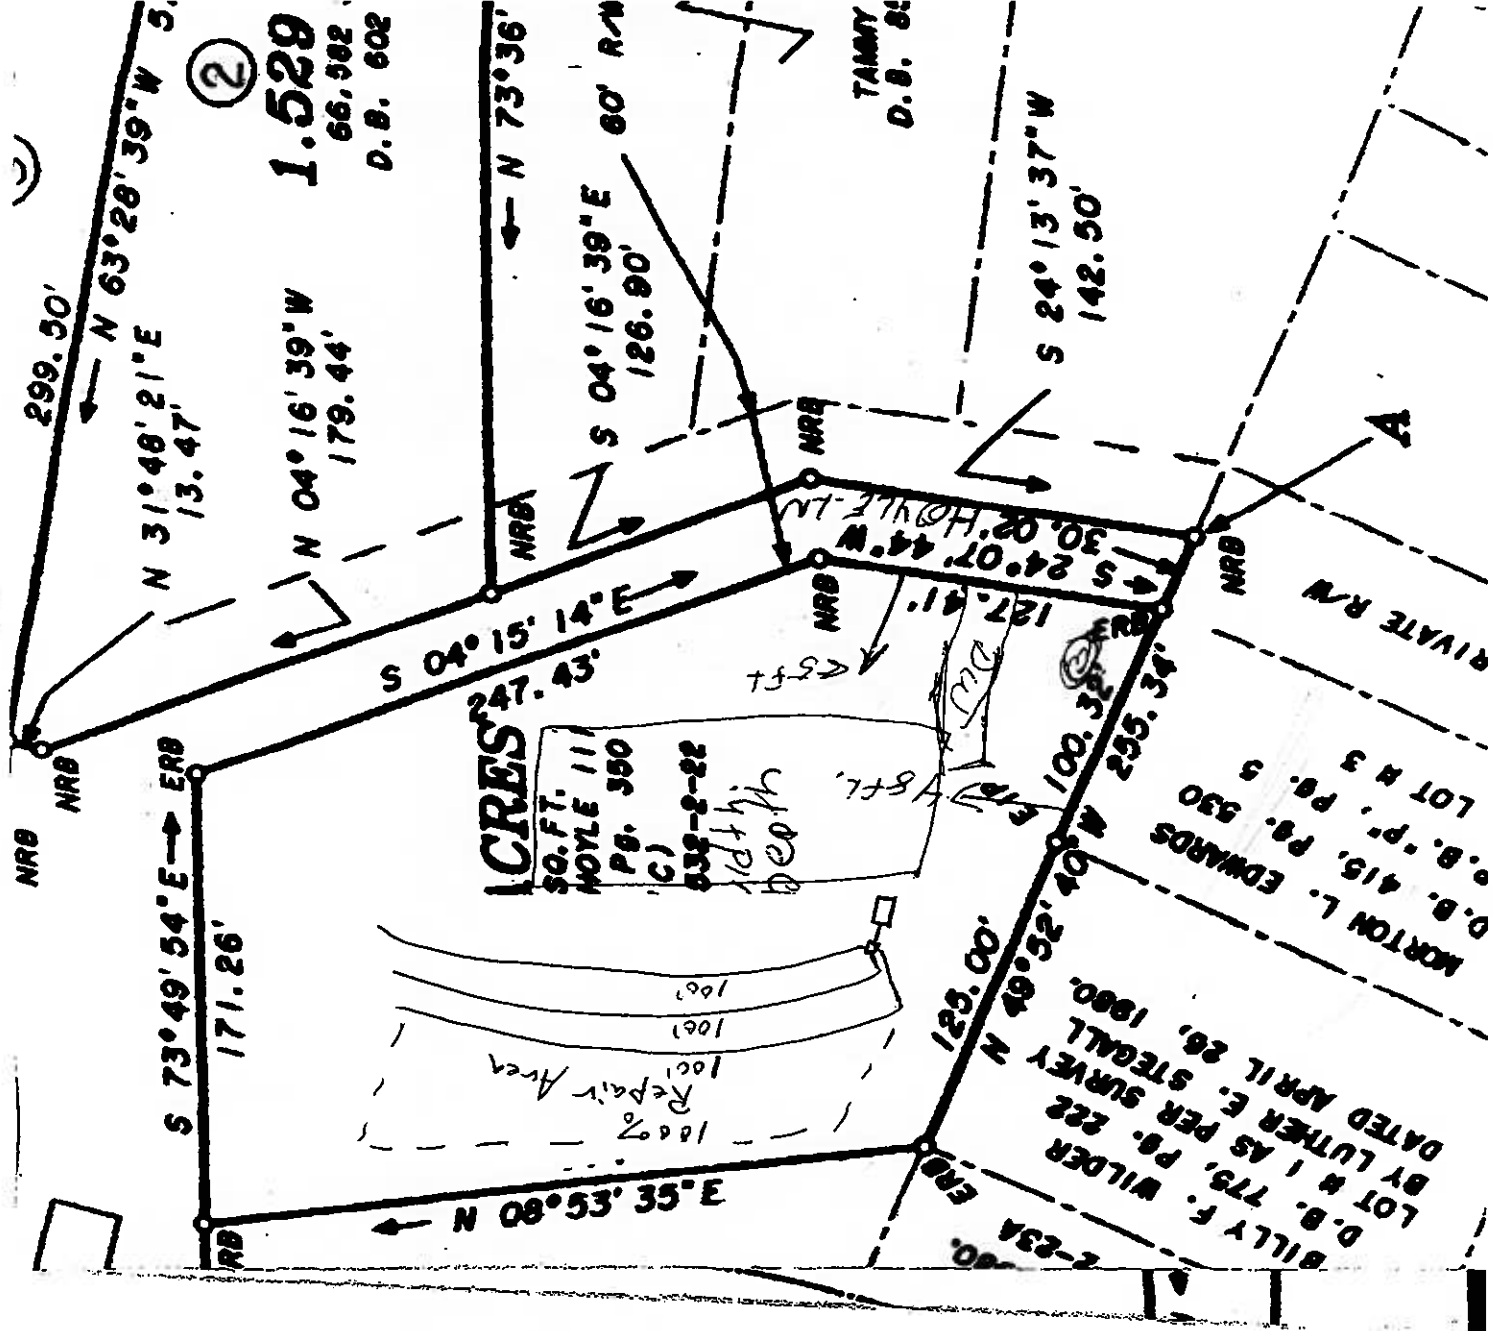



RESIDENTIAL WELL CONSTRUCTION RECORD

North Carolina Department of Environment and Natural Resources - Division of Water Quality

WELL CONTRACTOR CERTIFICATION # 7385

1. WELL CONTRACTOR:

William Glenn Davis

Well Contractor (Individual) Name

Davis Well Drilling

Well Contractor Company Name

STREET ADDRESS

702 West Green St

Franklinton NC 27525

City or Town

State

Zip Code

919-494-2440

Area code - Phone number

2. WELL INFORMATION:

SITE WELL ID # (if applicable)

STATE WELL PERMIT # (if applicable)

DWQ or OTHER PERMIT # (if applicable)

WELL USE (Check Applicable Box): Residential Water Supply ☒

DATE DRILLED 03-25-2015

TIME COMPLETED 2:30 AM ☐ PM ☒

3. WELL LOCATION:

CITY:

Henderson

COUNTY:

Vance

67 Hoyle Lane

(Street Name, Numbers, Community, Subdivision, Lot No., Parcel, Zip Code)

TOPOGRAPHIC / LAND SETTING:

☒ Slope ☐ Valley ☐ Flat ☐ Ridge ☐ Other

(check appropriate box)

LATITUDE 36° 19.051

LONGITUDE 78° 22.048

May be in degrees, minutes, seconds or in a decimal format

Latitude/longitude source: ☒ GPS ☐ Topographic map

(location of well must be shown on a USGS topo map and attached to this form if not using GPS)

4. WELL OWNER

OWNER'S NAME

Antonio Gutierrez

STREET ADDRESS

67 Hoyle Ln.

Henderson NC

City or Town

State

Zip Code

919-767-9886

Area code - Phone number

5. WELL DETAILS:

a. TOTAL DEPTH:

245'

b. DOES WELL REPLACE EXISTING WELL? YES ☐ NO ☒

c. WATER LEVEL Below Top of Casing: 22 FT
(Use "+" if Above Top of Casing)

d. TOP OF CASING IS 1 FT. Above Land Surface
*Top of casing terminated at or below land surface may require a variance in accordance with 15A NCAC 2C .0112

e. YIELD (gpm): 25 METHOD OF TEST air

1. DISINFECTION: Type HTH Amount Wppm

g. WATER ZONES (depth)

From 160 To 162 From: To:

From 221 To 223 From: To:

From: To: From: To:

6. CASING:

Thickness:

From 0 To 80 Ft. 648 DR1 PVC

From: To: Ft. Material:

From: To: Ft. Material:

7. GROUT:

Depth:

From Top To 20 Ft. Expanded polyurethane

From: To: Ft. Material:

From: To: Ft. Material:

8. SCREEN:

Depth:

Diameter:

Slot Size:

Material:

From: To: Ft. in in in

From: To: Ft. in in in

From: To: Ft. in in in

9. SAND/GRAVEL PACK:

Depth:

Size:

Material:

From: To: Ft. in in in

From: To: Ft. in in in

From: To: Ft. in in in

10. DRILLING LOG

From To

Formation Description

0-80 soil/sand

80-245 igneous granite

245-245

245-245

Submit the original to the Division of Water Quality within 30 days. Admin. Information Mgt.
1617 Mail Service Center - Raleigh, NC 27699-1617 Phone No. (919) 733-7011 ext 568

Form DW-1a
Rev. 7/05