


NOTE: Make sketch of installation showing location of house, septic tanks, privies, water supplies on adjacent property, etc. Write in measurements in order that installations may be located at later date.

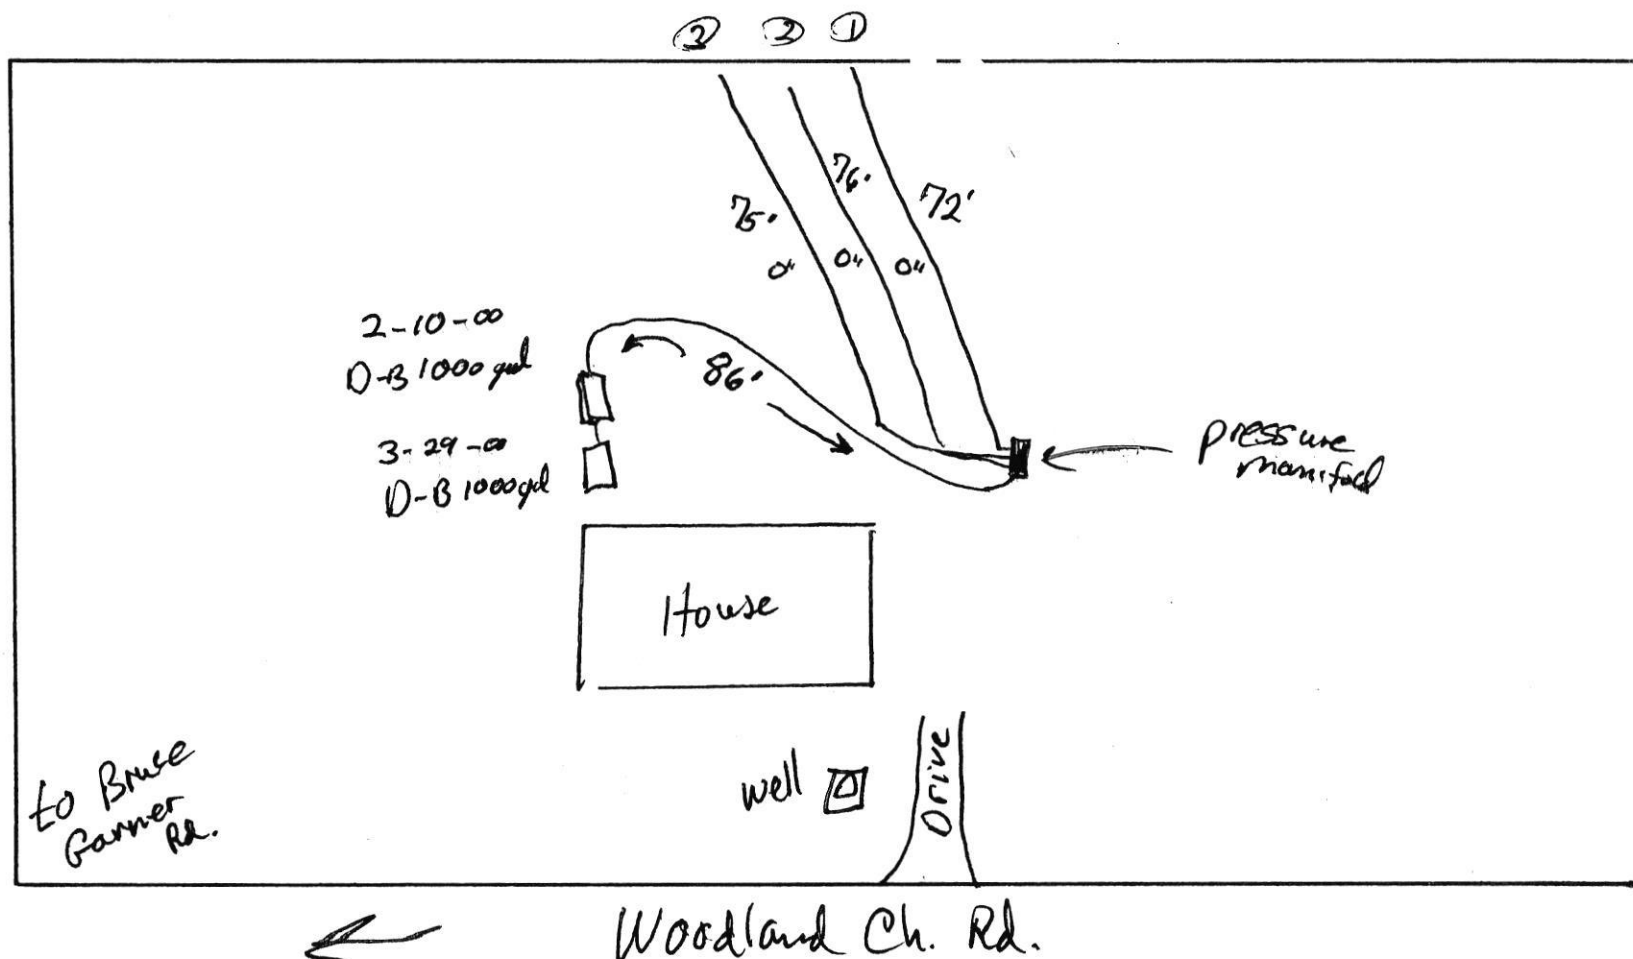

GRANVILLE-VANCE HEALTH DEPARTMENT—Sewage Disposal Record

Owner or Contractor J. D. Goldston Date 9-24-99 S.R. No. 1714

Location/Address Woodland Ch. Rd.

Subdivision/Mobile Home Park Name New Forest Lot Size .924 AC

Permit No. # 2146 Lot No. 1

New System ☒ Repair ☐

House ☒ Mobile Home ☐ Business ☐

Bedrooms 3 No. People No. Toilets

Water Supply: Private ☒ Approved ☐

Semi-Public ☐ Unapproved ☐

Public ☐ None ☐

Nitrification System:

Tank Size 1000 gal S.T. + 1000 gal P.T.

Distribution Box pressure No. Lines 3

Nitrification Field 960 Sq. Ft.

Lines:

	1	2	3	4	5	6
Width	<u>3'</u>	<u>3'</u>	<u>3'</u>	<u> </u>	<u> </u>	<u> </u>
Length	<u>75'</u>	<u>76'</u>	<u>72'</u>	<u> </u>	<u> </u>	<u> </u>
Grade	<u>0"</u>	<u>0"</u>	<u>0"</u>	<u> </u>	<u> </u>	<u> </u>
Stone Depth	<u>12"</u>	<u>12"</u>	<u>12"</u>	<u> </u>	<u> </u>	<u> </u>

Layout to be followed by installer:

** Sketch of layout on back*

Improvements Permit By David Cumbar Installer David Brantley

Certificate of Completion By David Cumbar Date of Inspection 6-13-00

Construction must comply with all other applicable state and local regulations, but the permit is not a guarantee that the system will not malfunction and the Granville-Vance Health District will not be held responsible for a malfunctioning system.