



Granville-Vance District Health Department

Lisa M. Harrison, MPH, Health Director
Post Office Box 367
Oxford, North Carolina 27565



Granville County Health Dept.
101 Hunt Drive
Oxford, NC 27565
Phone: (919) 693-2688
Fax: 919-690-0106

Vance County Health Dept.
115 Charles Rollins Road
Henderson, NC 27536
Phone: (252) 492-7915
Fax: (252) 492-4219

Recertification of an Existing On-Site System and Well

Owner Name / Applicant Name: Julius & Angie McAdams Date: 7-2-13
Physical Address: 691 Hawthorne Pt Creedmoor Contact Number: 919-369-1691
Subdivision: Hawthorne Lot # 65 Zoning Permit # _____

Septic Permit #: 7216 Date Installed: 8-6-12

Recertification Of:

Existing House Replacement: Size: _____

Pool: _____ - Size: _____
Septic Redesign/Upgrade: _____
Permit # _____

Addition to House: _____ - Size: _____
Bedroom Addition _____ Septic Upgrade: _____
Permit # _____ New Well: _____

Outbuilding Addition: _____ - Size: _____

Other Additions to Property: _____

*Finishing upstairs room
for office*

_____ All setbacks have been met accordingly at this time.

_____ Onsite Wastewater System is functioning properly at this time.

_____ Onsite Wastewater System is functioning properly at this time, but system upgrade is required.

Permit #: _____

*** System Upgrade must be completed prior to Certification of Occupancy.

_____ Onsite Wastewater System is **NOT** functioning properly at this time.

Repair Permit #: _____

*** System repair must be completed prior to Certification of Occupancy.

_____ Recertification denied, due to: _____

_____ Cannot determine due to: _____

Special Instructions: House remains 4 bedroom

David Cullen

7/2/13

Granville - Vance District Health Department

00706

Environmental Health

Well Construction Permit

Owner/Applicant: Lawrence HomeDate: 3-16-2012Address or Location of Property: Hawthorne PlaceSubdivision & Lot #: Hawthorne #65Septic Permit #: 7216Zoning Permit #: 11370Environmental Health Specialist: David Cumber

This well permit is to locate and site the area that a private groundwater well may be established on the property listed above by the Environmental Health Specialists of Granville County. If one does not locate the well in the approved area and complete the well as specified by the 15A NCAC .02C rules, then permits may be revoked. At completion of drilling of the well, grout must be witnessed by EHS and a well log turned into Environmental Health.


Minimum Setbacks: (these are the main setbacks, but not all required setbacks)

Setback from property lines – 10 ft


Setback from septic tank and drain field, including repair area – 100 ft


Setback from structural foundations – 25 ft

Setback from ponds, lakes or other bodies of water – 50 ft

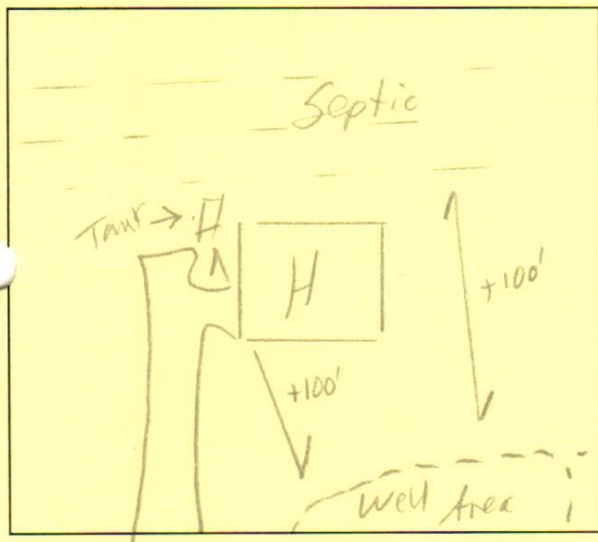Site Sketch:**Conditions:**Call 693-2688w/ questions**Authorized Agent:**David Cumber**Date:**3-16-2012**# 1 Well Grout: (Circle or write in)**Witnessed: Yes or No EHS Agent: David CumberDate: 6-27-12 Annular Space Open: Yes or NoOver reamed: Yes or No Depth Grouted: 20'Method: Pump ☒ Poured ☐ Pressure

Well Log received: Yes or No (EHS to Attach to Permit)

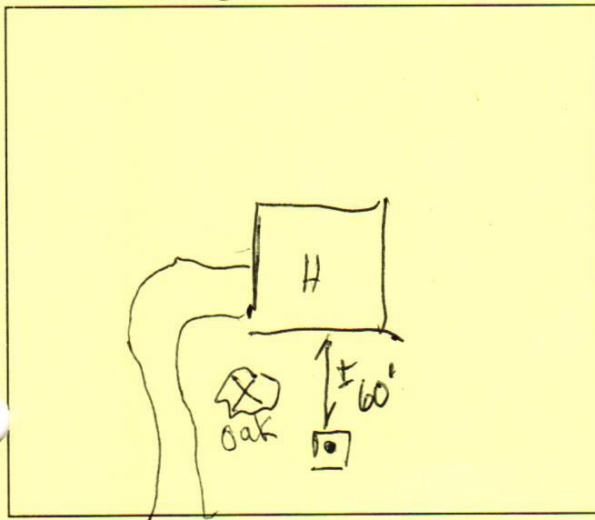Driller Name: Southern Cert. #Depth: 480' Casing Depth: 75' GPM: 5**As Built Drawing:****# 2 Well Final: (Place a check mark when finalized)**Seal Present and Intact: ☒ Air Vent: ☒Hose Spigot: ☐ Electrical Box: ☐Pump Installer Tag: ☐ Well Installer Tag: ☐All holes sealed: ☒ 12" above grade: ☐**Comments:**TanksPump depth 350'7-6-121 HP**# 3 Well Completion Permit:**David Cumber EHSDate Completed: 8-6-12**# 4 Water Samples Taken: Date:**1-15-13EHS: DCResults: OKRetest: ☐Results: ☐

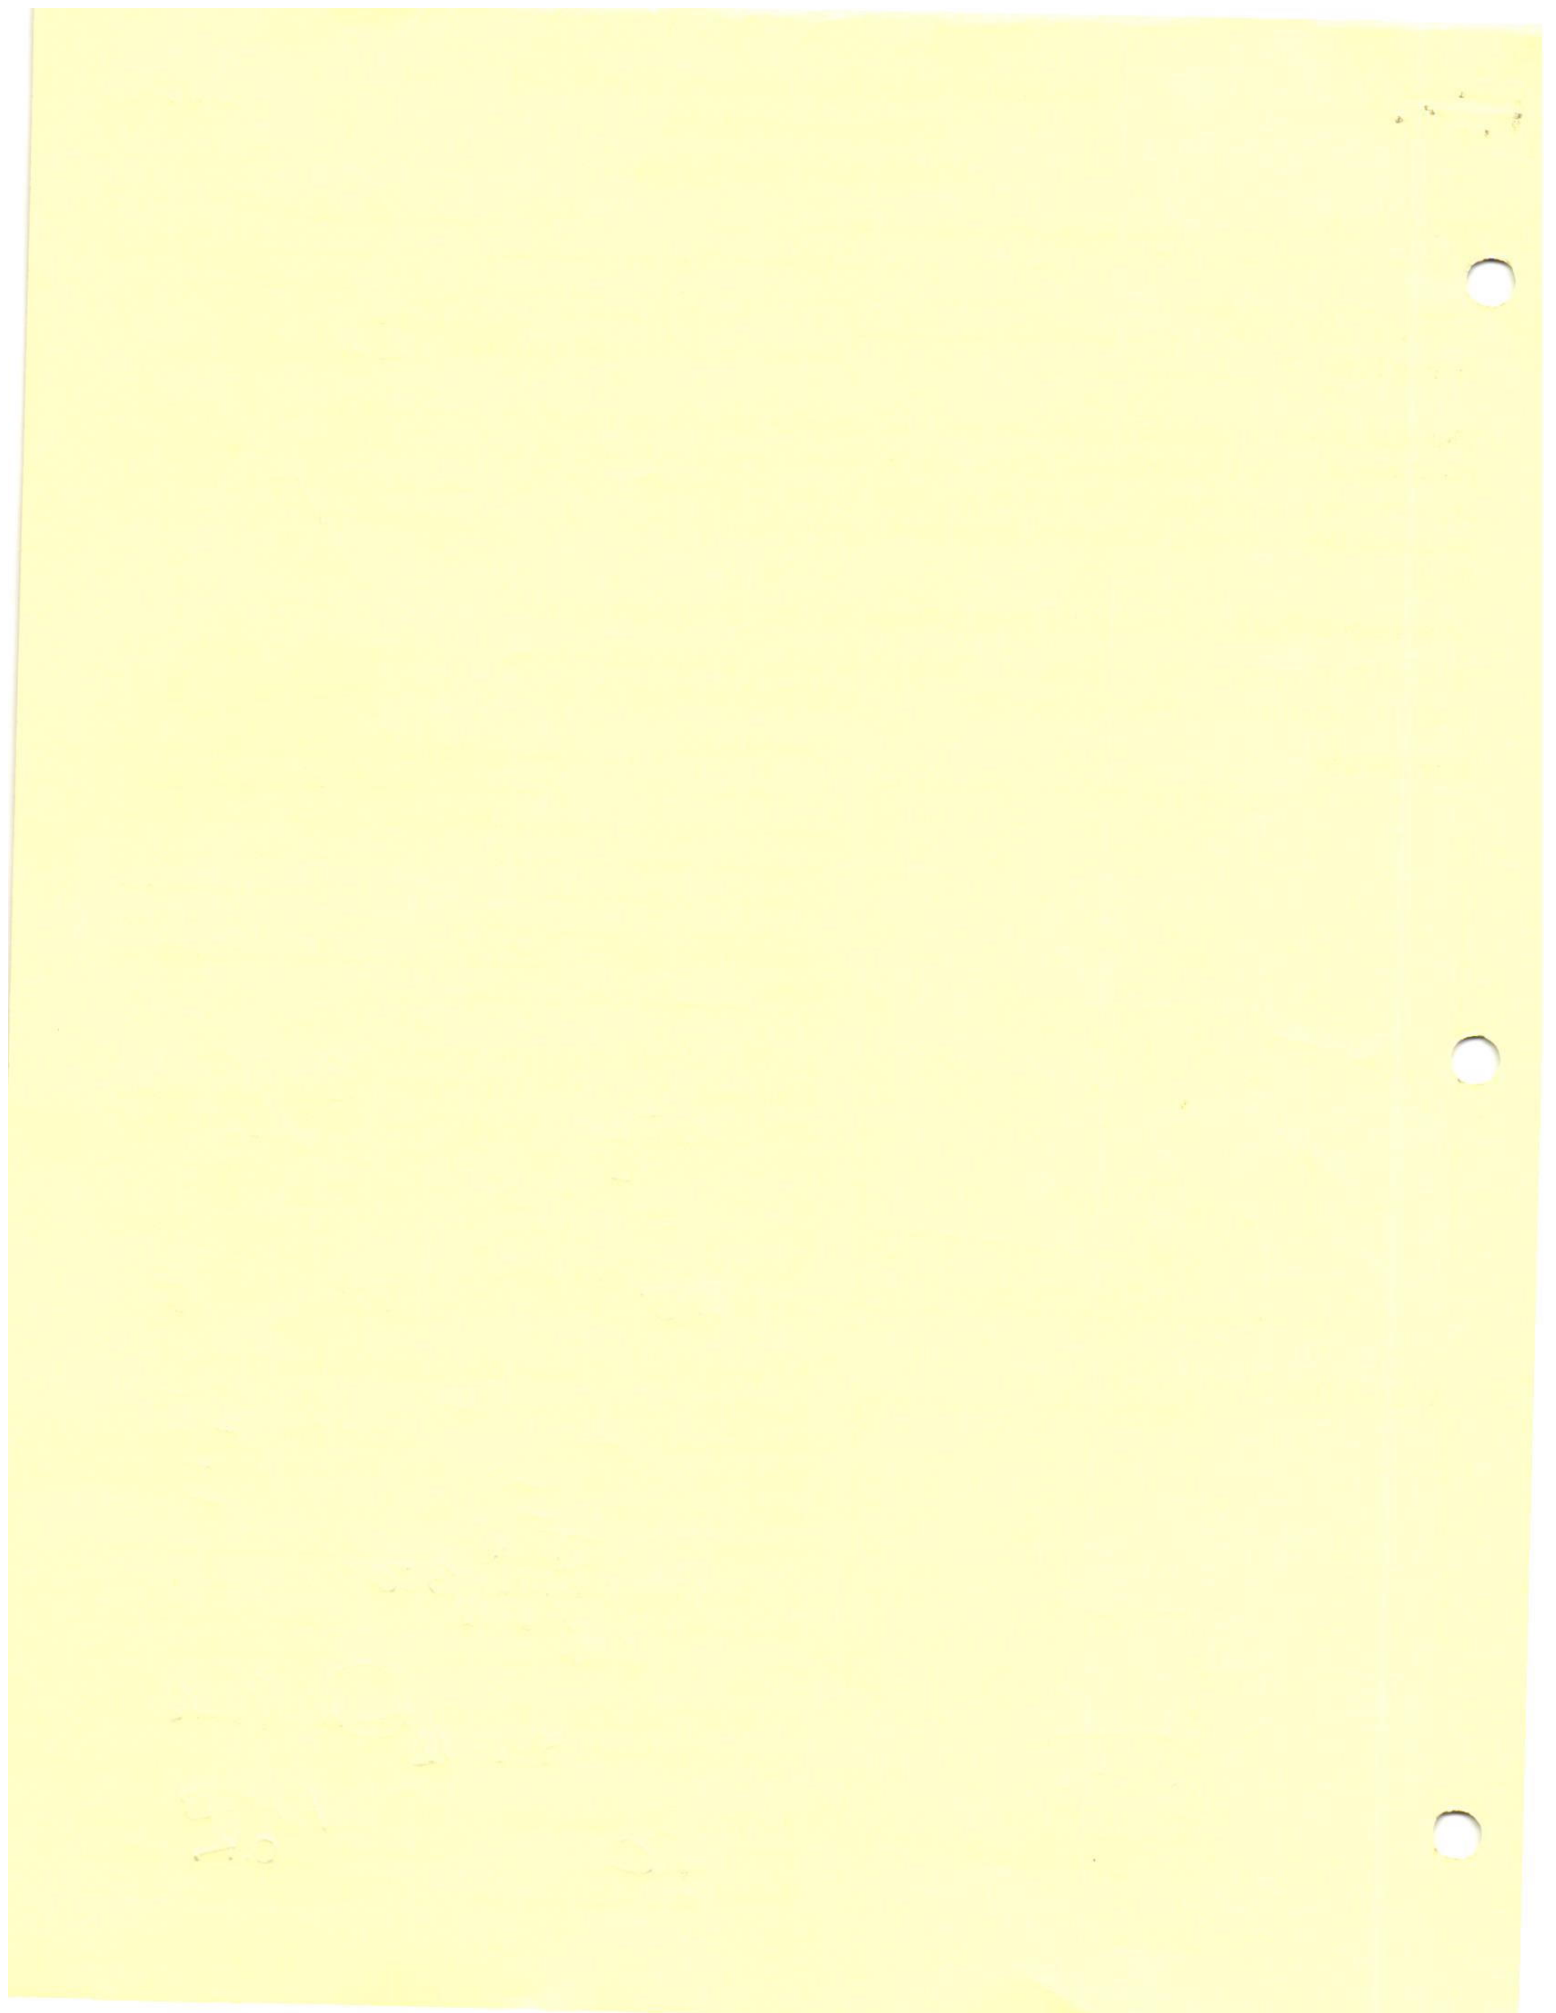

Granville – Vance District Health Department
Environmental Health

Pin 181300295738

Permit Number 7216

☒ Improvement Permit

☒ Construction Authorization

Final Sketch

Lawrence Hoopes
Applicants Name

Hawthorne 65
Subdivision – Section – Lot

Physical Address: Hawthorne Place Drive

Quality Landscaping
System Installer

8-6-2012
Date

System design and details as installed.

Septic Tank Information:

Date: 6-26-12

Manufacture: MILLS-BORG

ID #: STB-857

Pump Tank Information:

Date: _____

Manufacturer: _____

ID #: _____

Distribution Box ☒

Pressure Manifold _____


Serial Distribution _____

Pump Info: _____

Type of Facility: House

Number of Bedrooms: 4

Type of System: ☒ Gravity ☐ Pump ☐ Gravel ☒ Polystyrene ☐ Chamber ☐ Other: _____

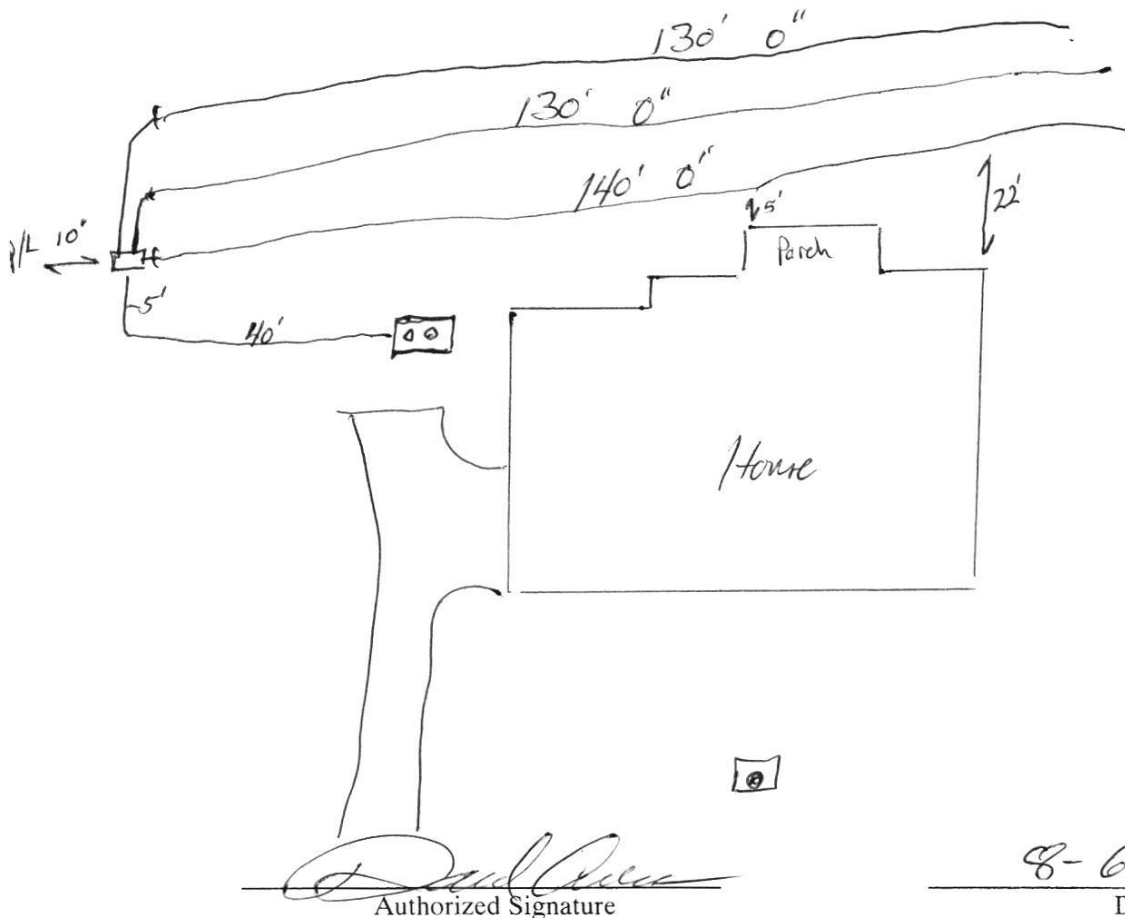

[Signature]
Authorized Signature

8-6-2012
Date

→ To Bruce Garner Rd

Transmission Report

Date/Time: 02/11/2020 09:54 AM

Fax Number : 9196030106
Company Name : GV Environmental Health

The documents were not sent.
*** Error ***

No.	Job#	Remote Station	Start Time	Dura.	Pages	Mode	Contents	Result
001	0719	99195542366	02/11/2020 09:53AM	0'00"	0/ 1			Busy

Granville - Vance District Health Department
Environmental Health

Pin 181300295738 Permit Number 7216

☒ Improvement Permit ☒ Construction Authorization

Final Sketch

Applicant's Name Lawrence Thomas Subdivision - Section - Lot Hawthorne 65

Physical Address: Hawthorne Drive

System Installer Quality Landscaping Date 8-6-2012

System design and details as installed.

Septic Tank Information: Date: <u>6-26-12</u> Manufacturer: <u>Mills-Bogal</u> ID #: <u>5713-8577</u>	Pump Tank Information: Date: _____ Manufacturer: _____ ID #: _____	Distribution Box ☒ Pressure Manifold _____ Serial Distribution _____ Pump Info: _____
--	---	--

Type of Facility: House Number of Bedrooms: 4

Type of System: ☒ Gravity ☐ Pump ☐ Gravel ☒ Polystyrene ☐ Chamber ☐ Other: _____

Authorized Signature _____ Date 8-6-2012

→ To Bruce Garner Rd

The Fax Transmit prints each time when the documents are sent or unsent. To turn off this page:

- 1.) At the printer's control panel, press "Machine Status"
- 2.) At the LCD Panel, press the "Tools" tab and then press "Admin Settings..."
- 3.) Press "Fax Settings..." and then press "Fax Reports..."
- 4.) Press "Fax Transmit" and set the setting to "Print Disable"

Page:1(Last Page)